
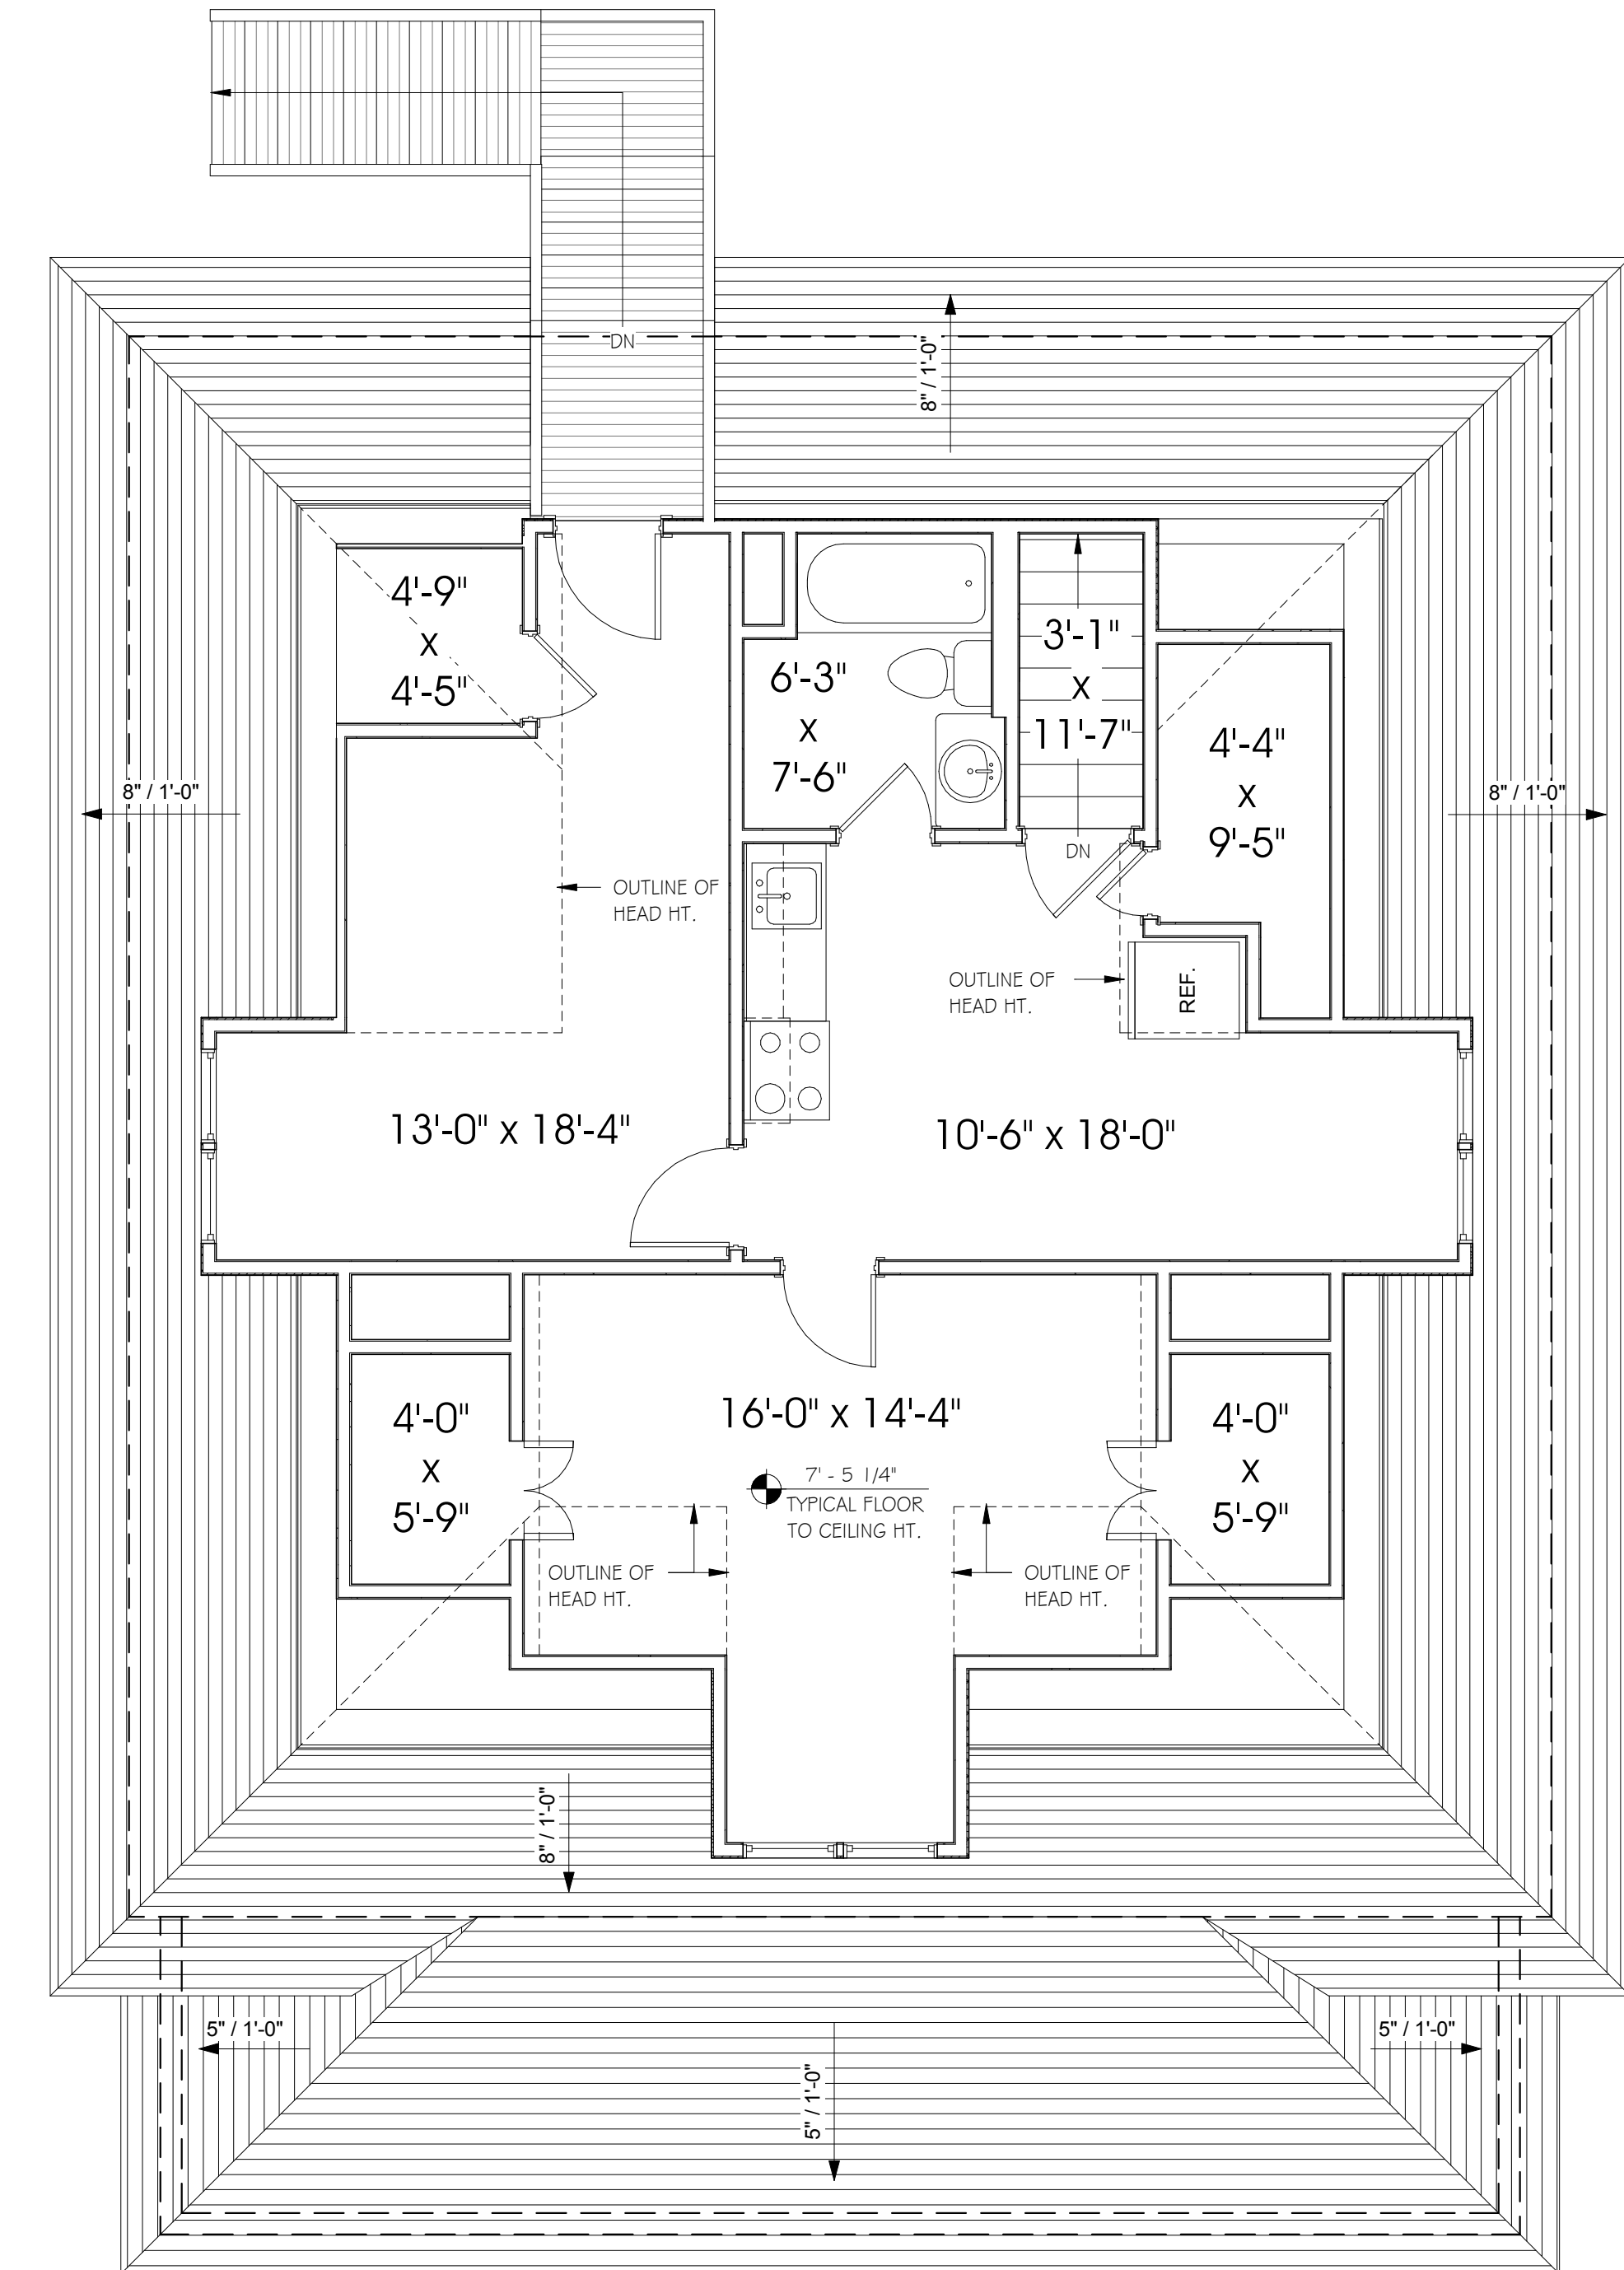
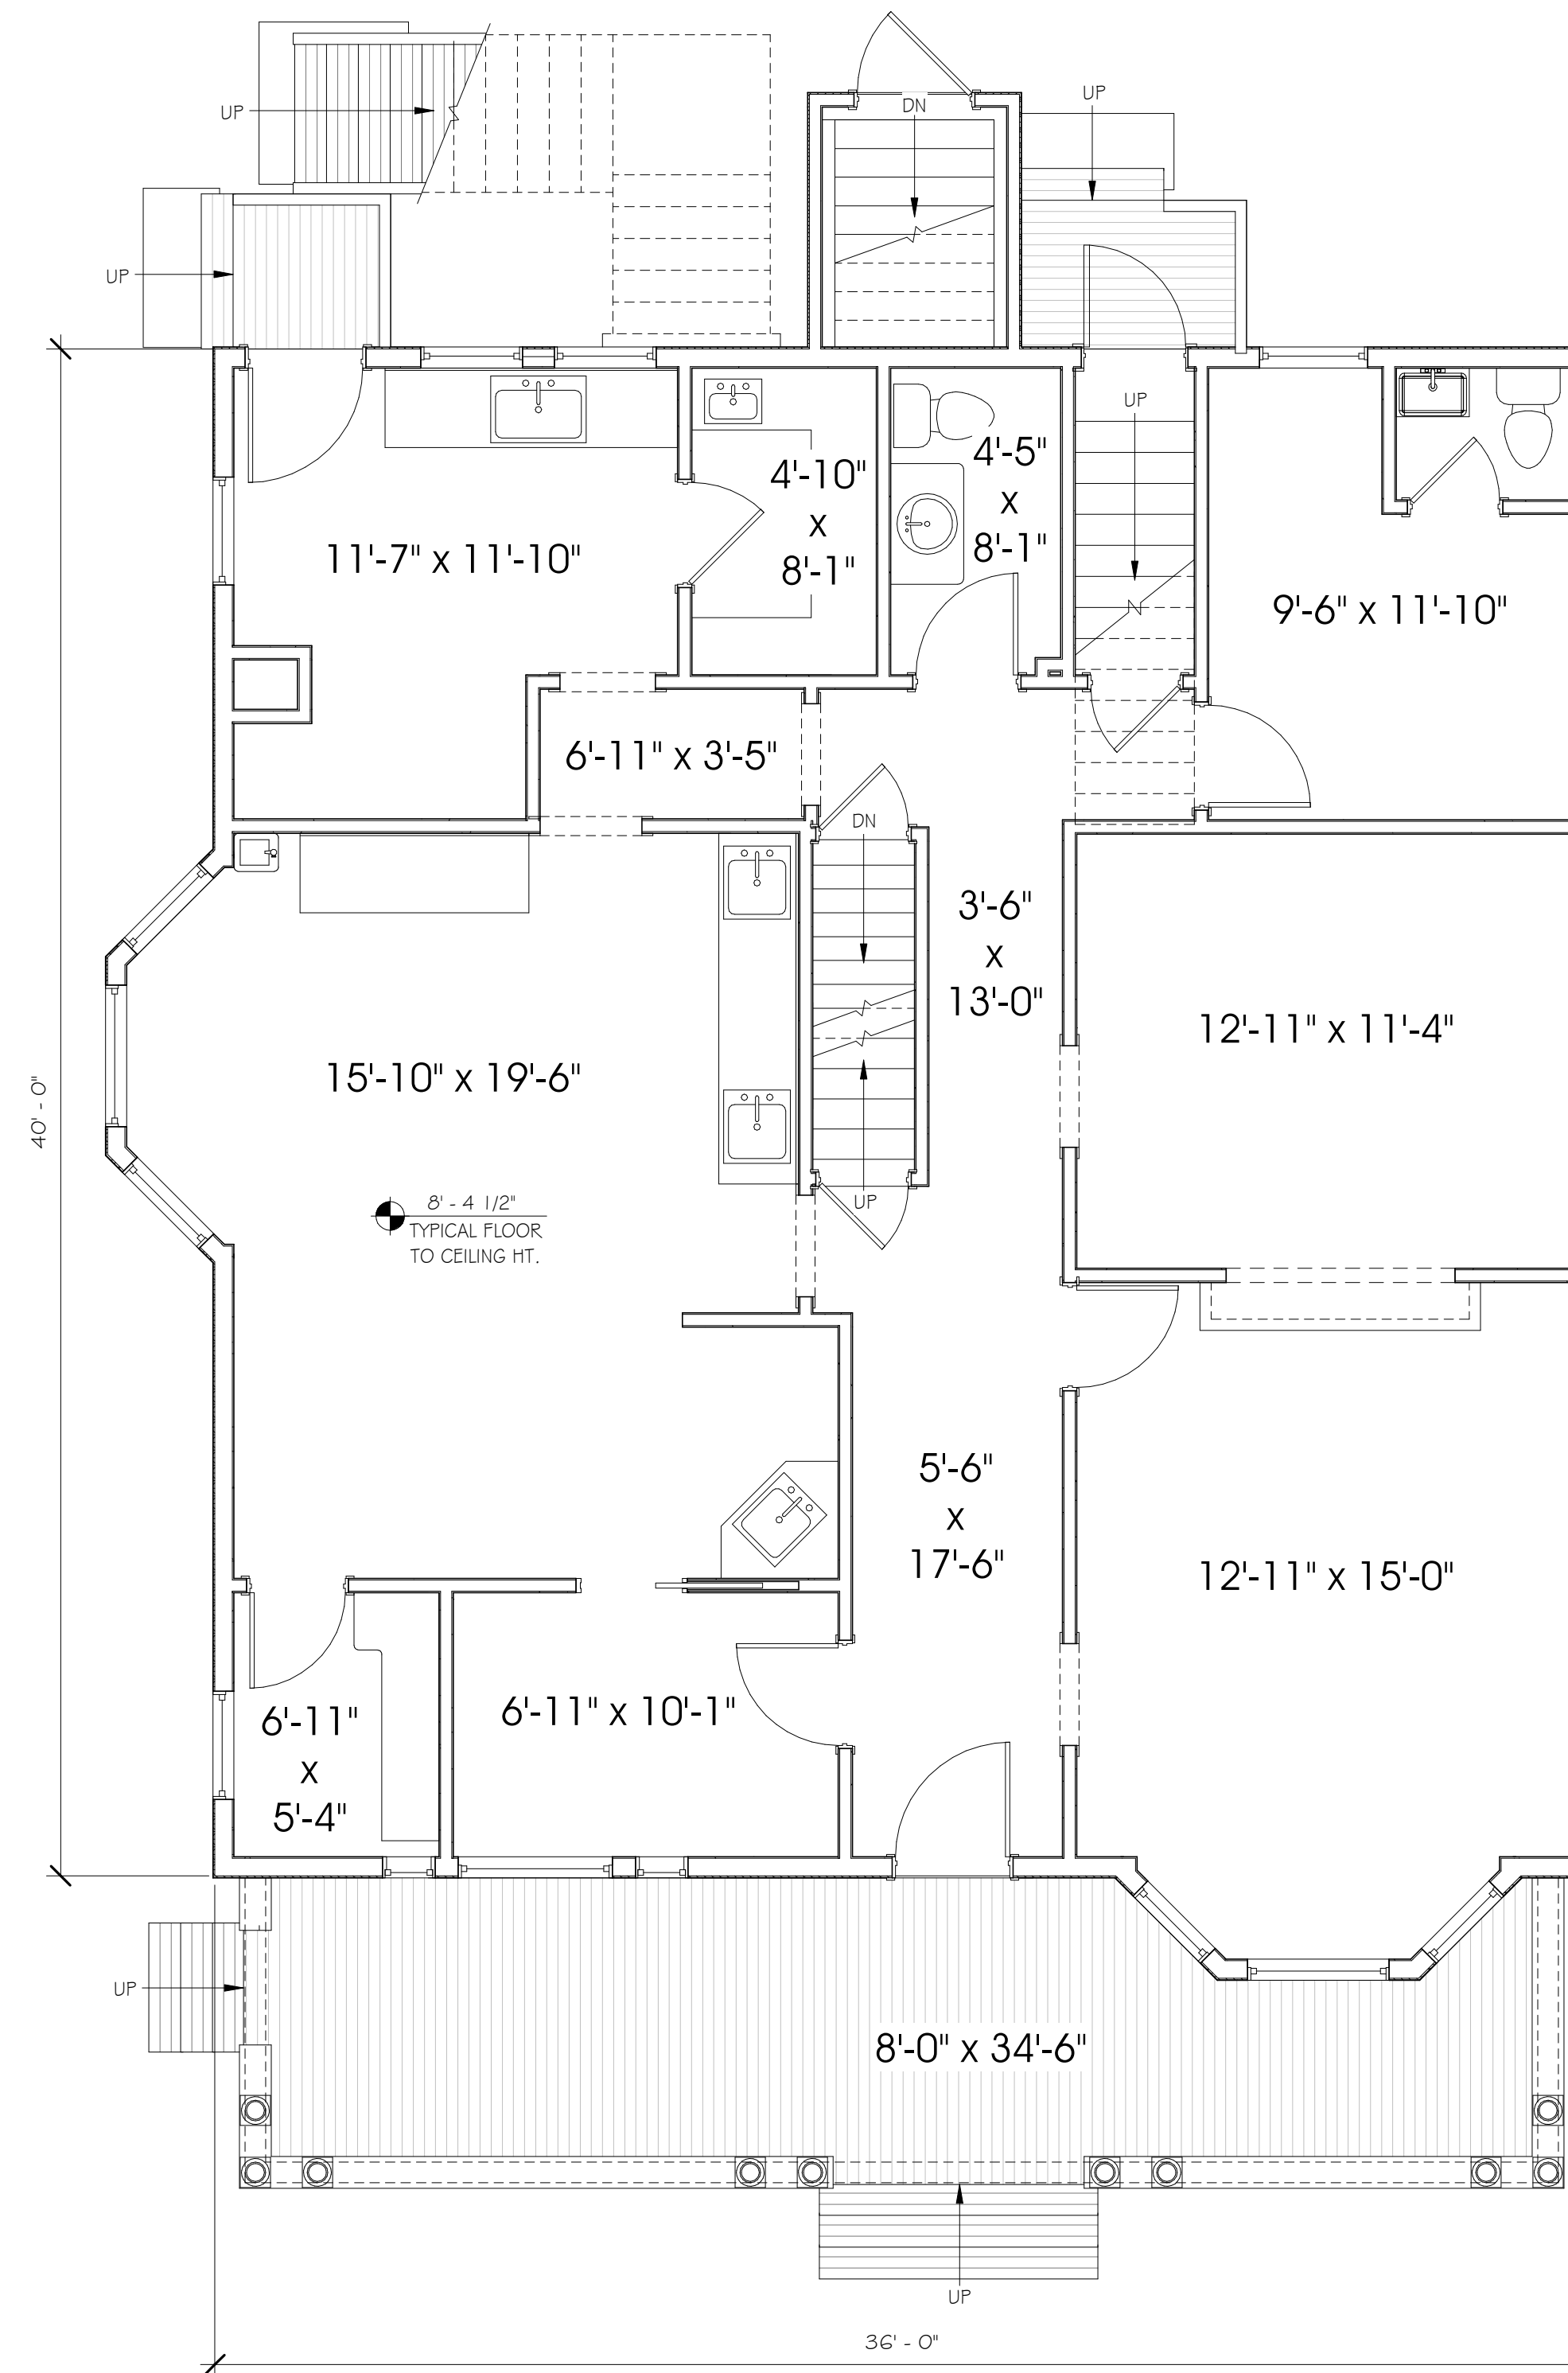


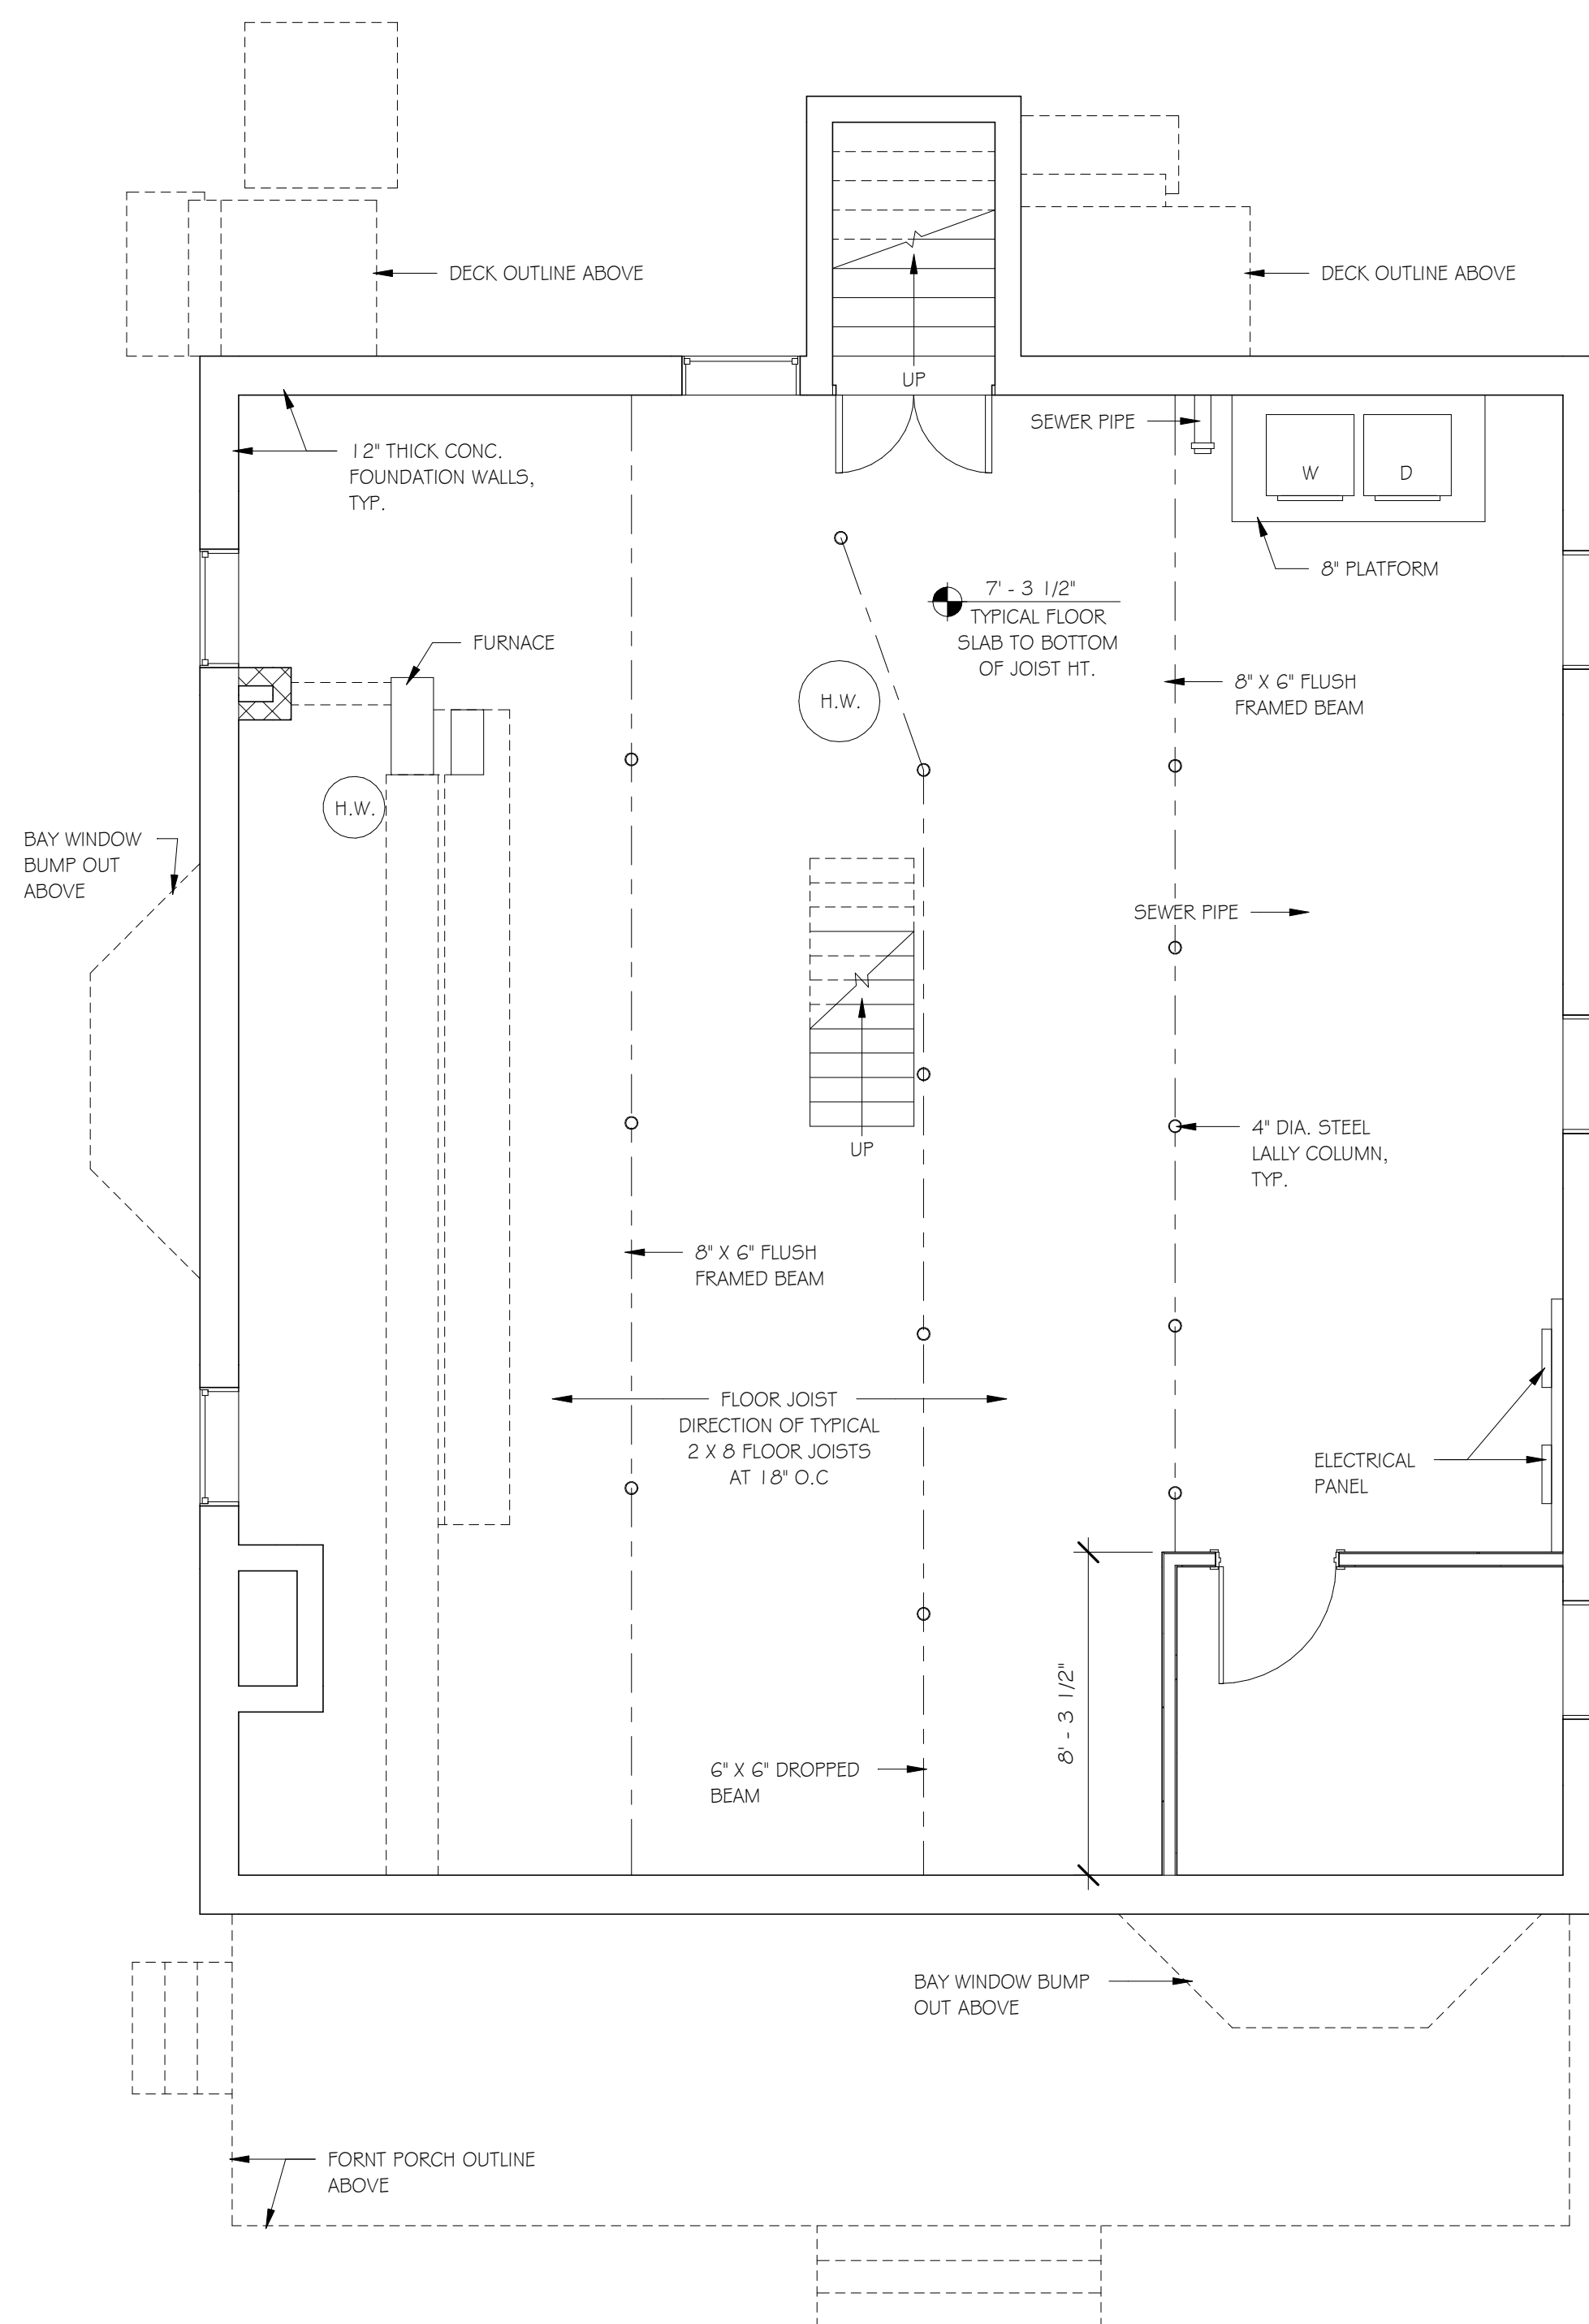

AREA TABLE:

FIRST FLOOR	=	1,484 GSF
SECOND FLOOR	=	759 GSF
TOTAL	=	2,243 GSF