



SMITH DESIGN GROUP, INC.  
 208 WEST HARALSON STREET  
 LAGRANGE, GEORGIA 30240  
 706-882-0511

**LEGEND OF WALLS**  
 FULL HEIGHT WALLS  
 PARTITIONS UP TO 8'-0" AFF.



1  
A1-1  
**EXISTING FLOOR PLAN**  
 Scale: 1/4" = 1'-0"  
**3,100 NET S.F.**

REVISIONS	
DATE	DESCRIPTION

PROJECT:  
**PROJECT NAME**  
 ADDRESS  
 LAGRANGE, GEORGIA

TITLE:  
**EXISTING CONDITIONS FLOOR PLAN**

MODIFIED DATE:	JOB NO: <b>2428</b>
ISSUED DATE: AS-BUILT 17 DEC 2024	SHEET: <b>A1-1</b>

ARCHITECT'S STAMP




*sg*

SMITH DESIGN GROUP, INC.

206 WEST HARALSON STREET  
LAGRANGE, GEORGIA 30240  
706-882-0511

LEGEND OF WALLS

- FULL HEIGHT WALLS
- PARTITIONS UP TO 8'-0" AFF.

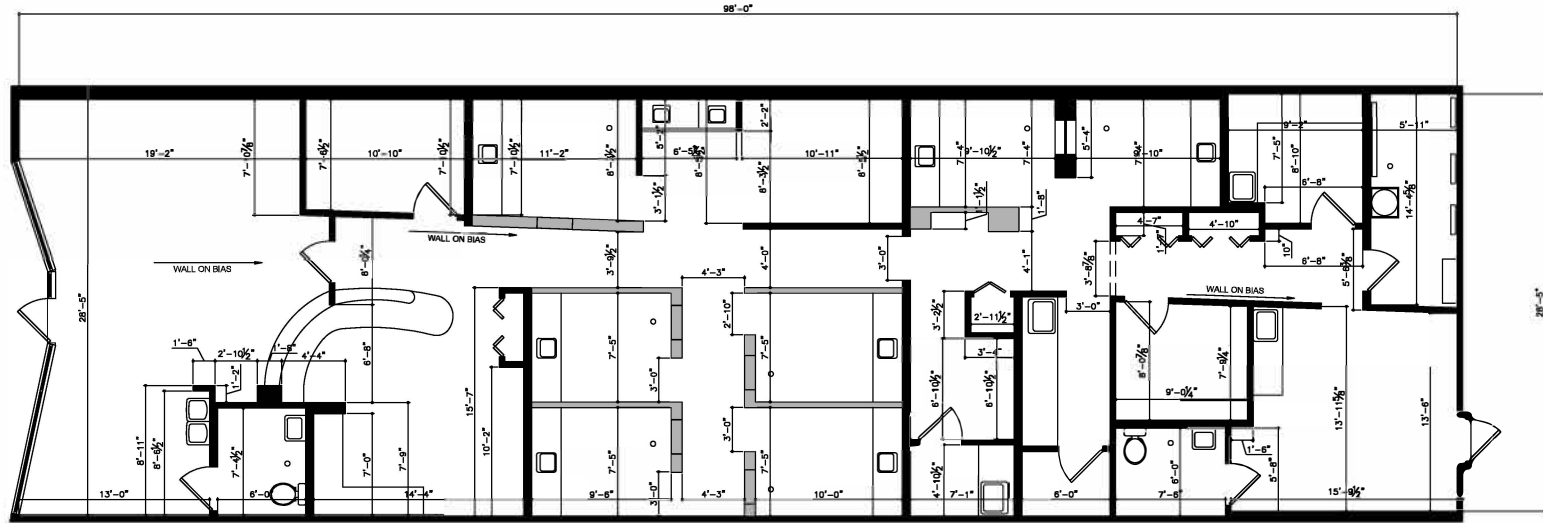

**1** DIMENSION FLOOR PLAN  
 A1-2  
**3,100 NET S.F.** Scale: 1/4" = 1'-0"

REVISIONS	
DATE	DESCRIPTION

PROJECT:  
**PROJECT NAME**  
 ADDRESS  
 LAGRANGE, GEORGIA

TITLE:  
**DIMENSION FLOOR PLAN**

MODIFIED DATE:	JOB NO: <b>2428</b>
ISSUED DATE:	SHEET: <b>A1-2</b>
AS BUILT 17 DEC 2024	