

COPYRIGHT NOTICE

ALL DESIGNS AND  
DETAILS ON THIS  
DRAWING ARE THE  
PROPERTY OF OVERHEAD  
STUDIO AND SHALL NOT  
BE COPIED, REPRODUCED  
OR UTILIZED WITHOUT  
PRIOR WRITTEN CONSENT  
FROM OVERHEAD STUDIO

PROJECT # 2402

PROJECT TITLE :

**320 EAST  
OAKLAND  
PARK BLVD**

Wilton Manors, FL

REVISIONS :

# DATE

**NOT FOR  
CONSTRUCTION**


SHEET TITLE :

**AS-BUILT**

SHEET NUMBER :

**A001**

DATE : 5-24-2024

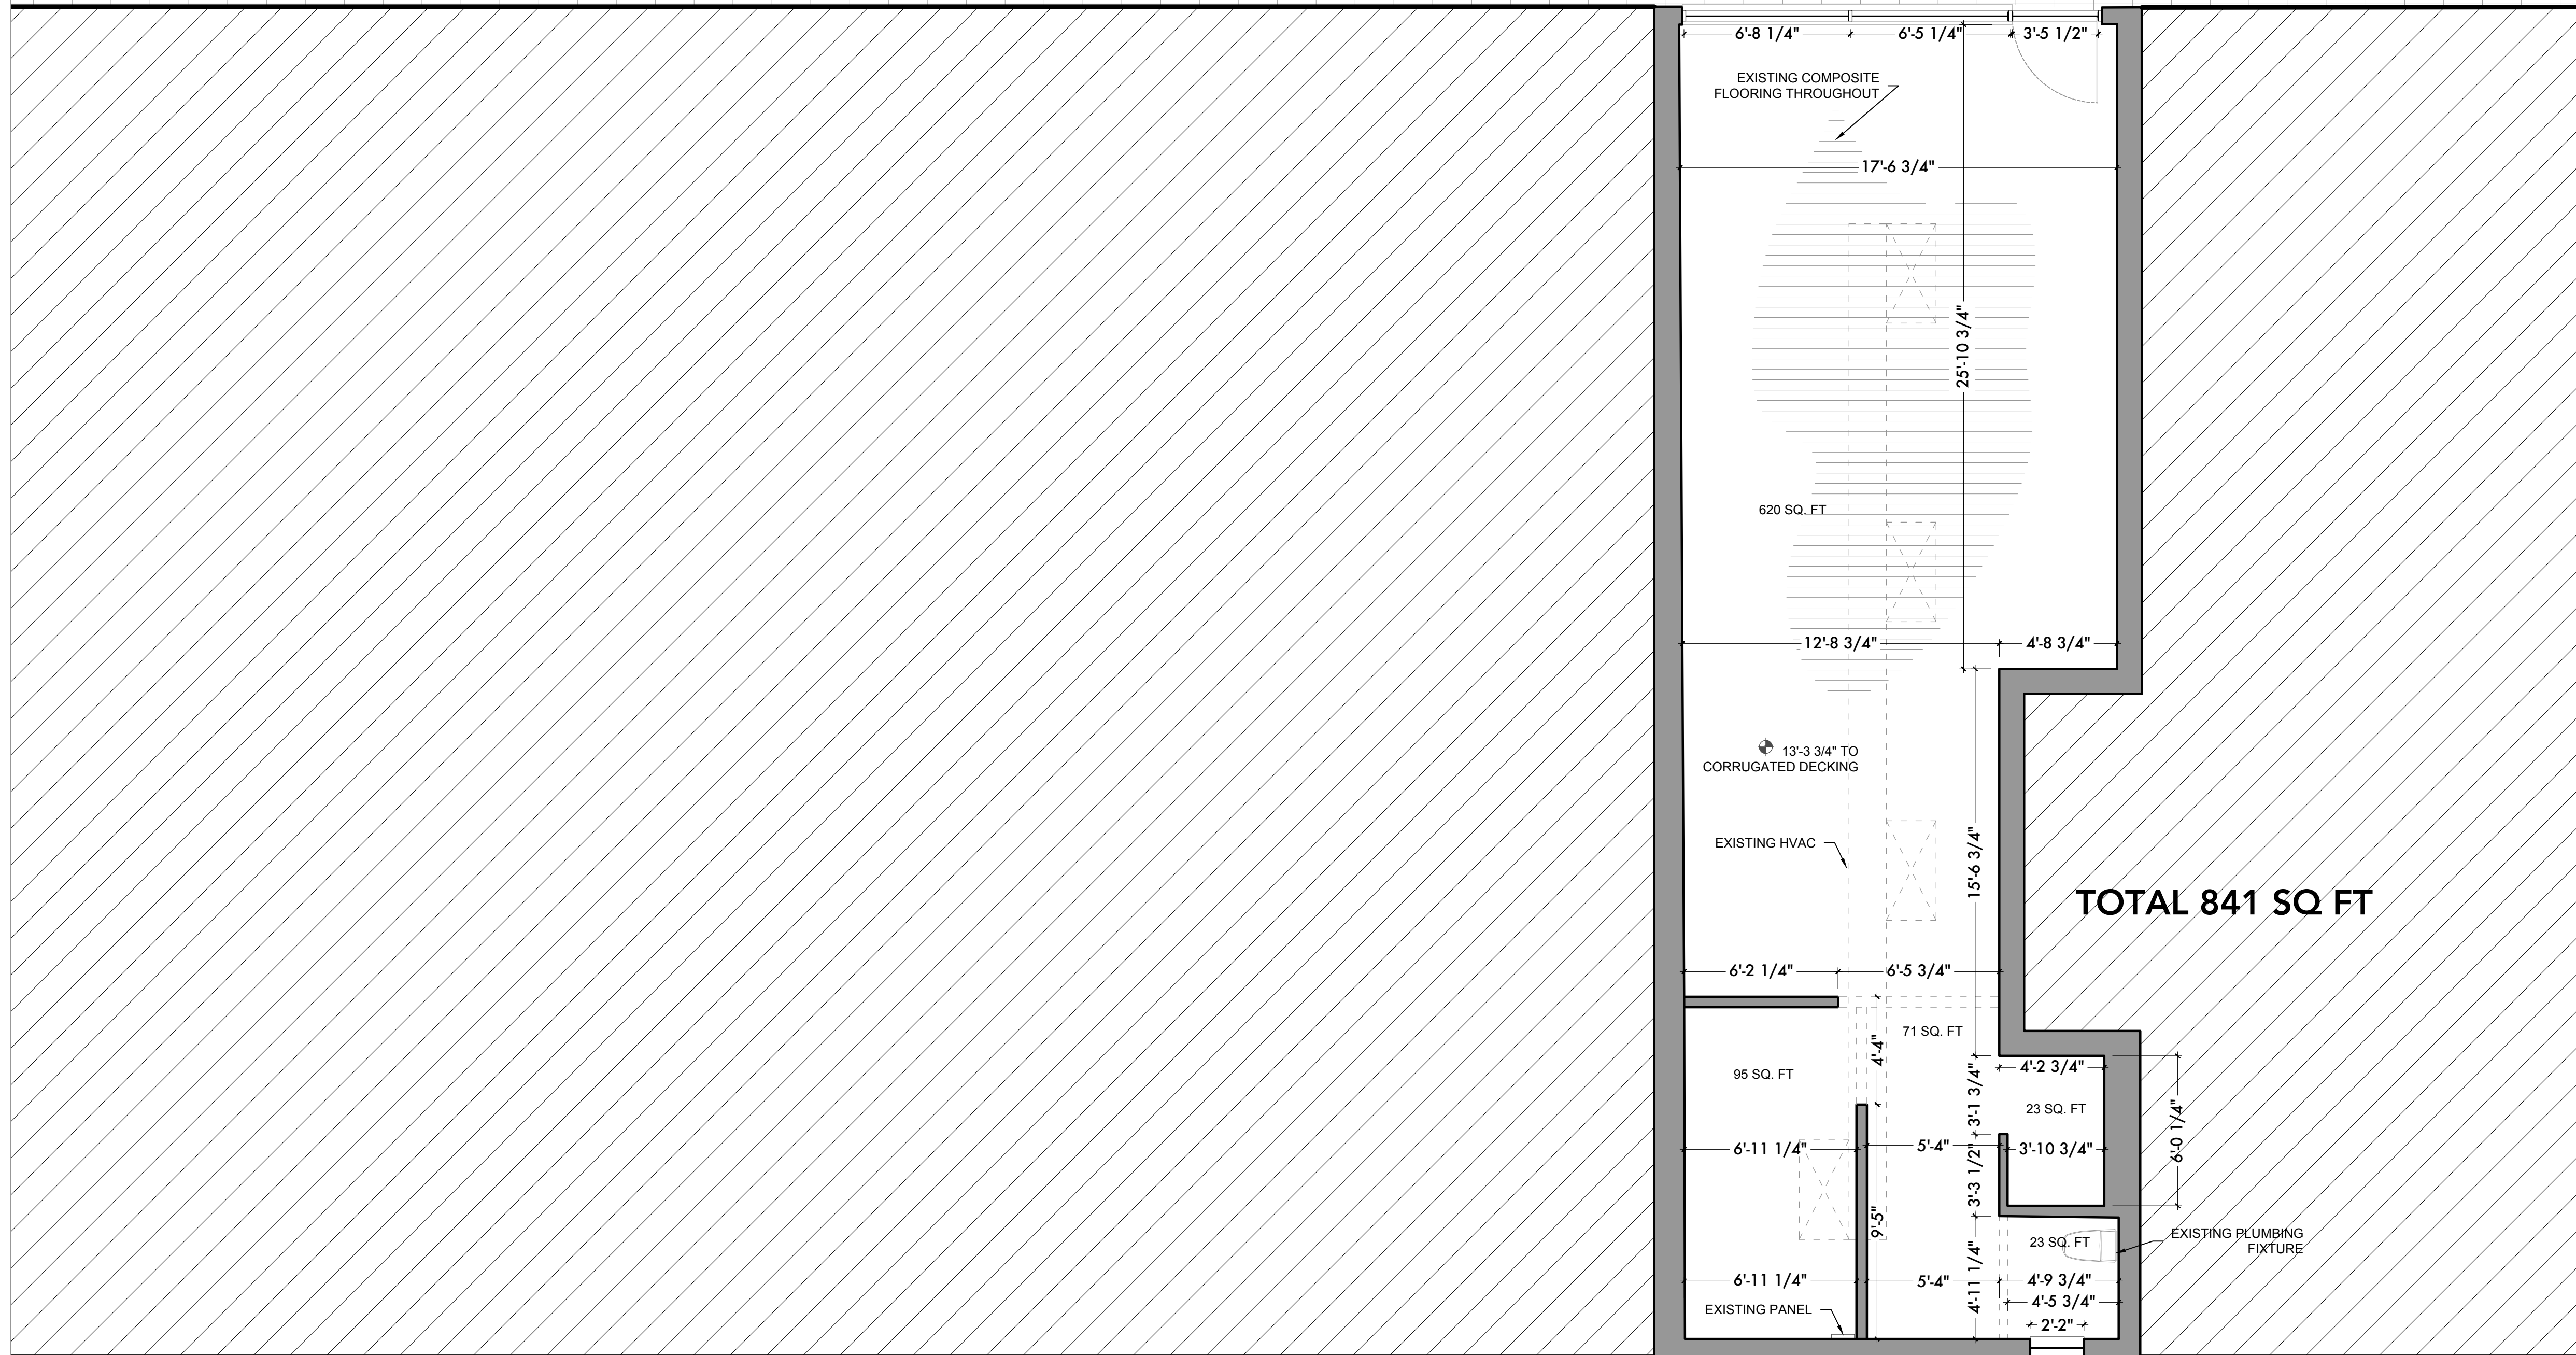

**TOTAL 841 SQ FT**



SHEET NOTES

LEGEND

