


Suite A-201-205 | 3,798 SF

AS BUILT FLOOR PLAN

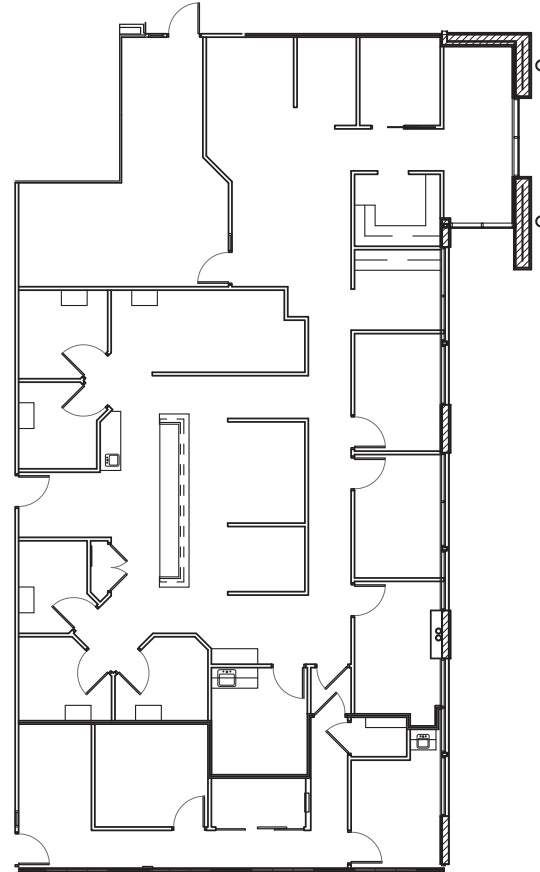

OWNED BY



LEASING BY

Rachael Thompson

602.513.5122

rachael.thompson@kidder.com

Perry Gabuzzi, CCIM

602.513.5116

perry.gabuzzi@kidder.com

