


# **SUITE #1A**

2,050 sqft

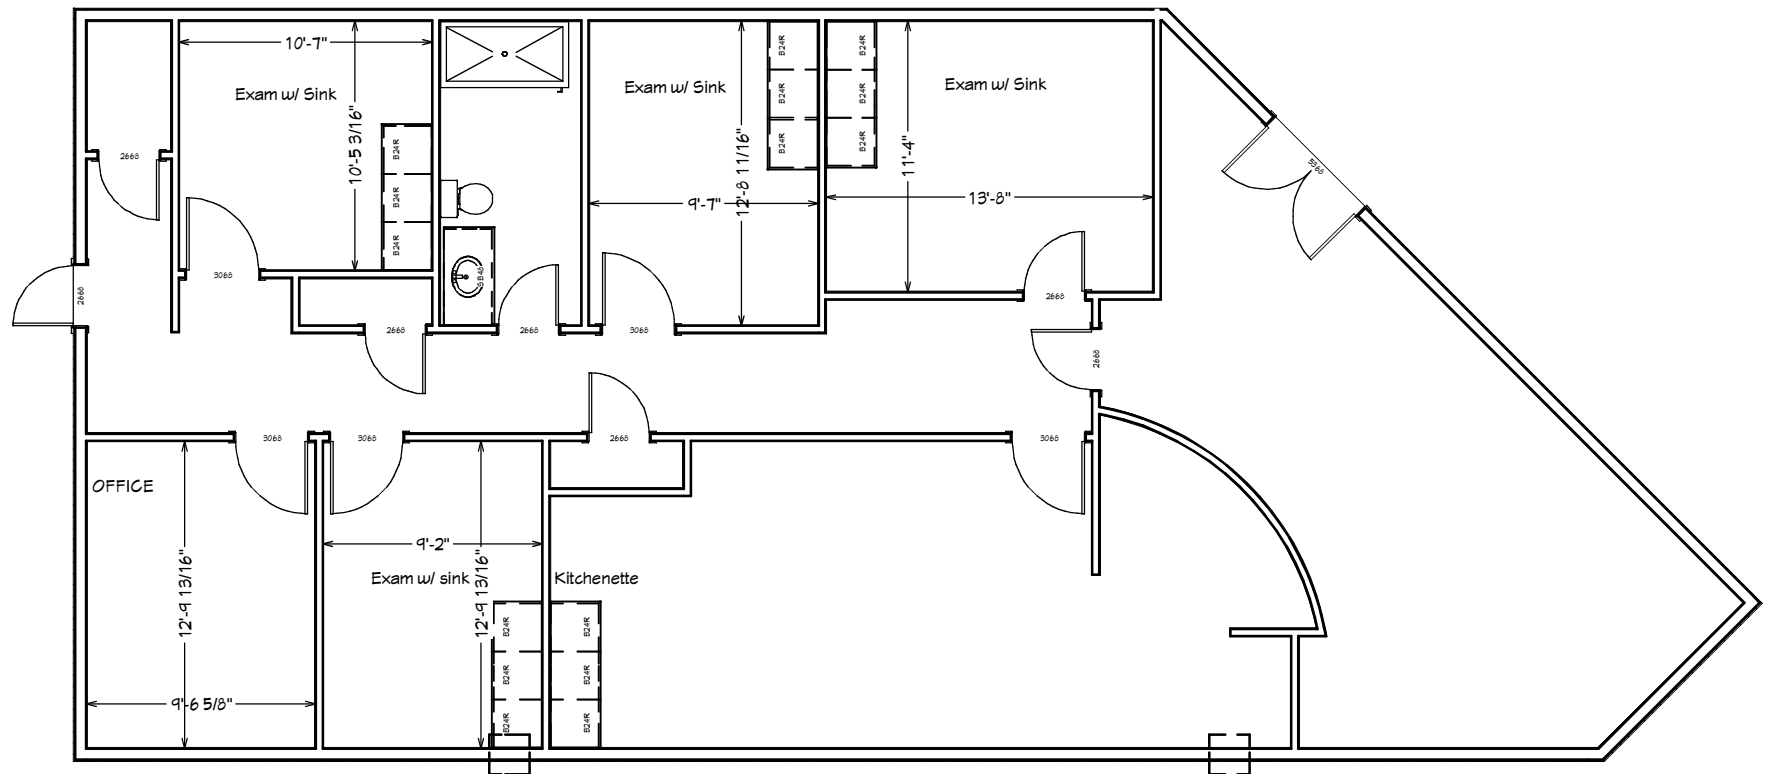

Prepared by DVP  
\*\*all dimensions are approx.