

B KEY PLAN


SCALE: N.T.S.



SUITE 200
2,826.25 USF
3,250.19 RSF

A FLOOR PLAN

SCALE: N.T.S.

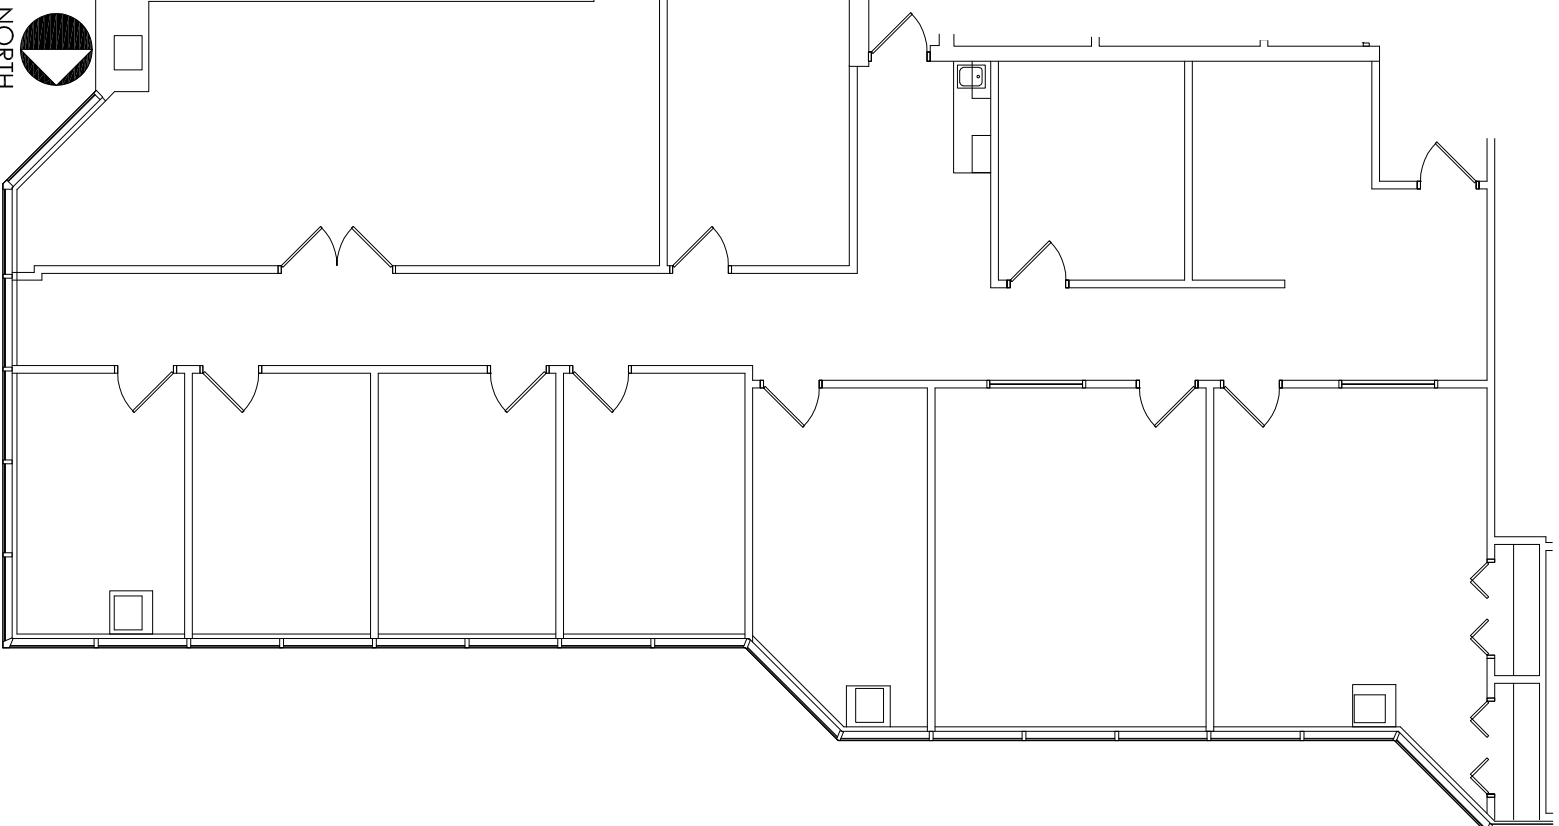

ARCHITECTURE \ INTERIORS \ ENGINEERING

KKT ARCHITECTS, INC.
2200 SOUTH UNICA PLACE, SUITE 200
TULSA, OKLAHOMA 74114
|P| 918.744.4270 \ |F| 918.744.7849
WWW.KKTARCHITECTS.COM
C O F A # 534 6730719

EXECUTIVE CENTER II

SUITE
200

COURY
PROPERTIES

4.9.19



ASBUILT
PLAN

AS-2