

# BOSWELL WEST MEDICAL OFFICE BUILDING

10503 W THUNDERBIRD BLVD | SUN CITY, AZ 85351


## Floor 02

Suite 240

AS-BUILT

2,631 SF

AVAILABLE

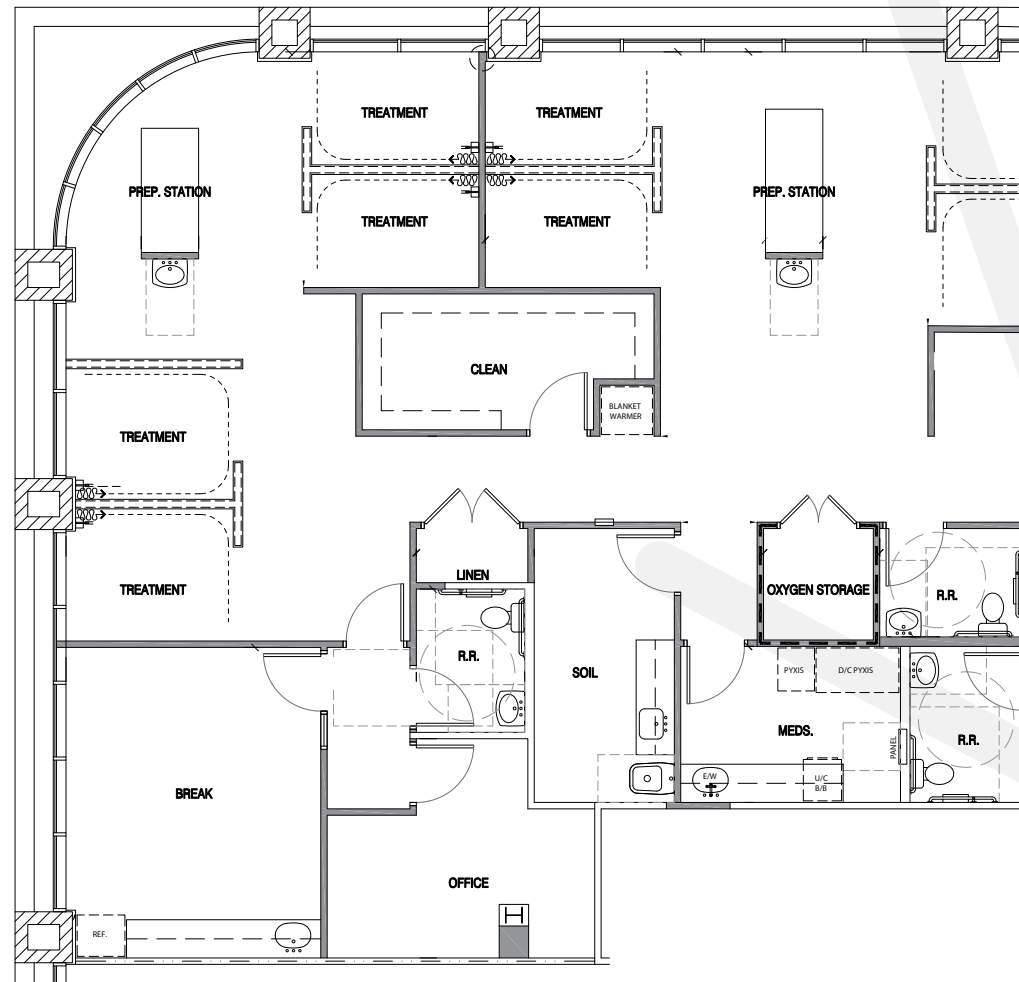

**RACHAEL THOMPSON**  
Senior Vice President  
602.513.5122  
rachael.thompson@kidder.com

**PERRY GABUZZI, CCIM**  
Senior Vice President  
602.513.5116  
perry.gabuzzi@kidder.com



View Portfolio

**km** Kidder  
Mathews