





5,929 RSF

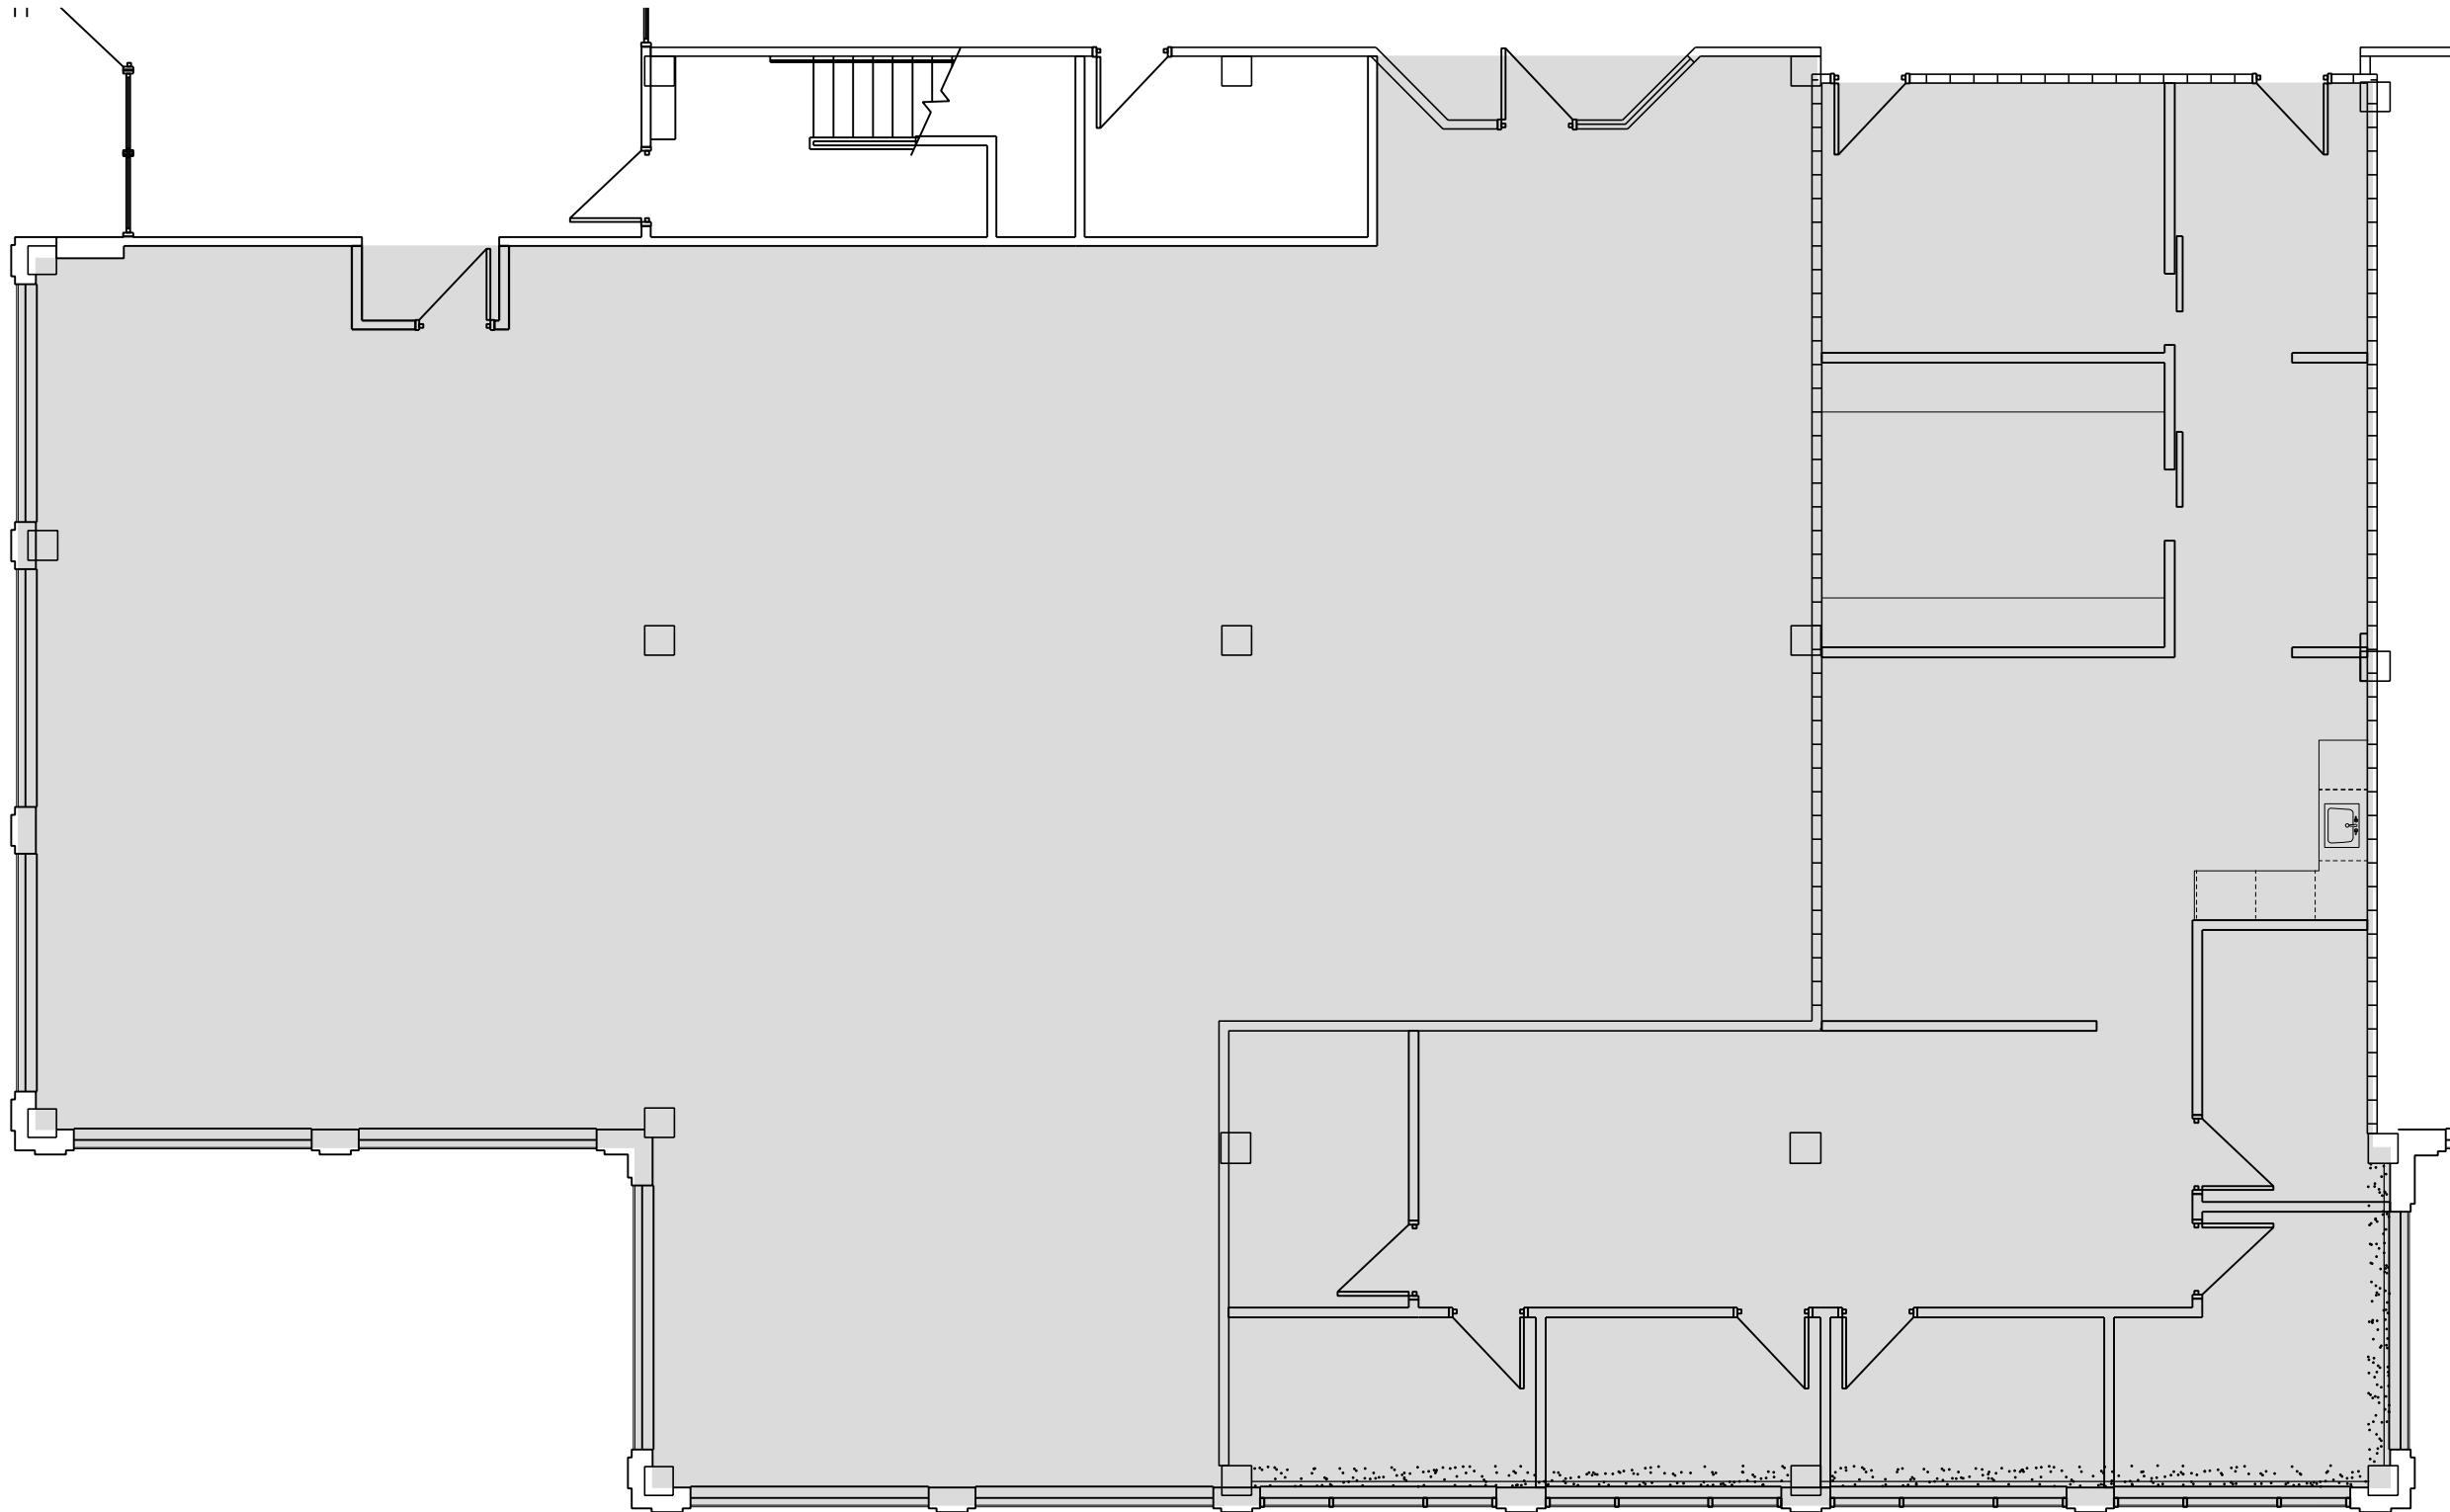

**LONG LAKE CROSSING**  
**1301 W. LONG LAKE RD. - SUITE 108/130 COMBINED**  
5-20-26 SCALE: 1/8" = 1'-0"

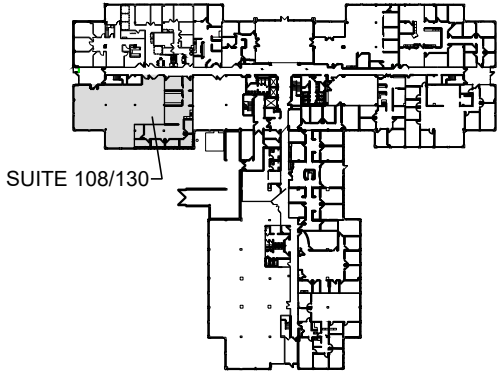

**KEY PLAN**  
NOT TO SCALE

