
 

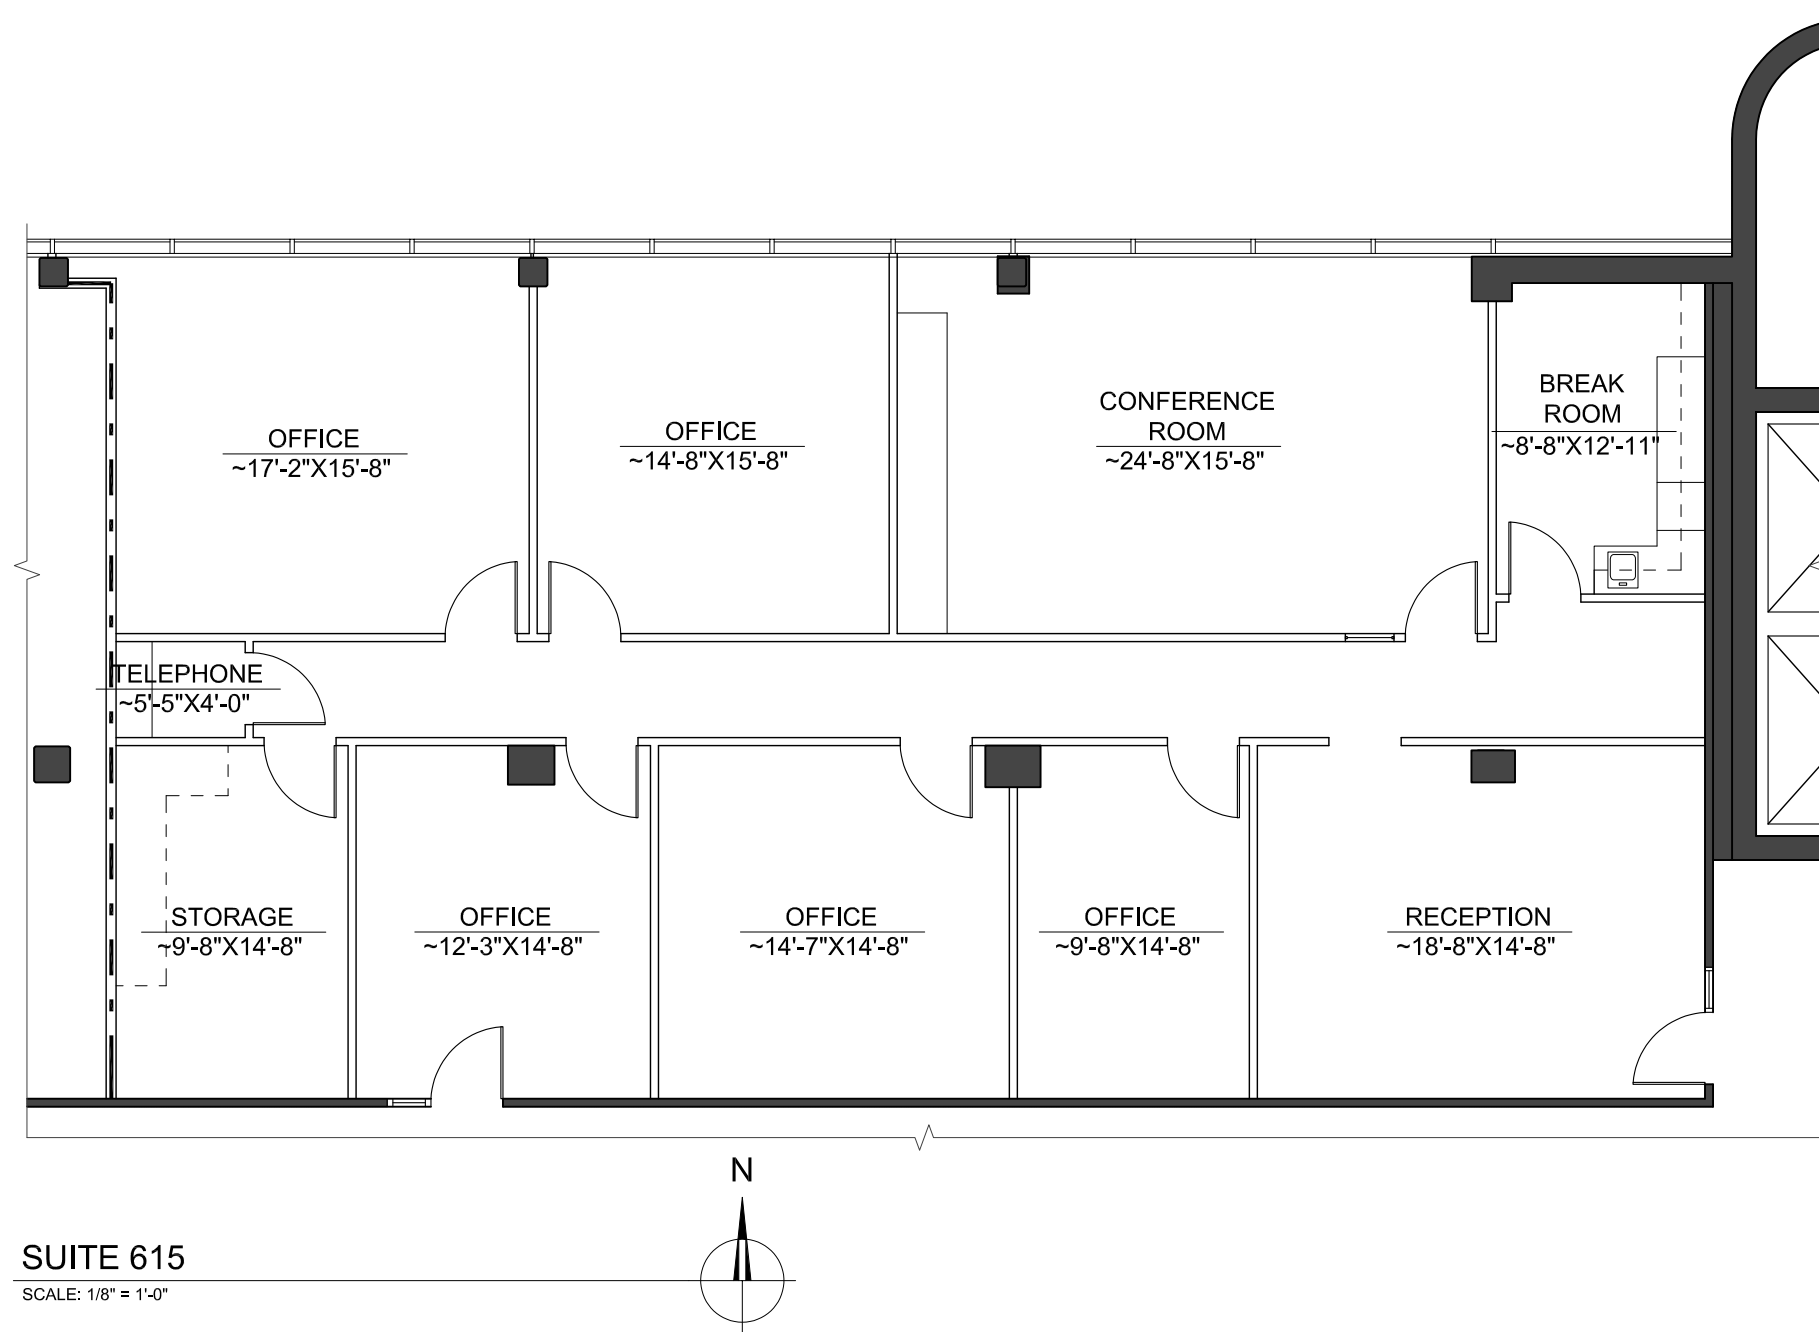


**LEGEND:**

-  EXISTING BUILDING SHELL
-  EXISTING DEMISING PARTITION
-  EXISTING INTERIOR PARTITION



*SRI*

925 FORT STOCKTON DRIVE  
SAN DIEGO, CA 92103  
PH (619) 297-6153  
FAX (619) 299-6072

**ALLIED PLAZA**  
7777 ALVARADO ROAD  
SUITE 615  
LA MESA, CA 91942

**AS BUILT**

Date: 09.18.2025  
Scale: 1/8" = 1'-0"  
Job Number: 4181.7