

NOT FOR
CONSTRUCTION

Scaleable on 30"x42"

Sunco Construction
BUILDING A BETTER TOMORROW
245 Indianapolis Road Mooresville, IN 46158
www.SuncoConstruction.com



No.	Description	Date

Suite A

Site Plan


Project number	Project Number
Date	Issue Date
Drawn by	Author
Checked by	Checker

A00

Scale 3/16" = 1'-0"

① Site Plan
3/16" = 1'-0"

4/2/2008 3:57:10 PM

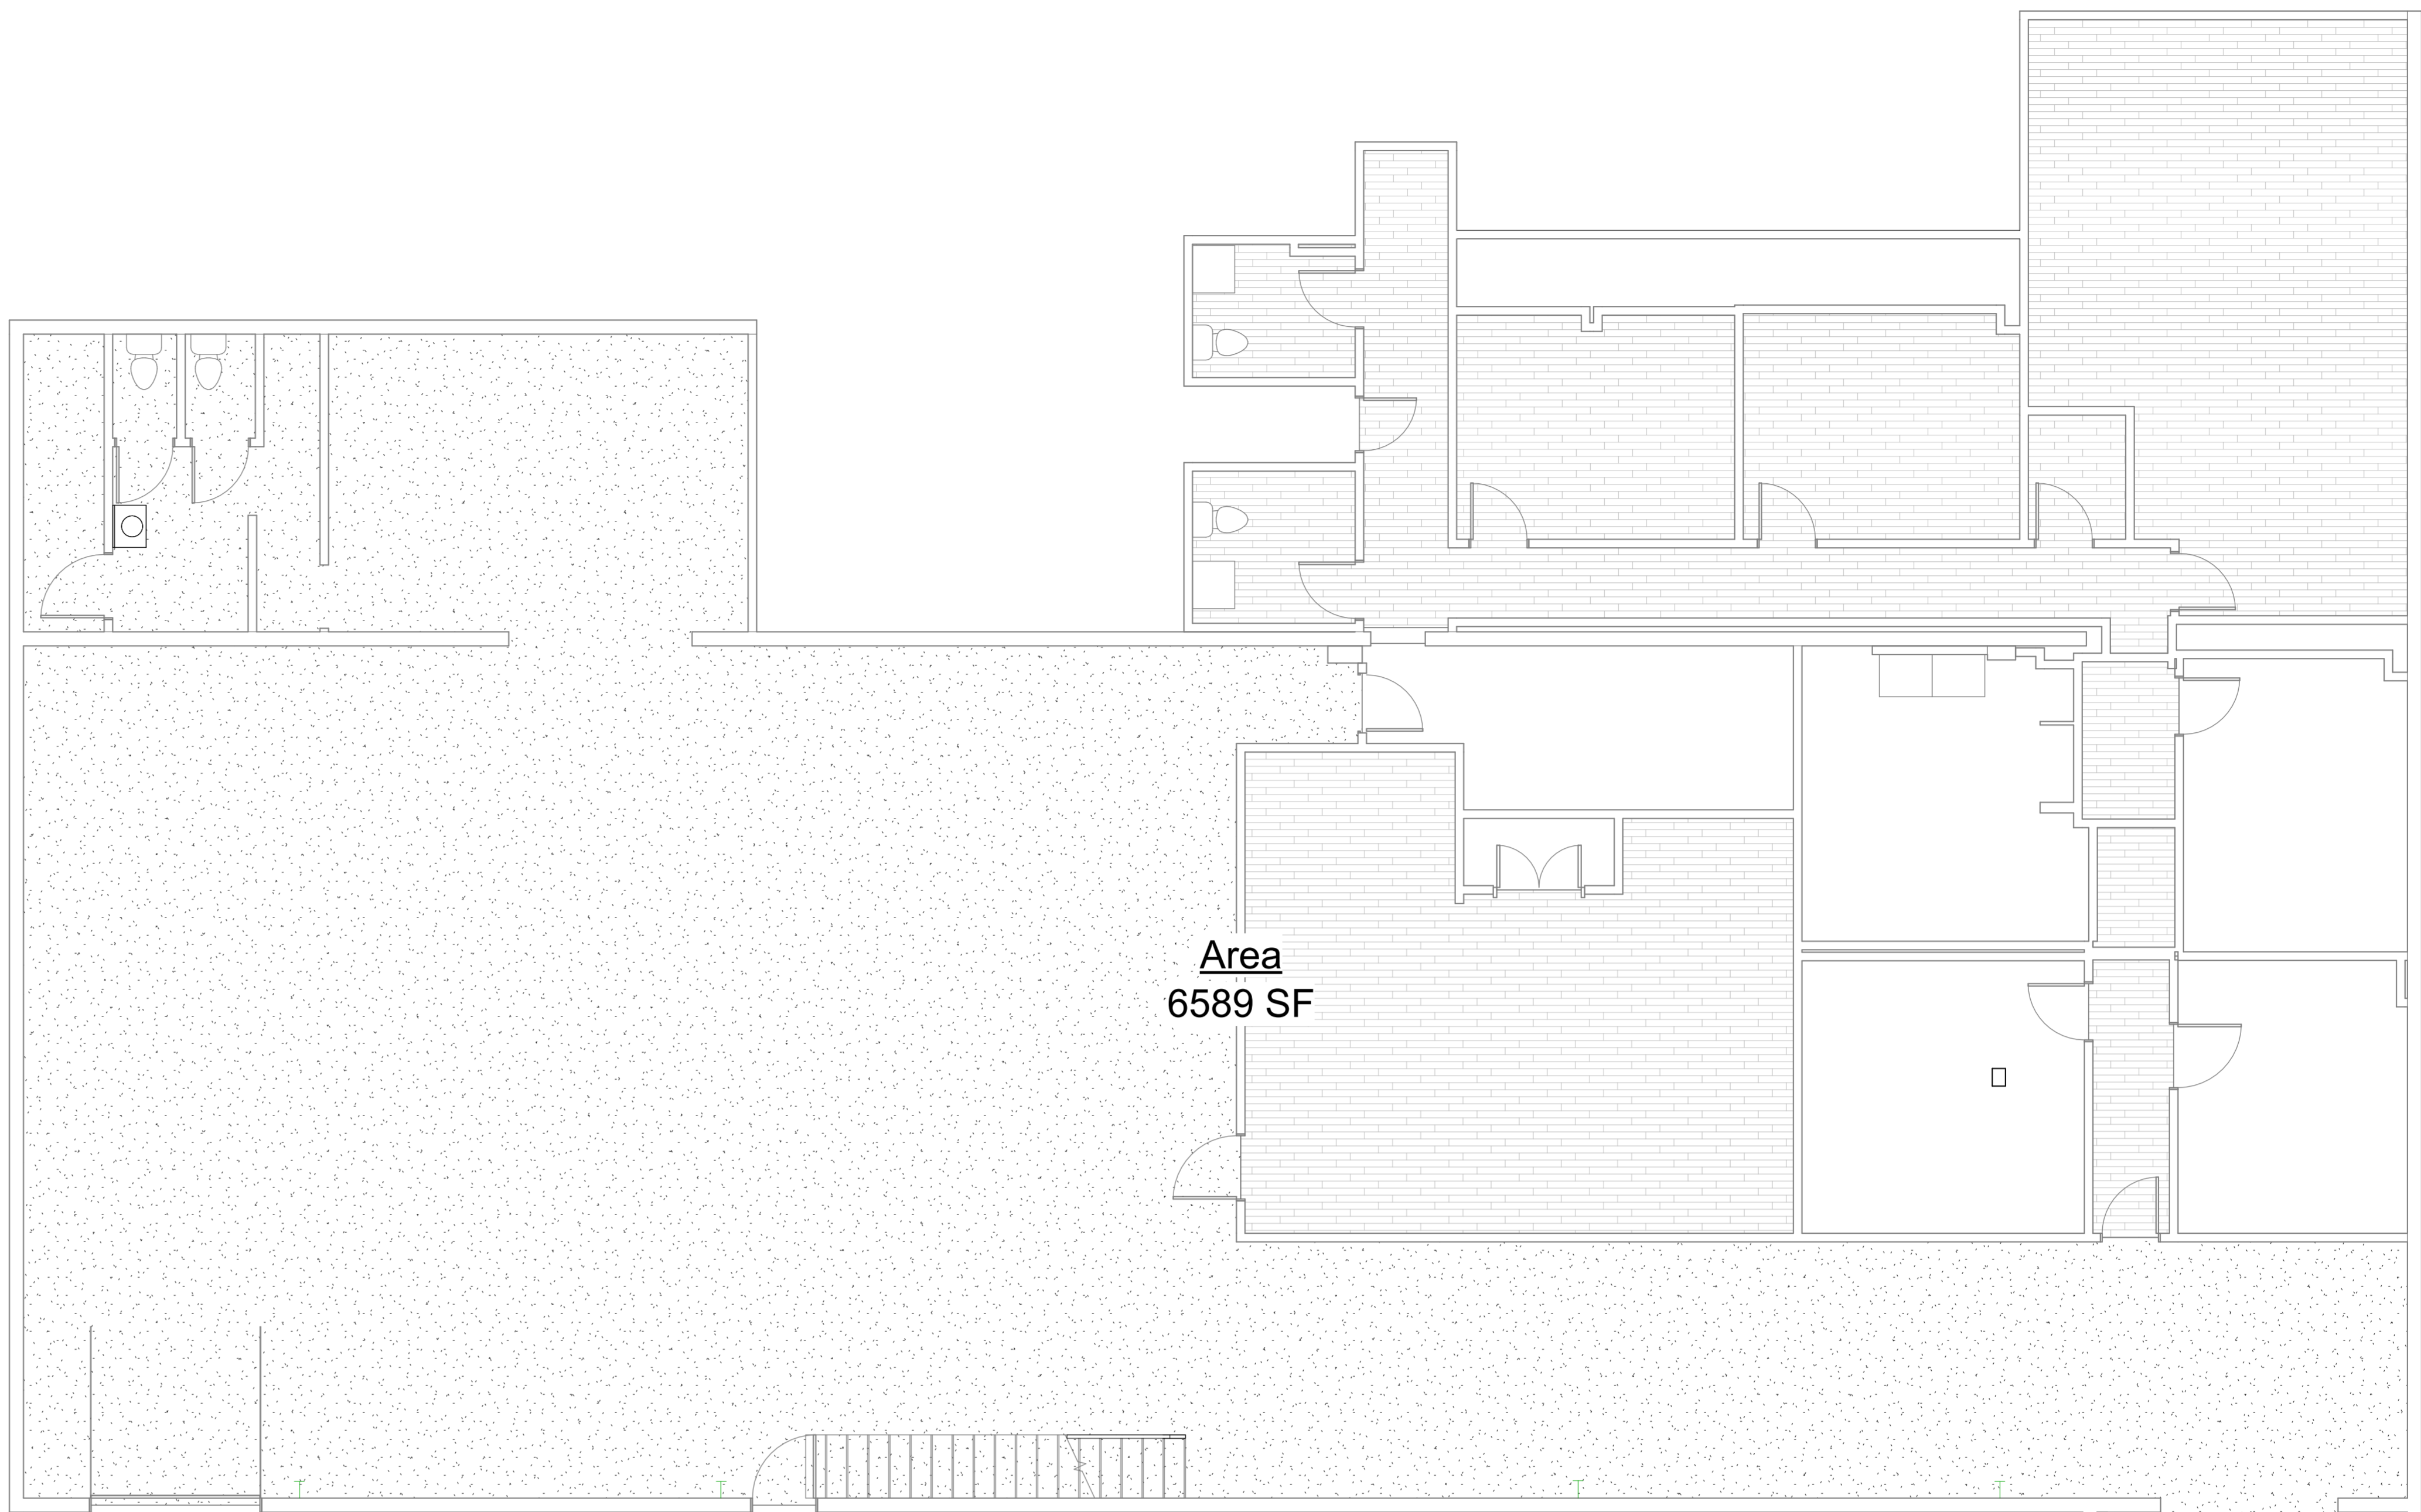

① First Floor
3/16" = 1'-0"



② Second Floor
3/16" = 1'-0"

NOT FOR
CONSTRUCTION

Scaleable on 30"x42"

Sunco Construction
BUILDING A BETTER TOMORROW
245 Indianapolis Road Mooresville, IN 46158
www.SuncoConstruction.com



No.	Description	Date

Suite A

Square Footage

Project number	Project Number
Date	Issue Date
Drawn by	Author
Checked by	Checker

A01

Scale 3/16" = 1'-0"

NOT DIMENSIONED

3' Opening

Breaker Panel

Breaker Panel

Breaker Panel

HVAC Opening
6' 6 1/4"
High
3' 7 1/4"
Wide

Electrical Disconnect Panels

Stairs

① First Floor
3/16" = 1'-0"

Fusible Safety Disconnect Switch

Breaker Panel

Framed Electrical Chase Opening

Wall-Mounted Exhaust Fan

Existing Metal Framing

Existing Ladder

Small Electrical Disconnect

② Second Floor
3/16" = 1'-0"

NOT FOR CONSTRUCTION

Scaleable on 30"x42"

Sunco Construction
BUILDING A BETTER TOMORROW
245 Indianapolis Road Mooresville, IN 46158
www.SuncoConstruction.com



No.	Description	Date

Suite A

Floor Plans

Project number	Project Number
Date	Issue Date
Drawn by	Author
Checked by	Checker

A02

Scale 3/16" = 1'-0"

4/2/2008 3:57:12 PM