
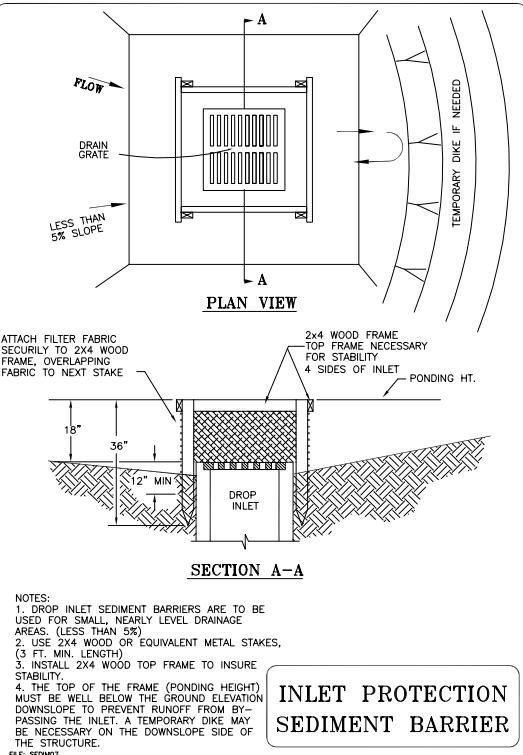
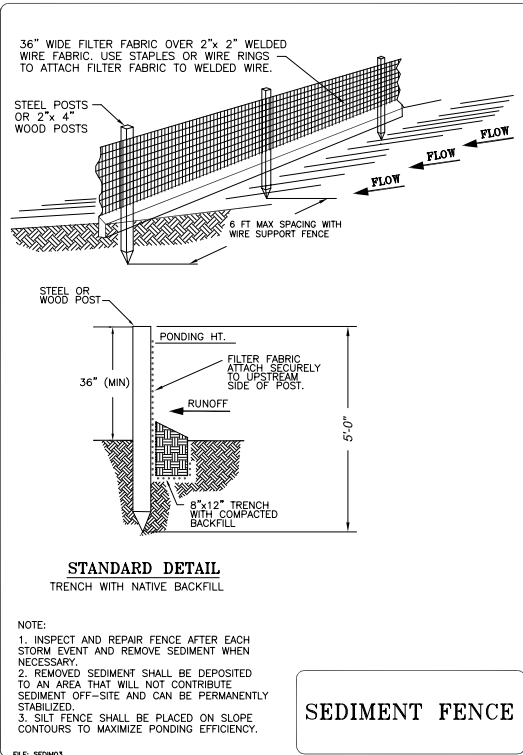




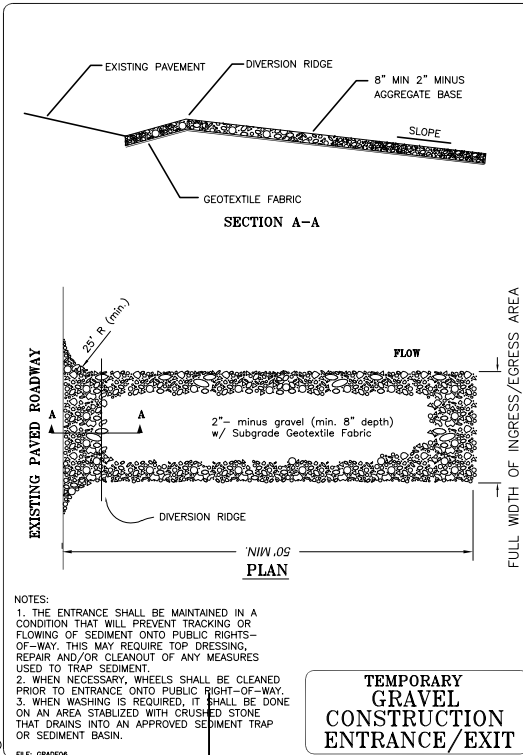


CONSTRUCTION NOTES

1. CONSTRUCT GRAVEL CONSTRUCTION ENTRANCE PER DETAIL THIS SHEET
2. CONSTRUCT SEDIMENT FENCE PER DETAIL THIS SHEET
3. INSTALL INLET PROTECTION PER DETAIL THIS SHEET

LEGEND

- x — x — x — SEDIMENT FENCE
- CATCH BASIN PROTECTION

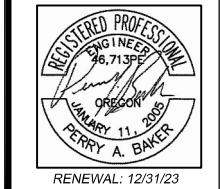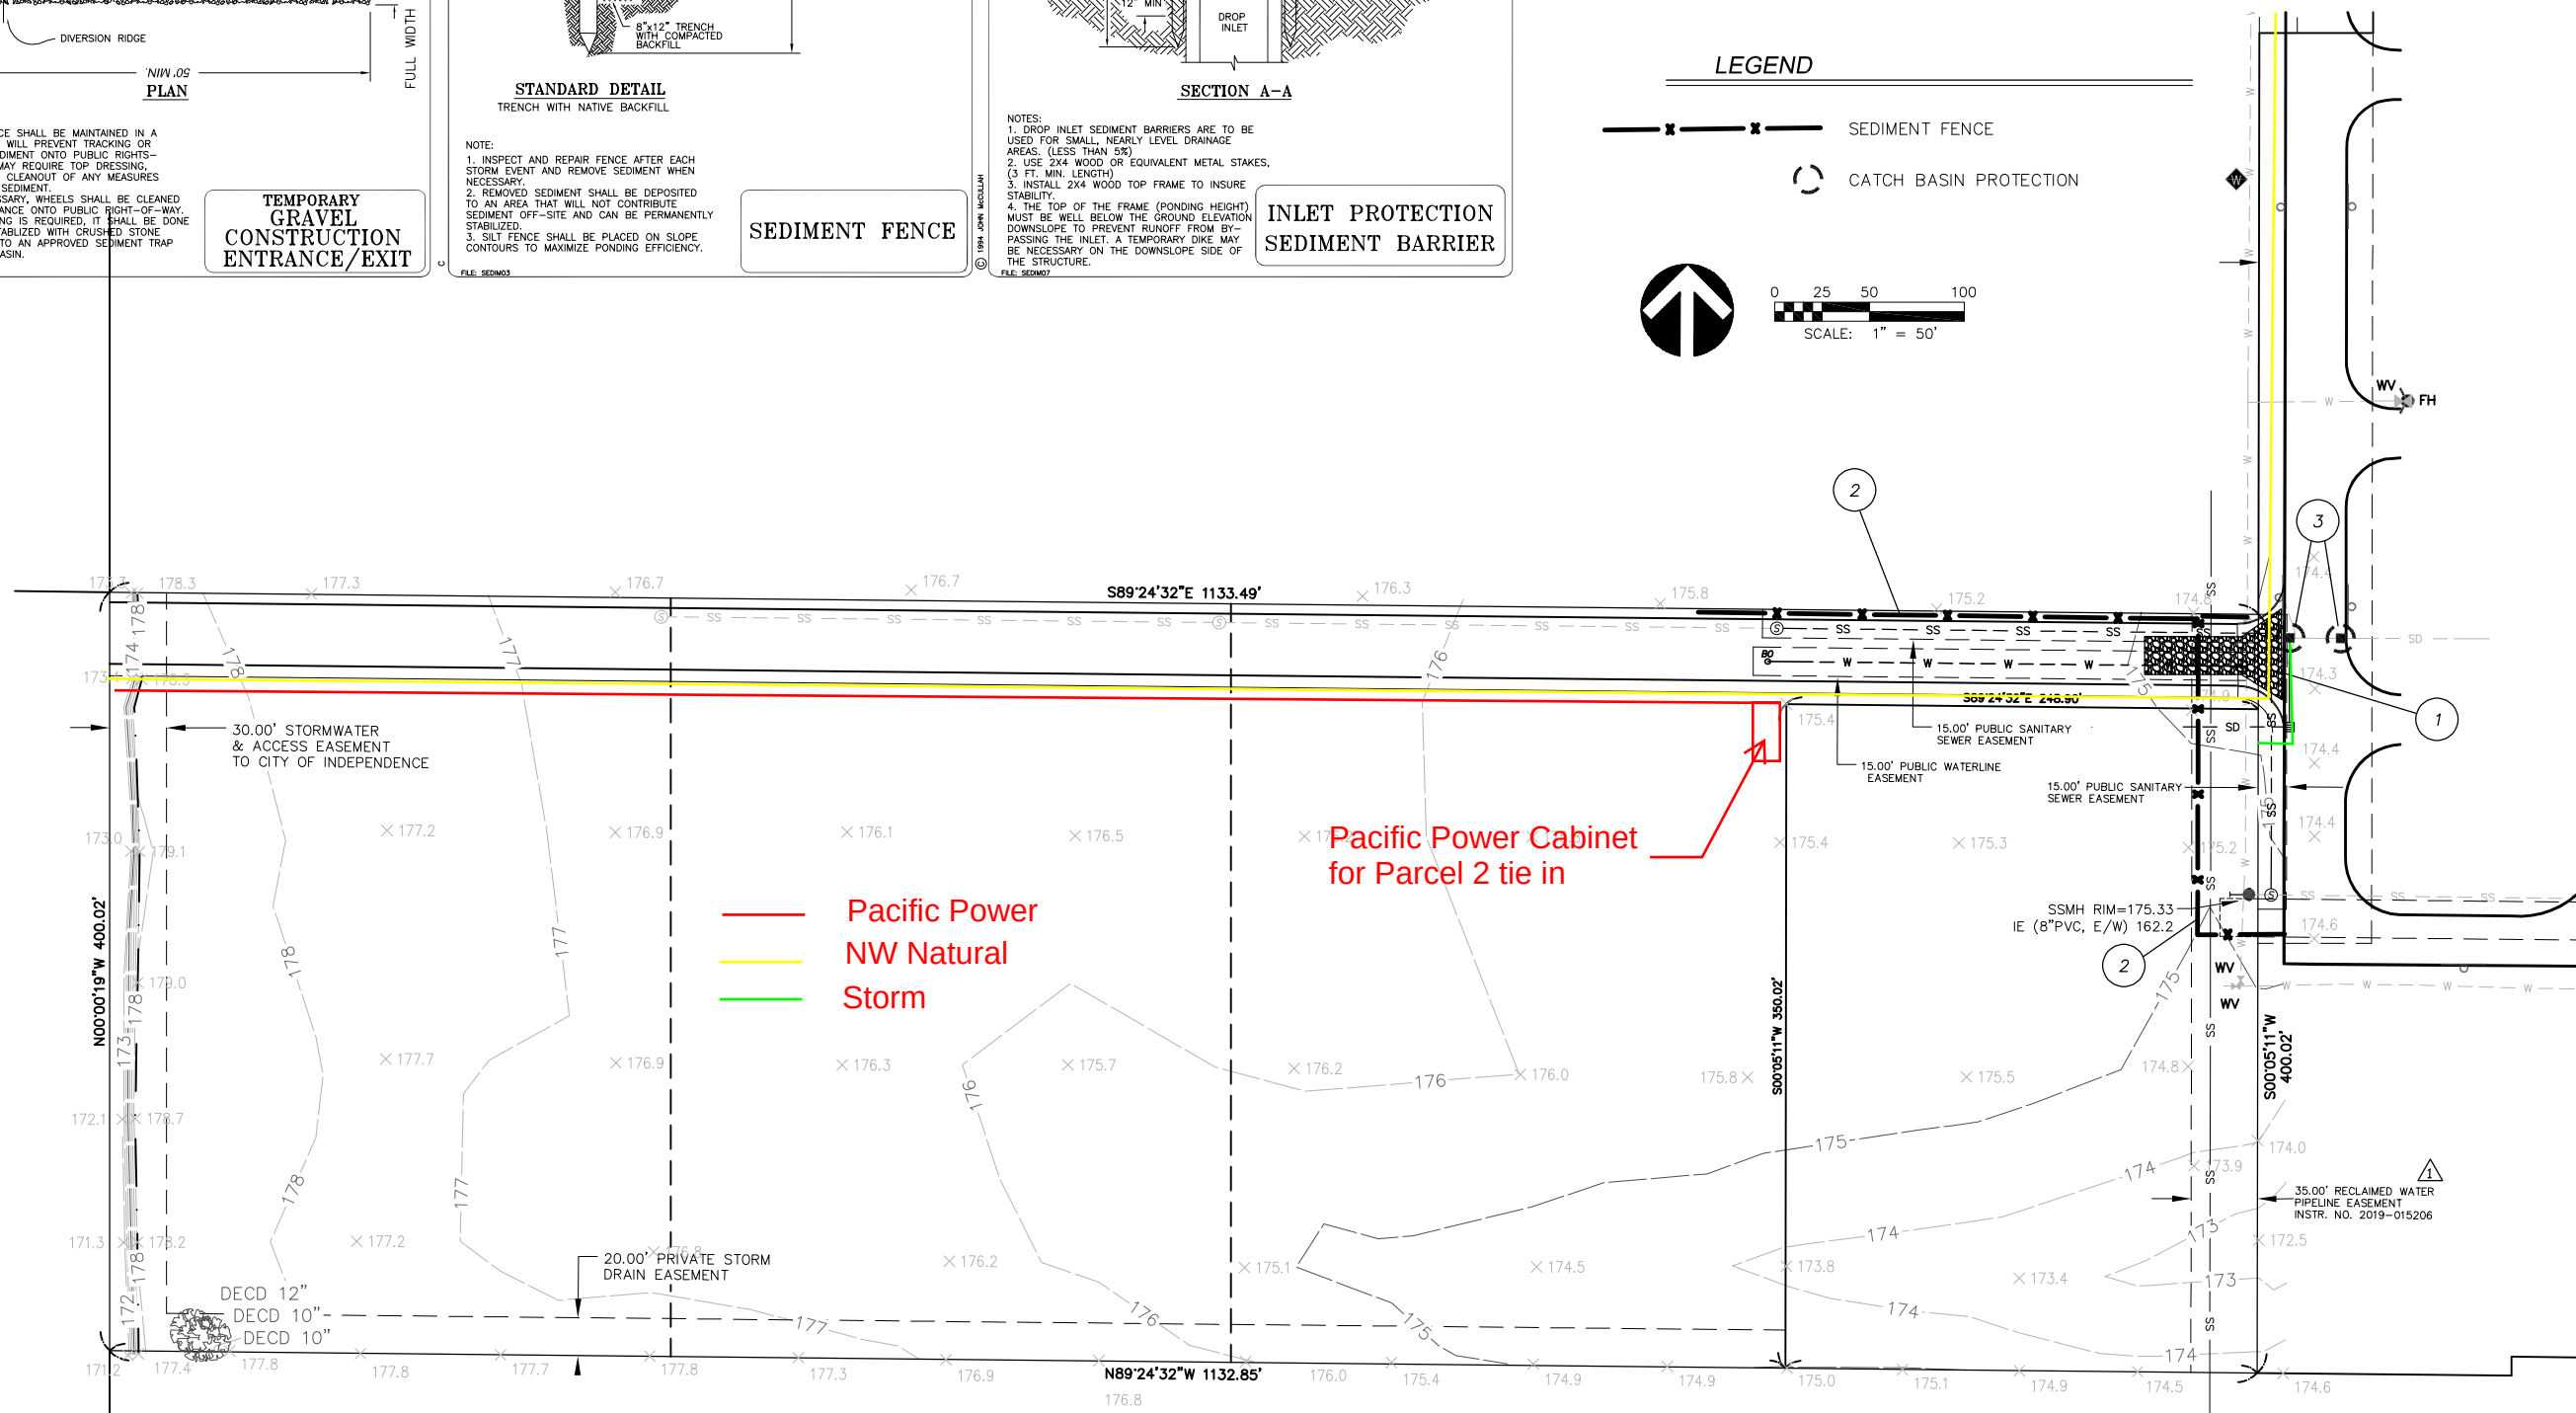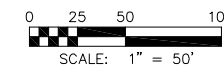

INDEPENDENCE INDUSTRIAL PARK
PHASE 1 DEVELOPMENT
EROSION AND SEDIMENTATION PLAN
WHITE OAK DEVELOPMENT
CITY OF INDEPENDENCE
POLK COUNTY

REV. NO.	DATE	DESCRIPTION
1	11/15/22	PER CITY REVIEW COMMENTS
2	12/14/22	PER CITY REVIEW COMMENTS

PROJECT NO.	WO 2022-1
DATE	10/13/2022
DRAWN	PAB
DESIGNED	PAB
CHECKED	

SHEET TITLE	CIVIL
SHEET NUMBER	