
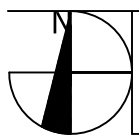


212 West Superstition Boulevard

Apache Junction . Arizona

Suite 101 - 2,986 SF

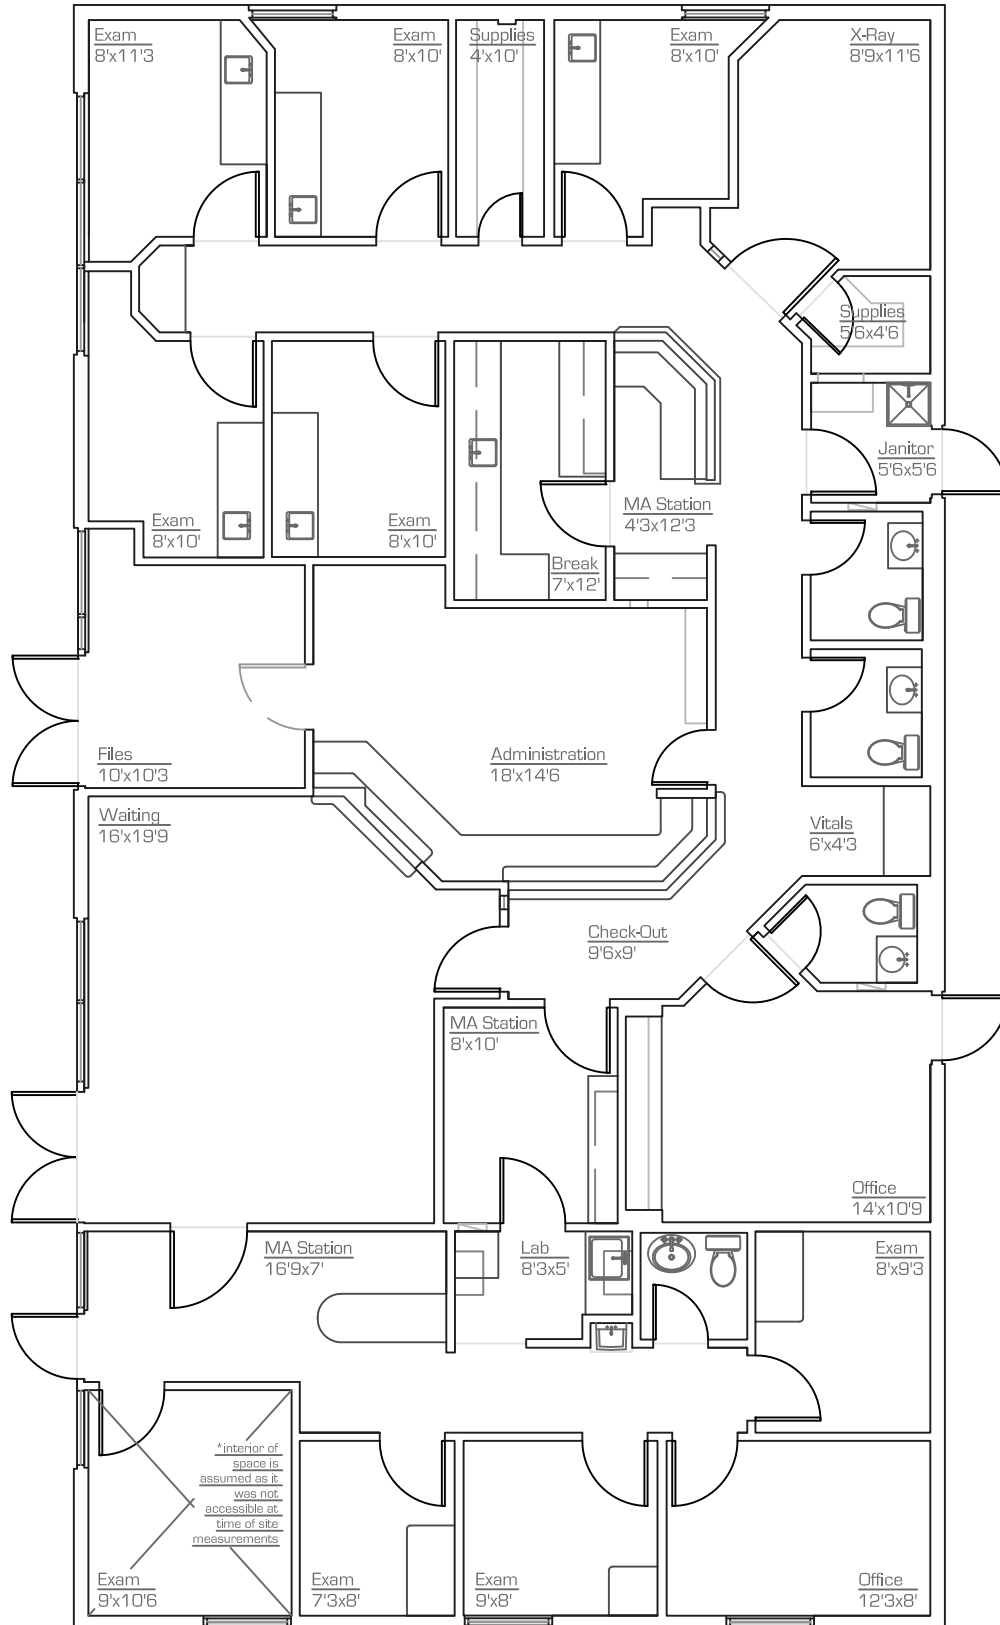

As-Built

scale: nts

8.June.2017

*All dimensions are approximate at ± 3"

*All information is of general nature

precision**DIMENSIONS**

as-built & design
602.790.6412

