


LEGEND
BY
SEP. 20, 2002
SHEETS 0700 TO
0705

RECORD DRAWING
SITE SIGNAGE AND PAVEMENT MARKING

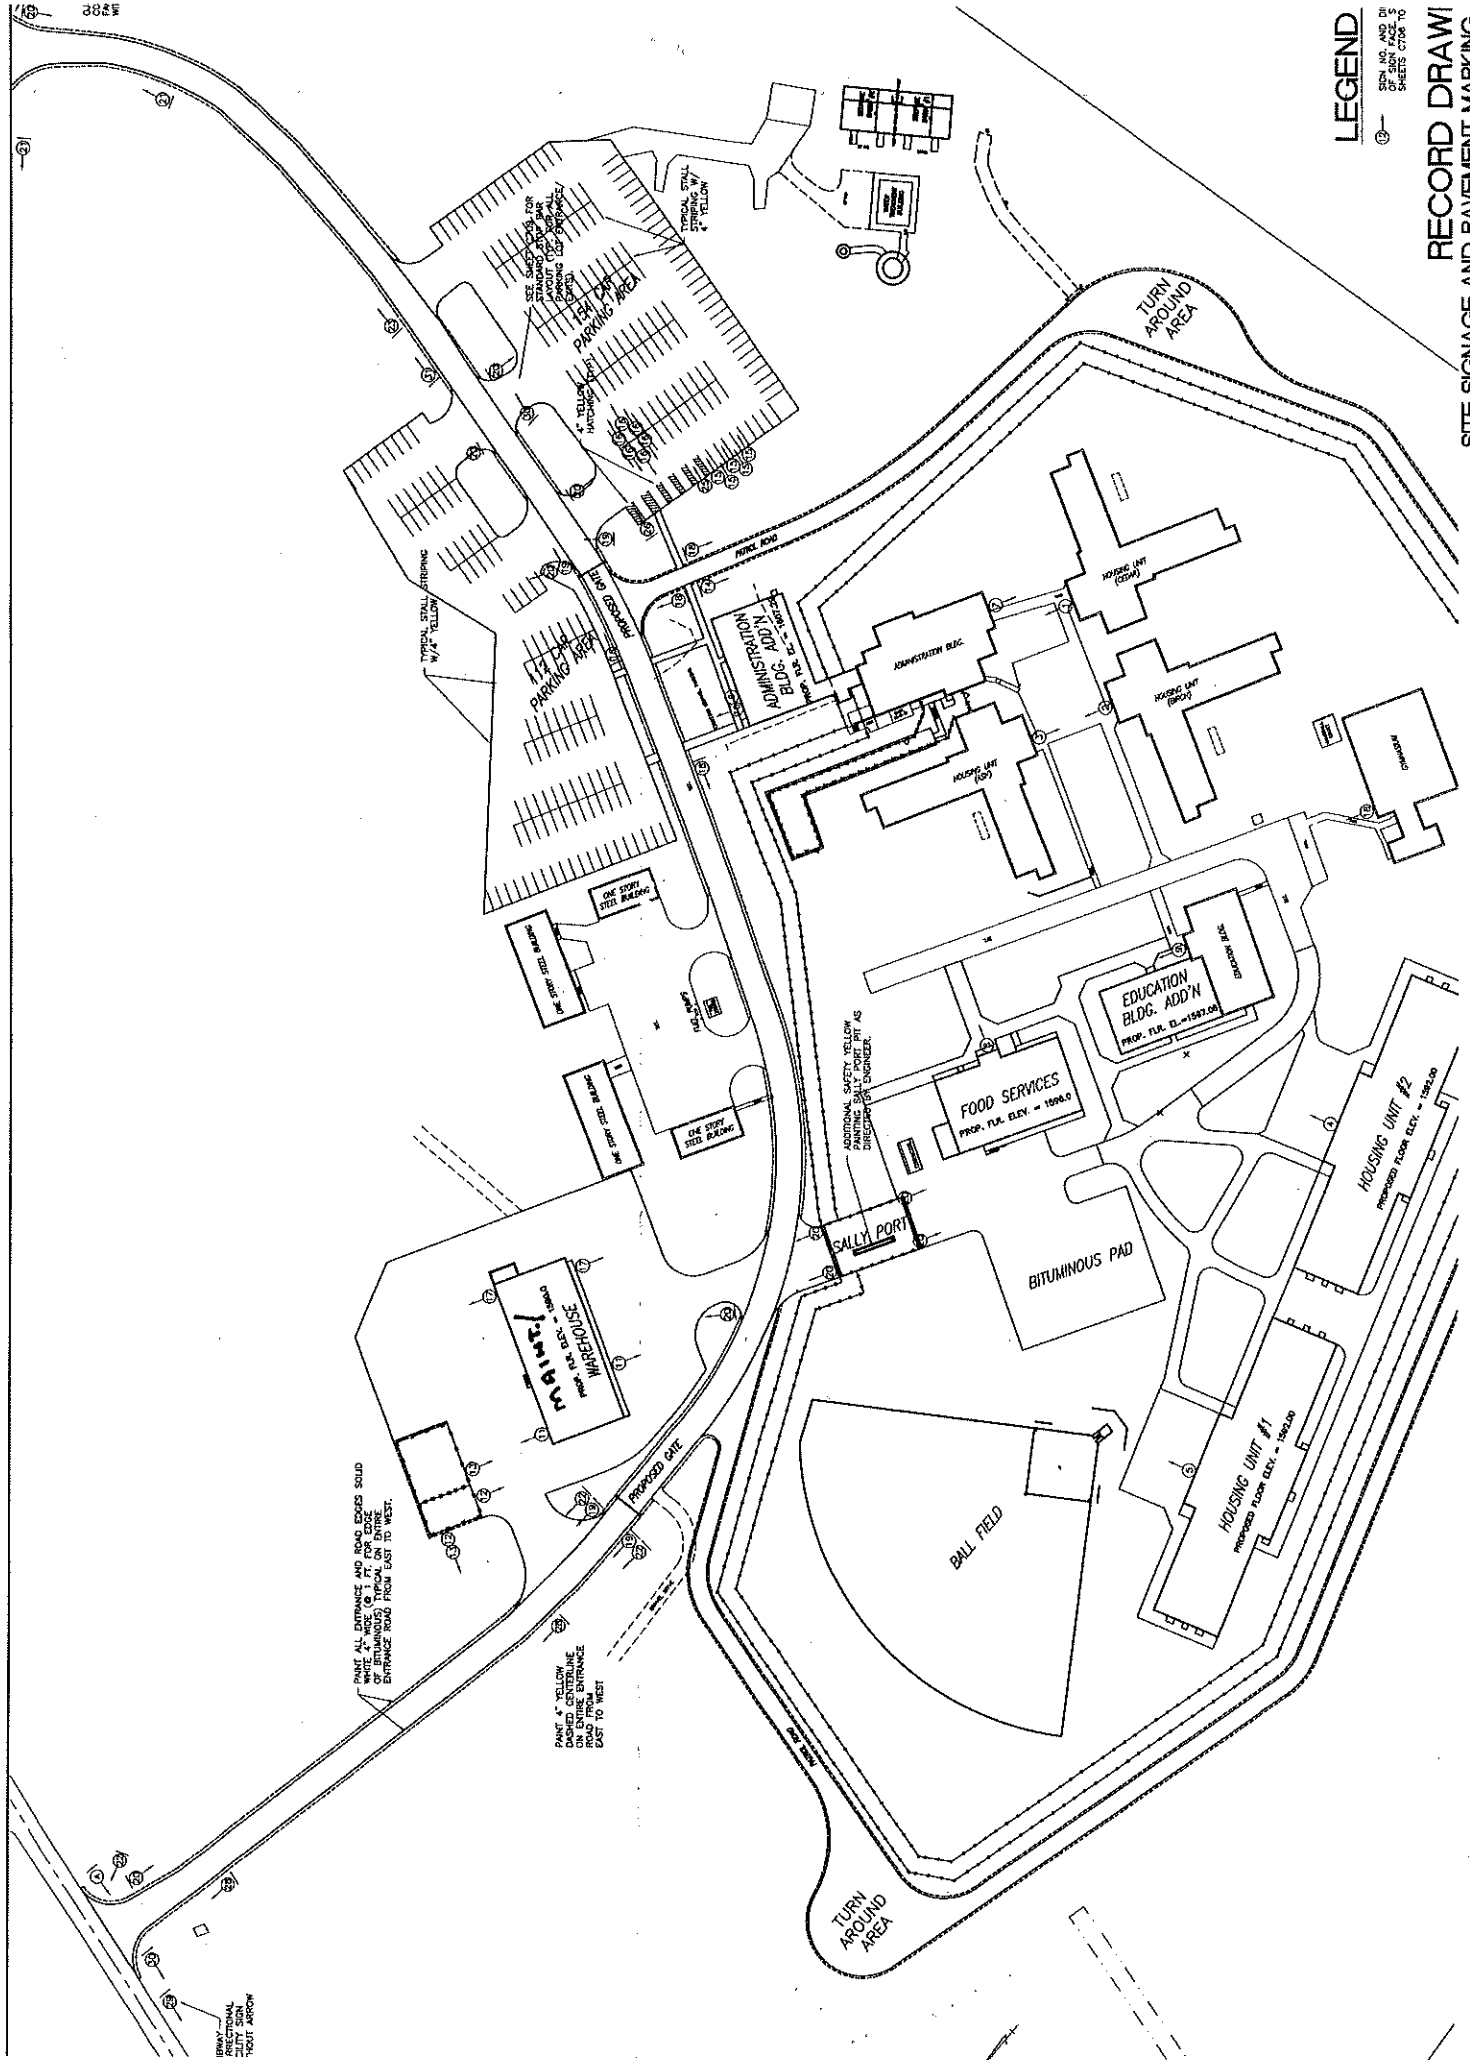

IRVING
ARCHITECTURAL
ENGINEERS
P.C.