



"AS BUILT" DRAWING
MEASURED BY MR LLC

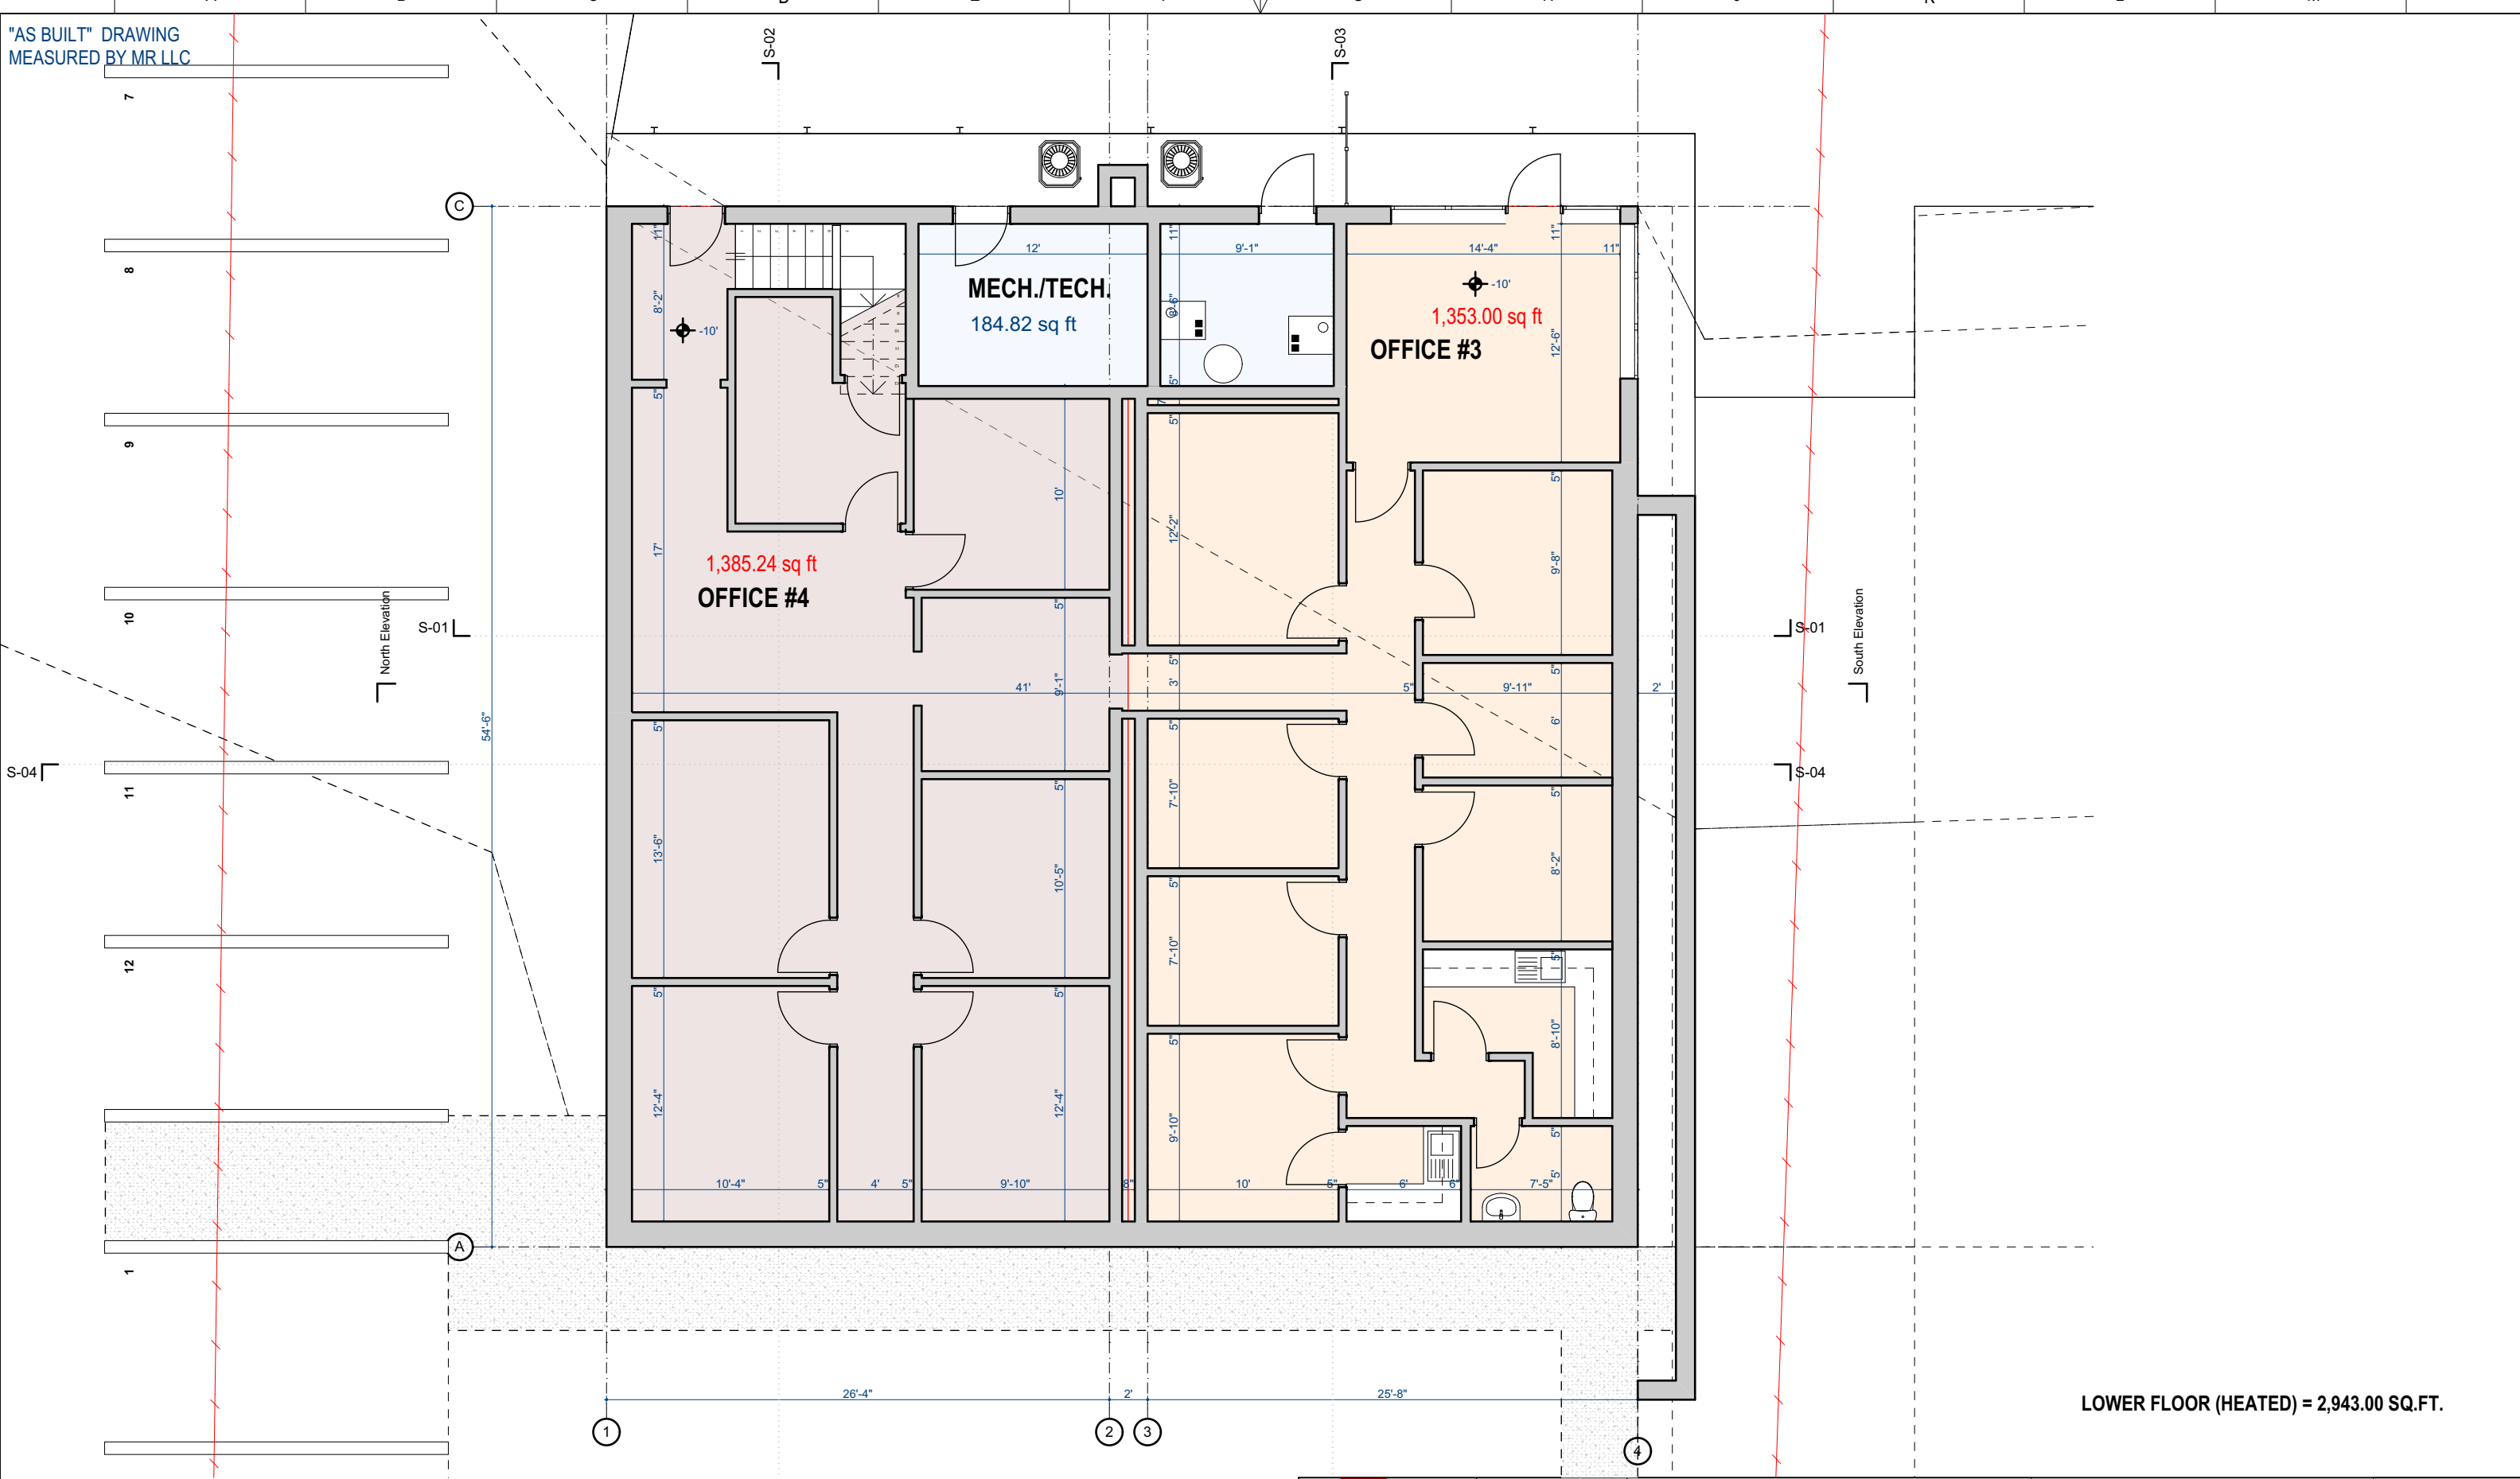

LOWER FLOOR (HEATED) = 2,943.00 SQ.FT.

NOTE:
 1. DO NOT USE AS BLUEPRINTS WITHOUT MR LLC PERMISSION.
 2. PLEASE NOTE INTERIOR DIMENSIONS WERE NOT USED IN CALCULATING SQUARE FOOTAGE
 3. SIZE OF HEATED AND NOT HEATED AREA AND OTHER INFORMATION WERE OBTAINED PER THE NC REAL ESTATE COMMISSION GUIDELINES
 4. FOR REMODELING QUESTIONS OR MORE DETAILED CAD DRAWINGS (INC. SITE PLAN, SECTIONS, ELEVATIONS) ALSO 3D MODEL PLEASE CONTACT ALFRED ZALYS MOB. 828 231 7305 E-MAIL: A.ZALYS@HOTMAIL.COM

LEGEND MAP:

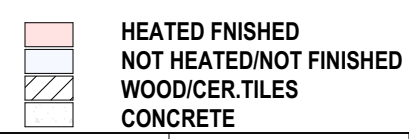

MEASURE RITE LLC
 Robert West
 mob.828.691.9378,
 e-mail: west1946@att.net
 Alfred Zalys
 mob.828.231.7305,
 e-mail: a.zalys@hotmail.com
 PO Box 15671 Asheville NC 28813
 EIN #81-4072168 TCCU BANK

Client: **Amy K Edwards:**
512 789 6522
 Full Address
**573 Merrimon Ave . Asheville
 NC-28804 Buncombe County**

Drawing Name LOWER LEVEL		Drawing Scale 1/8" = 1'-0"	
Contact Name Alfred ZALYS MR 452		Date 4/30/2019	Layout Nr. 3
Job Nr. MR 452		Lays Total 5	Paper Size Ledger B