

Northside Roswell Medical Office Building

11685 Alpharetta Highway, Roswell, GA


Suite 265 – 2,085 RSF




NORTHSIDE HOSPITAL

SUITE: 265
2,085 RSF

AS-BUILT FLOOR PLAN

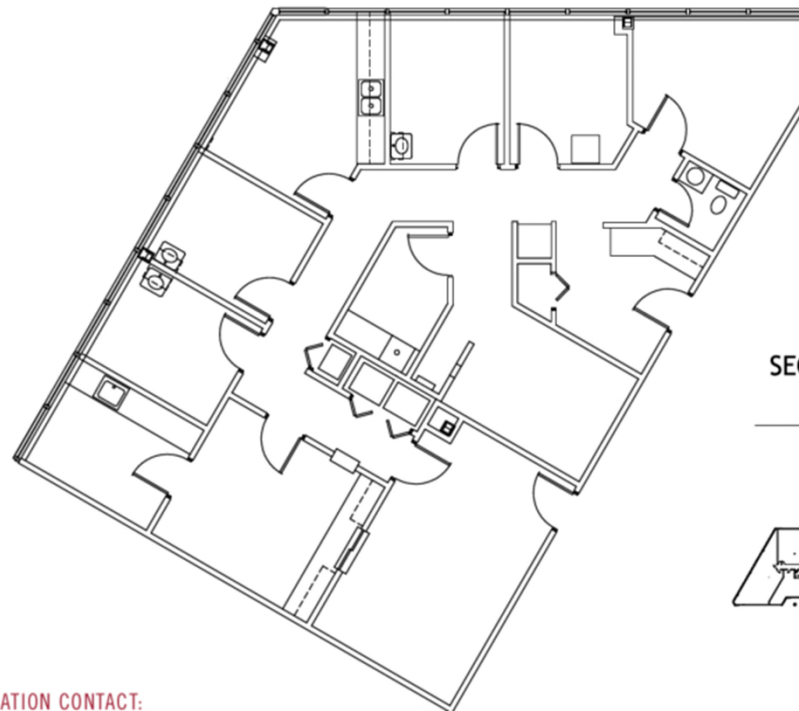

SECOND FLOOR
OF
THREE

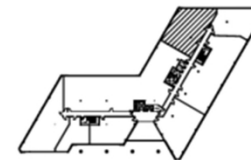

FOR MORE INFORMATION CONTACT:

Hunter Keith

RTG – (404)372-8222