



Use of these plans and specifications shall be restricted to the original site for which they were prepared and publication thereof is expressly limited to such use. Reproduction or publication by any method, in whole or in part, is prohibited. Title to the plans and specifications remains with the architect without prejudice. Visual contact with these plans and specifications shall constitute prima facie evidence of the acceptance of these restrictions.

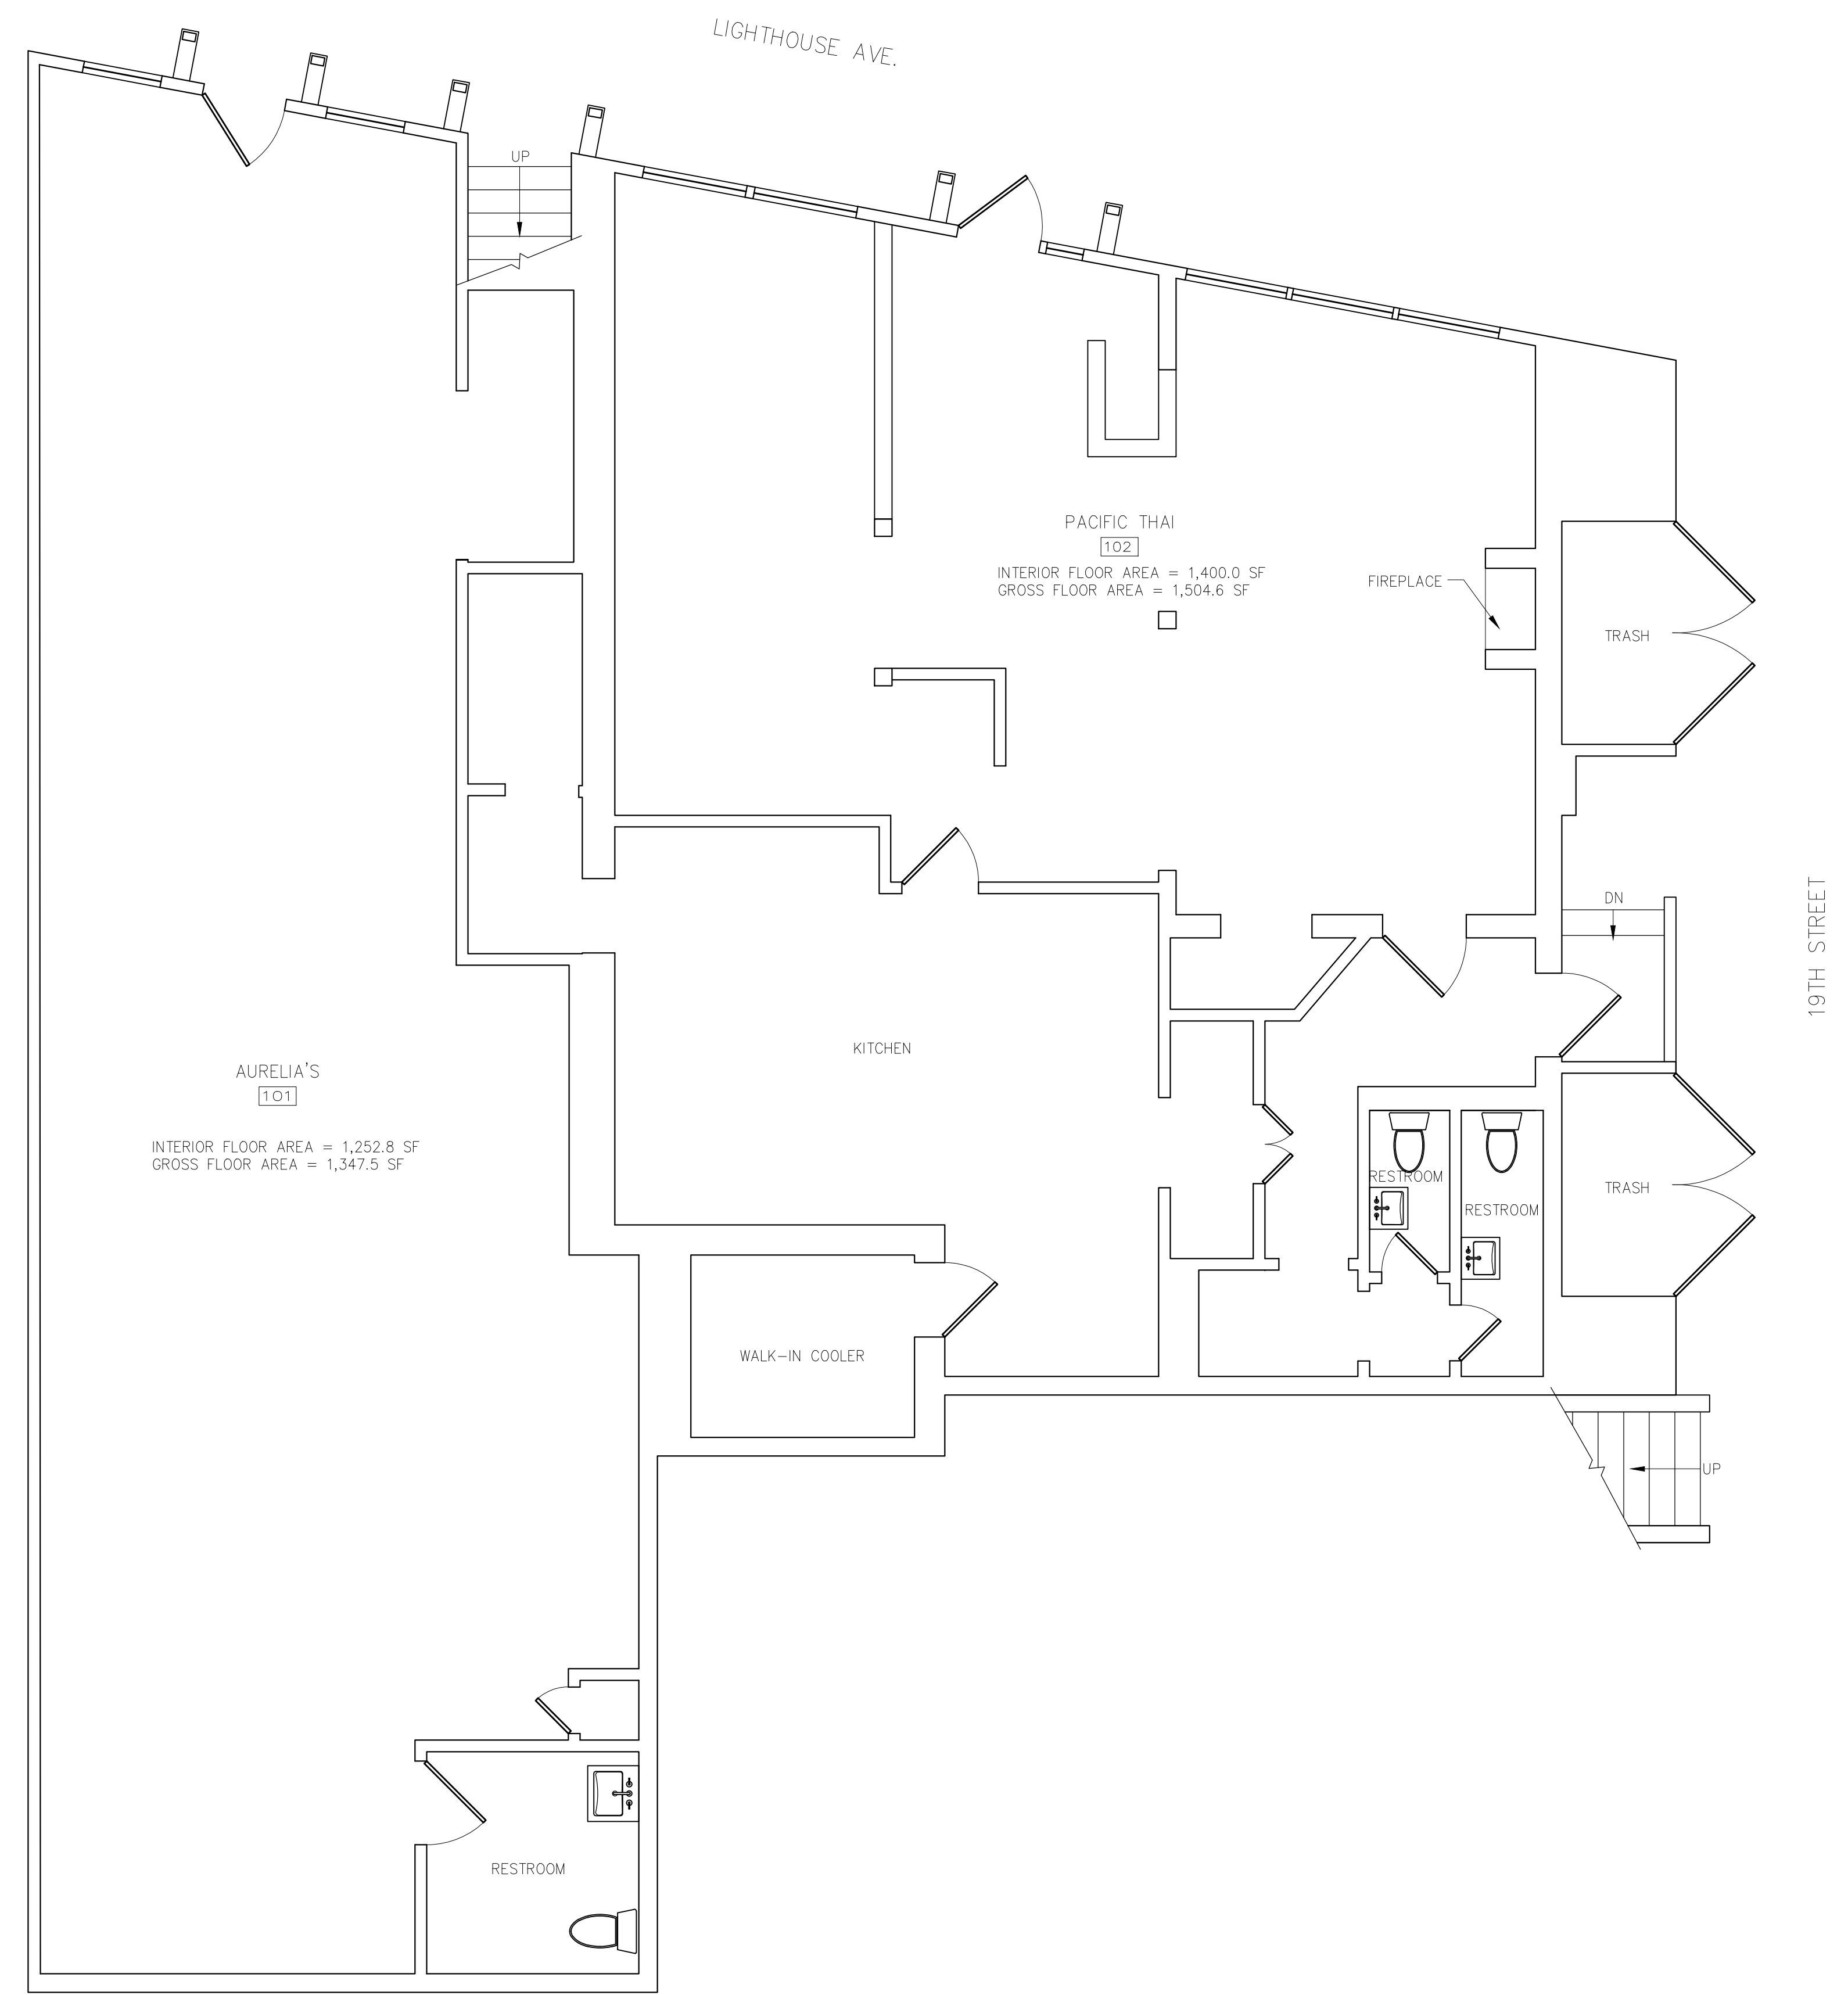

1 EXISTING FIRST FLOOR PLAN
SCALE: 1/4"=1'-0"

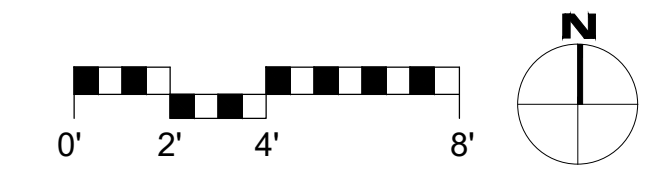

NOT FOR CONSTRUCTION

**BAIN
BUILDING
AS-BUILTS**
661-665 LIGHTHOUSE
PACIFIC GROVE, CA
93950


SAMUEL PITNICK ARCHITECTS
P.O. BOX 22412, CARMEL, CA 93922
PHONE: (831) 241-1895
EMAIL: SAMUEL@PITNICK.COM

REVISIONS	DATE


ARCHITECTURAL
EXISTING
FIRST FLOOR
PLAN
Scale: SEE DWG.
Drawn By: SBP
Job: -

A1.0
10/29/2018

Use of these plans and specifications shall be restricted to the original site for which they were prepared and publication thereof is expressly limited to such use. Reproduction or publication by any method, in whole or in part, is prohibited. Title to the plans and specifications remains with the architect without prejudice. Visual contact with these plans and specifications shall constitute prima facie evidence of the acceptance of these restrictions.

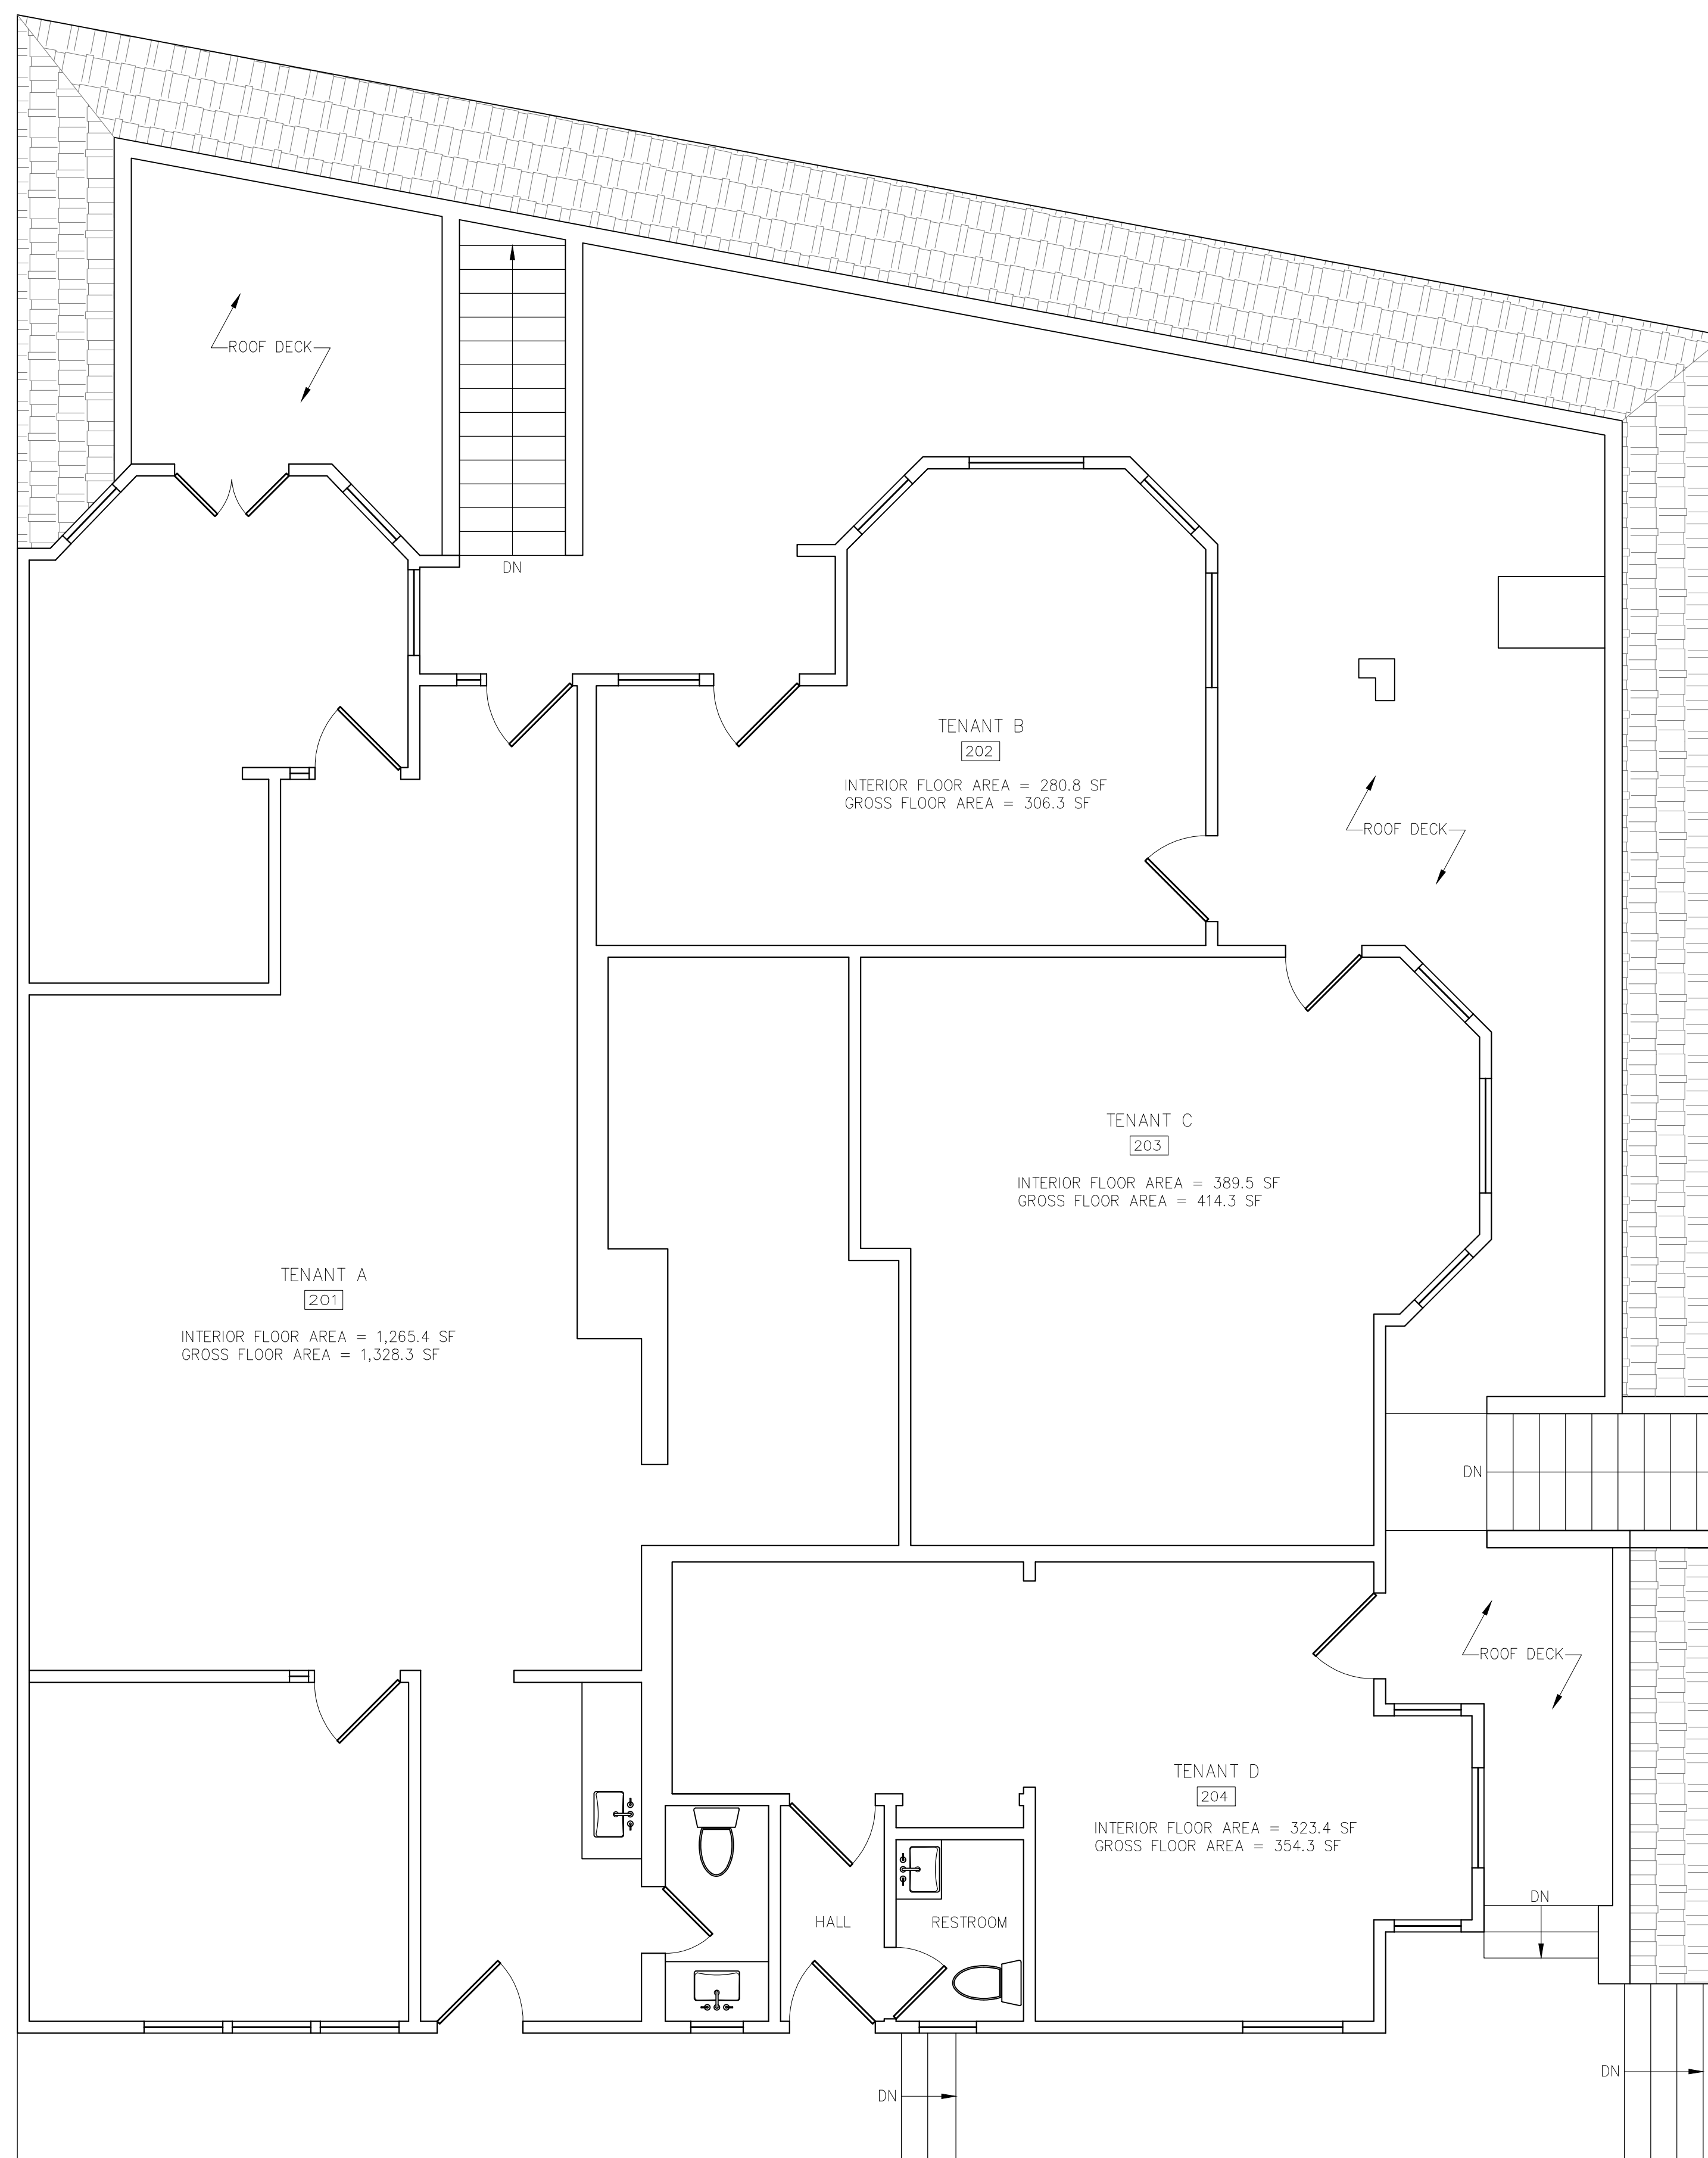

1 EXISTING SECOND FLOOR PLAN
SCALE: 1/4"=1'-0"

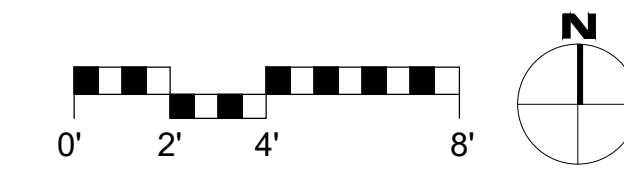

NOT FOR CONSTRUCTION

BAIN BUILDING AS-BUILTS
661-665 LIGHTHOUSE
PACIFIC GROVE, CA 93950

SAMUEL PITNICK ARCHITECTS
P.O. BOX 22412, CARMEL, CA 93922
PHONE: (831) 241-1895
EMAIL: SAMUEL@PITNICK.COM

REVISIONS	DATE

ARCHITECTURAL

EXISTING SECOND FLOOR PLAN

Scale: SEE DWG.
Drawn By: SBP
Job: -

A2.0
10/29/2018