


J. DANIEL LOPEZ  
 ARCHITECT  
 TEXAS REG. #25949

INCOMPLETE DRAWING  
 NOT FOR REGULATORY  
 APPROVAL, PERMIT OR  
 CONSTRUCTION

12/16/2025

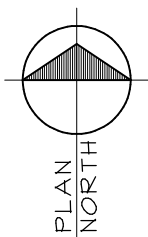

**114 MESA PARK, STE. 100**  
**EXISTING CONDITIONS**

NOTE: FIELD VERIFY CONDITIONS

1/8" = 1'-0"