
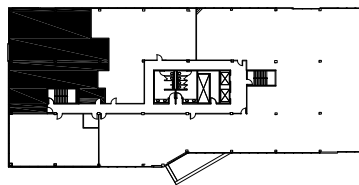


GRAYMARK OFFICE BUILDING

16801 Addison Rd., Addison, Texas

SUITE 425
3,380 RSF

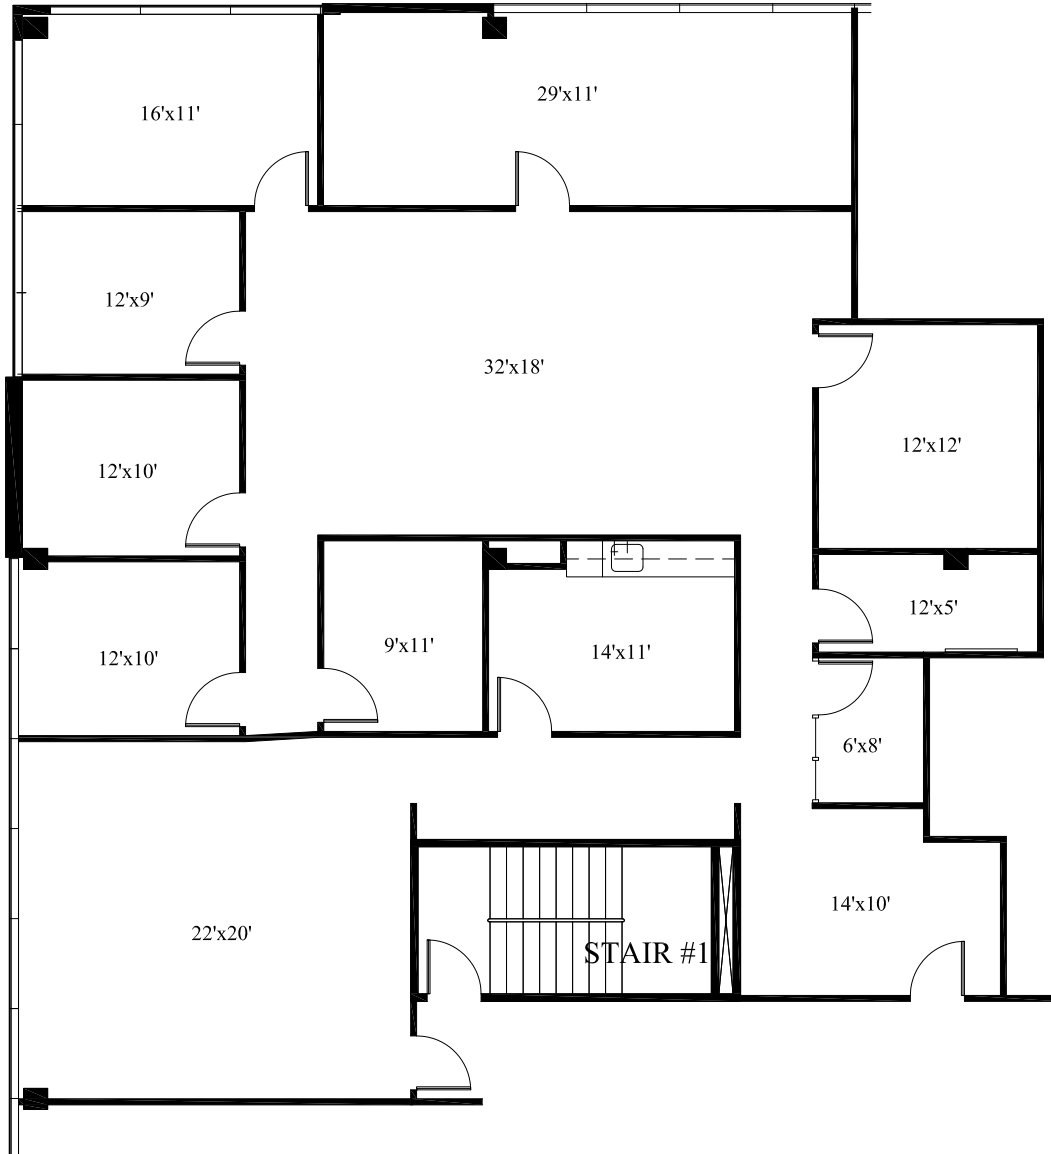

4TH FLOOR

Scale: 3/32"=1'-0"

All dimensions and square footages are approximate.

November 6, 2019

