
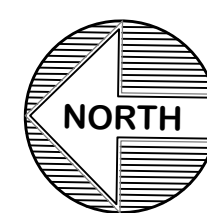


1
A1.0

MAIN FLR ASBUILT FLOOR PLAN

3/32" = 1'-0"

GROSS AREAS			
	MAIN FLOOR	MEZZANINE	TOTAL
COMMON	2,439 SF	162 SF	2,601 SF
WILD WONDER CO-OP	701 SF	1,577 SF	2,278 SF
AZLE COC	746 SF	-	746 SF
TEXAS DRIP COFFEE SHOP	1,315 SF	937 SF	2,252 SF
ROCK BOTTOM SURPLUS	5,477 SF	-	5,477 SF
LONGHORN FITNESS	6,070 SF	151 SF	6,221 SF
KITCHEN	1,356 SF	-	1,356 SF
EVENT / CONVENTION AREA	14,282 SF	-	14,282 SF
VACANT	-	534 SF	534 SF
CHURCH	-	1,782 SF	1,782 SF
TOTAL	32,386 SF	5,143 SF	37,529 SF

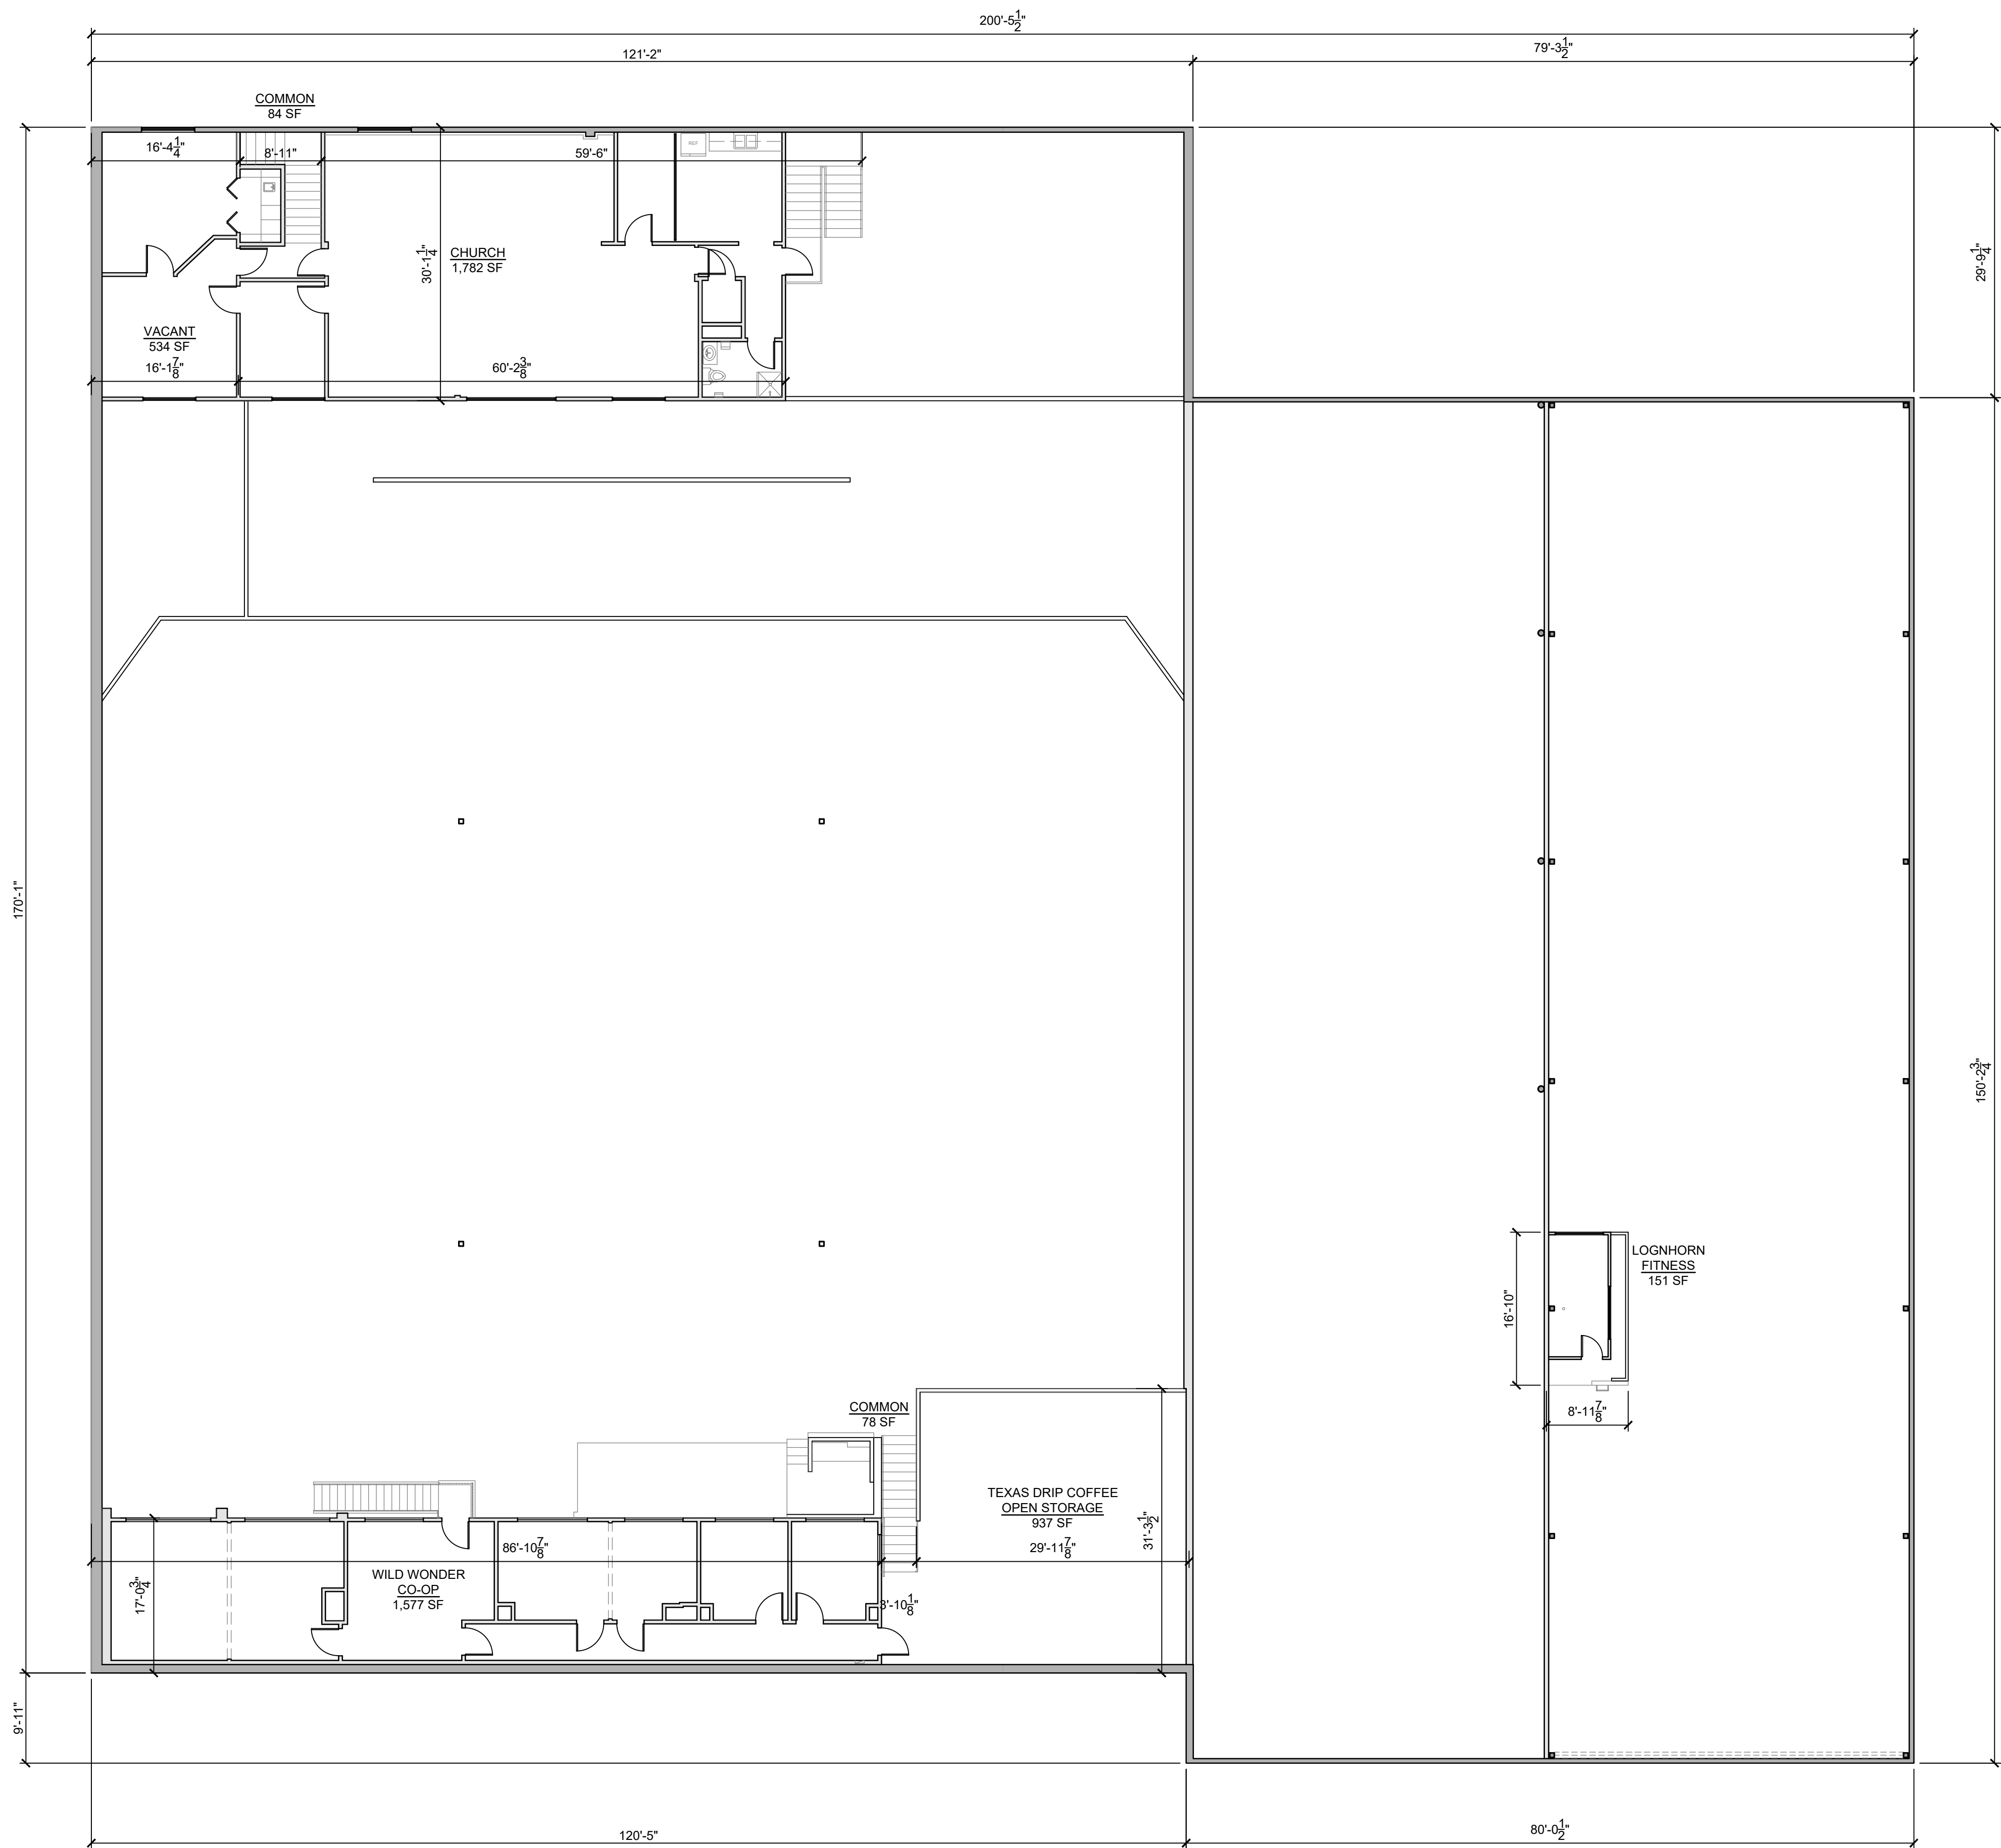


1
A1.1

2ND FLR ASBUILT FLOOR PLAN - 4,690 SF

3/32" = 1'-0"

GROSS AREAS			
	MAIN FLOOR	MEZZANINE	TOTAL
COMMON	2,439 SF	162 SF	2,601 SF
WILD WONDER CO-OP	701 SF	1,577 SF	2,278 SF
AZLE COC	746 SF	-	746 SF
TEXAS DRIP COFFEE SHOP	1,315 SF	937 SF	2,252 SF
ROCK BOTTOM SURPLUS	5,477 SF	-	5,477 SF
LONGHORN FITNESS	6,070 SF	151 SF	6,221 SF
KITCHEN	1,356 SF	-	1,356 SF
EVENT / CONVENTION AREA	14,282 SF	-	14,282 SF
VACANT	-	534 SF	534 SF
CHURCH	-	1,782 SF	1,782 SF
TOTAL	32,386 SF	5,143 SF	37,529 SF

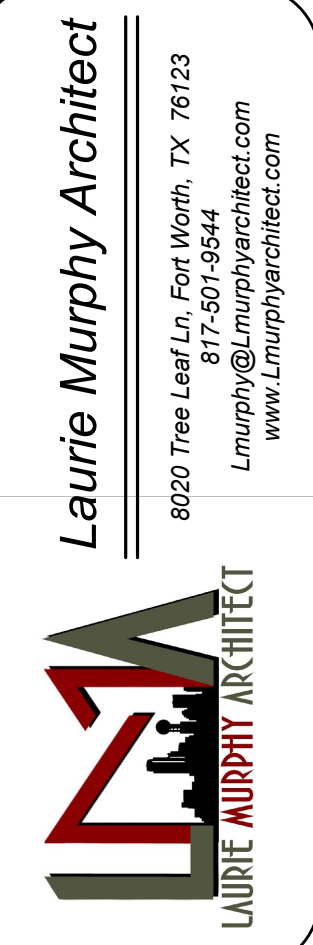


404 MAIN PLACE ASBUILT
 404 W MAIN STREET
 AZLE, TEXAS 76020

Revisions:

Project Name:	404 MAIN AZLE
Project No.:	1485-000
Date:	11/19/2024
Drawn By:	LM
Checked By:	LM

SHEET
A1.1

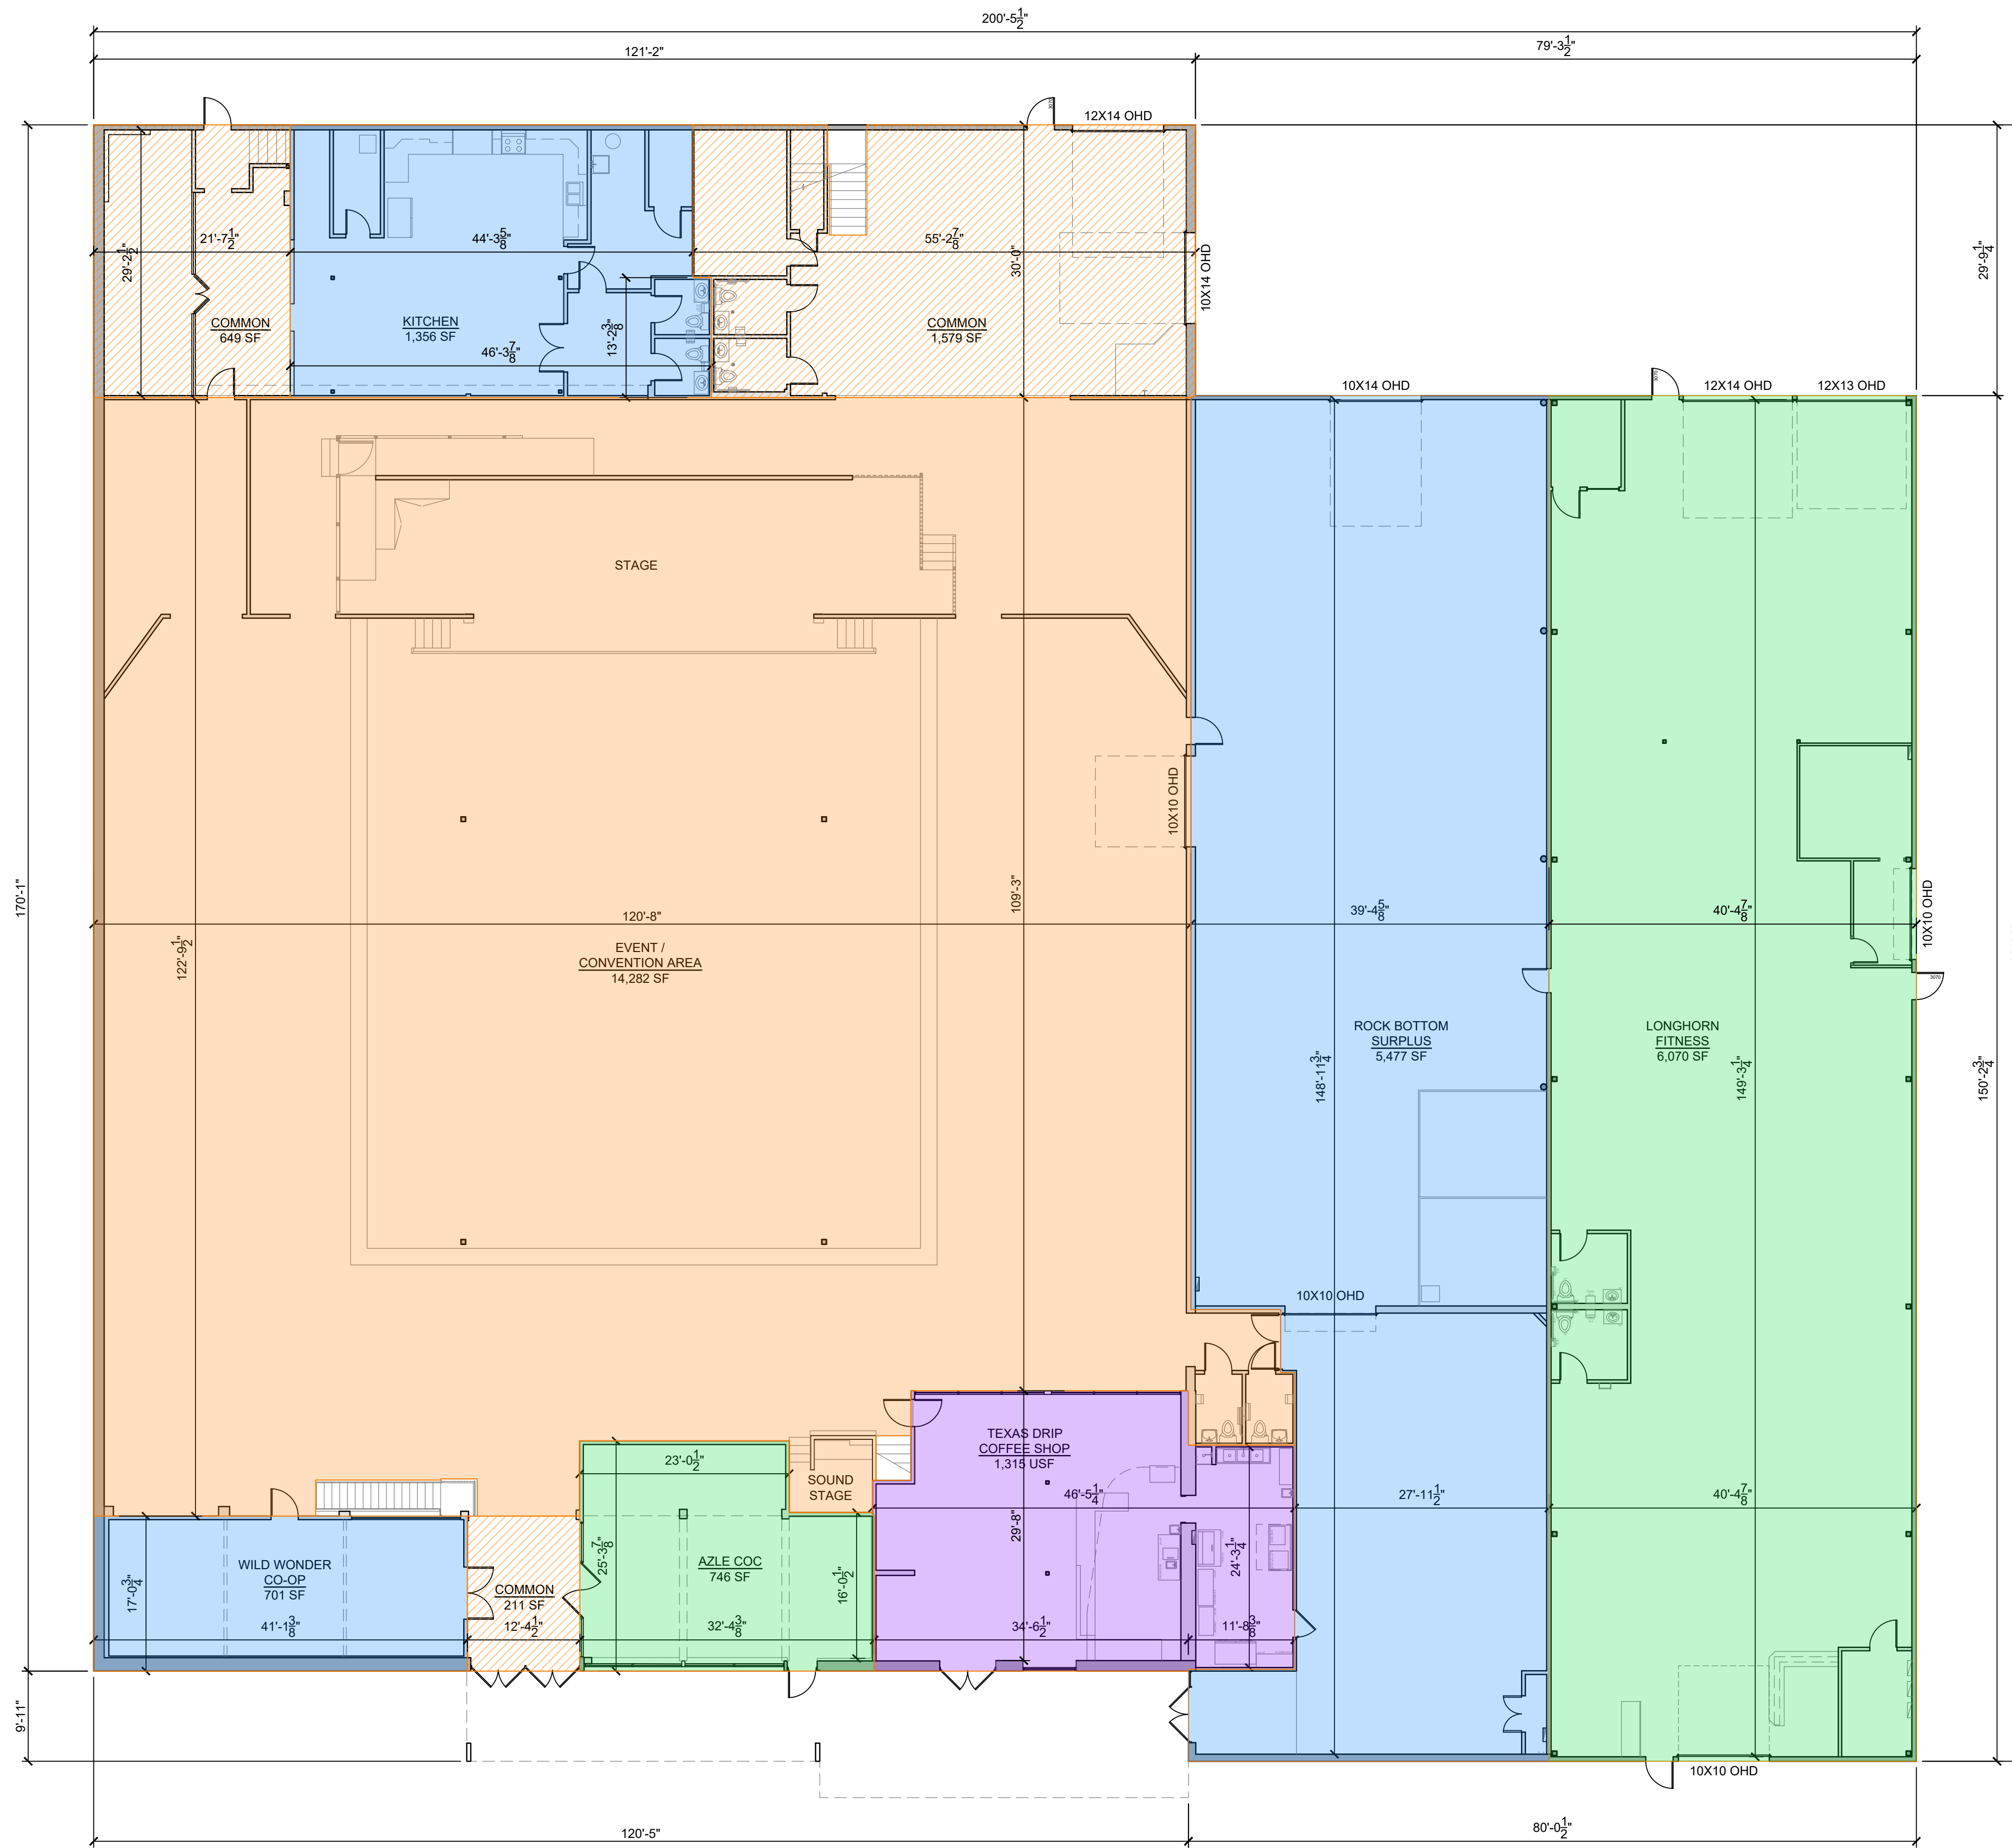


1 MAIN FLR ASBUILT FLOOR PLAN
A1.0 3/32" = 1'-0"

GROSS AREAS			
	MAIN FLOOR	MEZZANINE	TOTAL
COMMON	2,439 SF	162 SF	2,601 SF
WILD WONDER CO-OP	701 SF	1,577 SF	2,278 SF
AZLE COC	746 SF	-	746 SF
TEXAS DRIP COFFEE SHOP	1,315 SF	937 SF	2,252 SF
ROCK BOTTOM SURPLUS	5,477 SF	-	5,477 SF
LONGHORN FITNESS	6,070 SF	151 SF	6,221 SF
KITCHEN	1,356 SF	-	1,356 SF
EVENT / CONVENTION AREA	14,282 SF	-	14,282 SF
VACANT	-	534 SF	534 SF
CHURCH	-	1,782 SF	1,782 SF
TOTAL	32,386 SF	5,143 SF	37,529 SF


Revisions:

Project Name: 404 MAIN AZLE
Project No: 1485-000
Date: 11/19/2024
Drawn By: LM
Checked By: LM

SHEET
A1.0

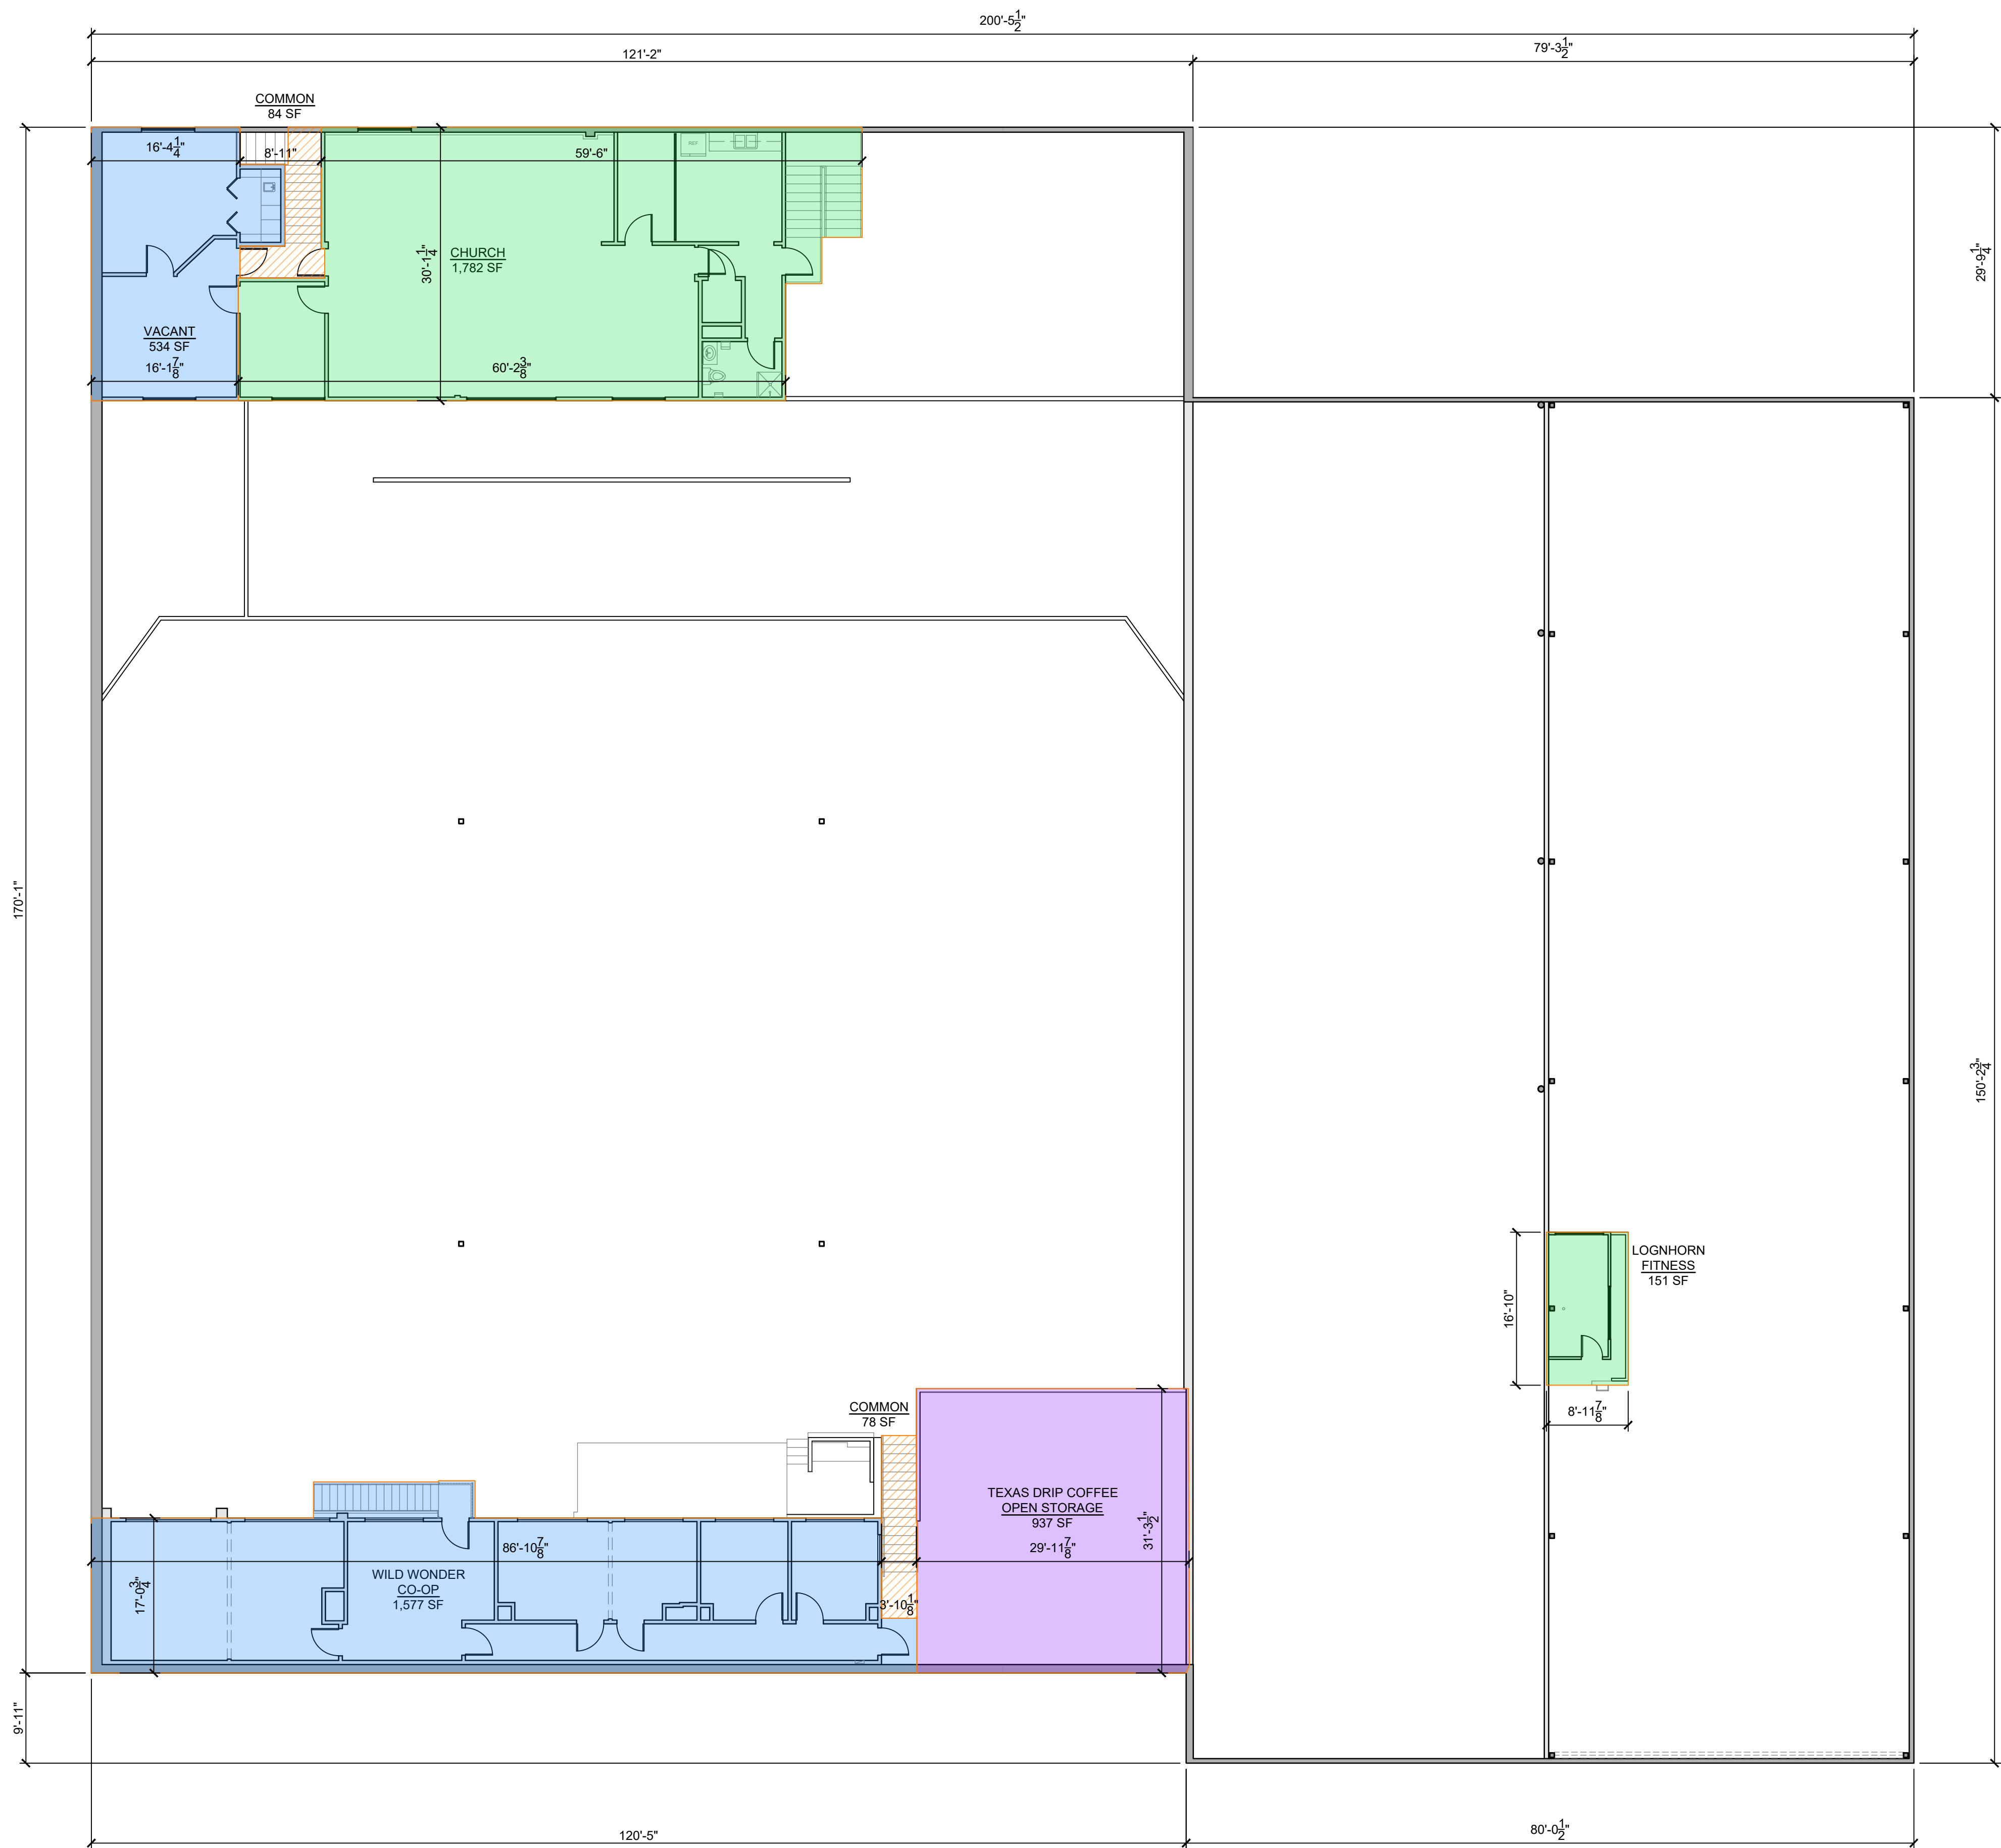

GROSS AREAS			
	MAIN FLOOR	MEZZANINE	TOTAL
COMMON	2,439 SF	162 SF	2,601 SF
WILD WONDER CO-OP	701 SF	1,577 SF	2,278 SF
AZLE COC	746 SF	-	746 SF
TEXAS DRIP COFFEE SHOP	1,315 SF	937 SF	2,252 SF
ROCK BOTTOM SURPLUS	5,477 SF	-	5,477 SF
LONGHORN FITNESS	6,070 SF	151 SF	6,221 SF
KITCHEN	1,356 SF	-	1,356 SF
EVENT / CONVENTION AREA	14,282 SF	-	14,282 SF
VACANT	-	534 SF	534 SF
CHURCH	-	1,782 SF	1,782 SF
TOTAL	32,386 SF	5,143 SF	37,529 SF

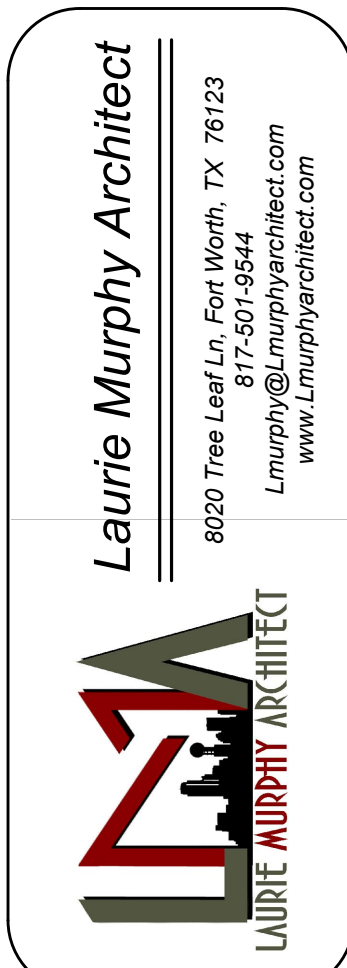

404 MAIN PLACE ASBUILT
 404 W MAIN STREET
 AZLE, TEXAS 76020

Revisions:

Project Name: 404 MAIN AZLE
 Project No: 1465-000
 Date: 11/19/2024
 Drawn By: LM
 Checked By: LM

SHEET
A1.1