


LAKE SHORE

18101 VON KARMAN AVENUE

15th floor

"AVAILABLE"
SUITE 1500 | 23,194 RSF

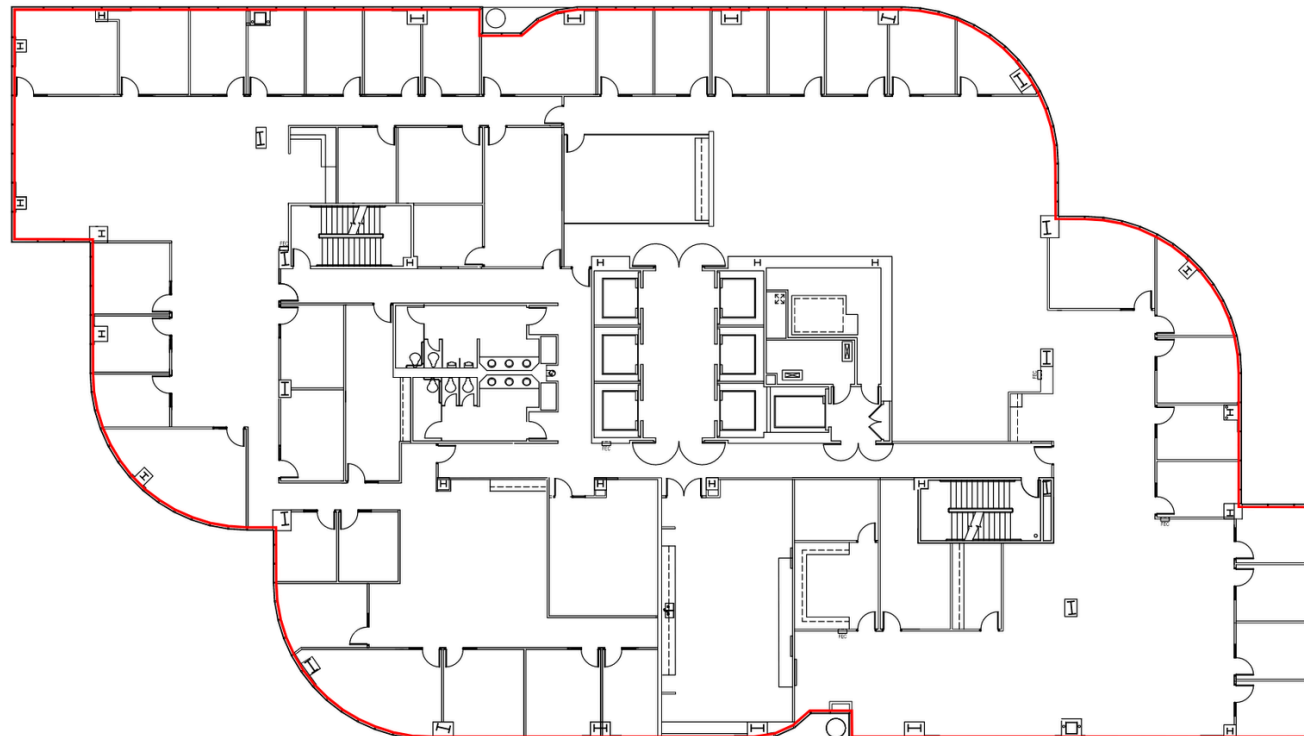


405 FREEWAY

AIRPORT



SCALE: N.T.S.



 SENTRE

REVISED: 1/17/26