

Monroe Business Park
10031 Monroe Drive

Suite 106
 Dallas, Texas 75229

Sheet **A4**
 Of 15 Sheet(s)



Scale: Not to Scale
 Sheet Size: 11" x 8.5"
 Not For Construction


© 2025 HosScans, LLC.
 All right reserved.
 These drawings and any associated documents are protected under U.S. copyright law. No part of this work may be produced, distributed, or used in any form, by any method, for any purpose, without the prior written consent of HosScans, LLC. Unauthorized use is subject to legal action.

Usable Square Foot Analysis

	SQFT	BUILDING PERCENTAGE
OFFICE AREA:	760	32%
WAREHOUSE AREA:	1,612	68%
TOTAL AREA:	2,372	

Building Information

Deck Height:	20'0"
Clear Height:	18'0"
Ceiling Height:	9'0"
Sprinklered:	No
Mechanical Area:	N/A

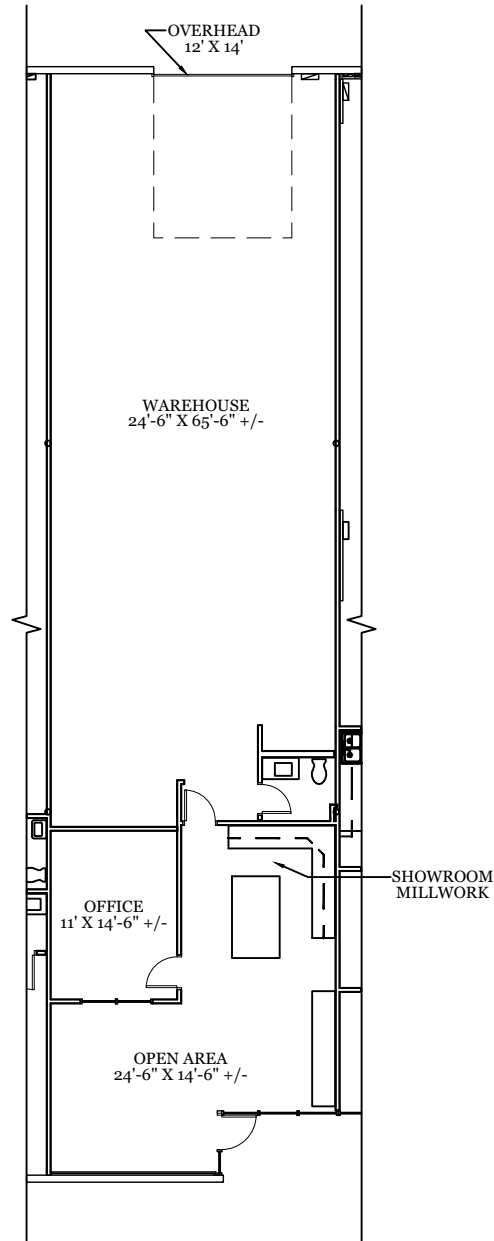

As Built Floor Plan for Marketing

