


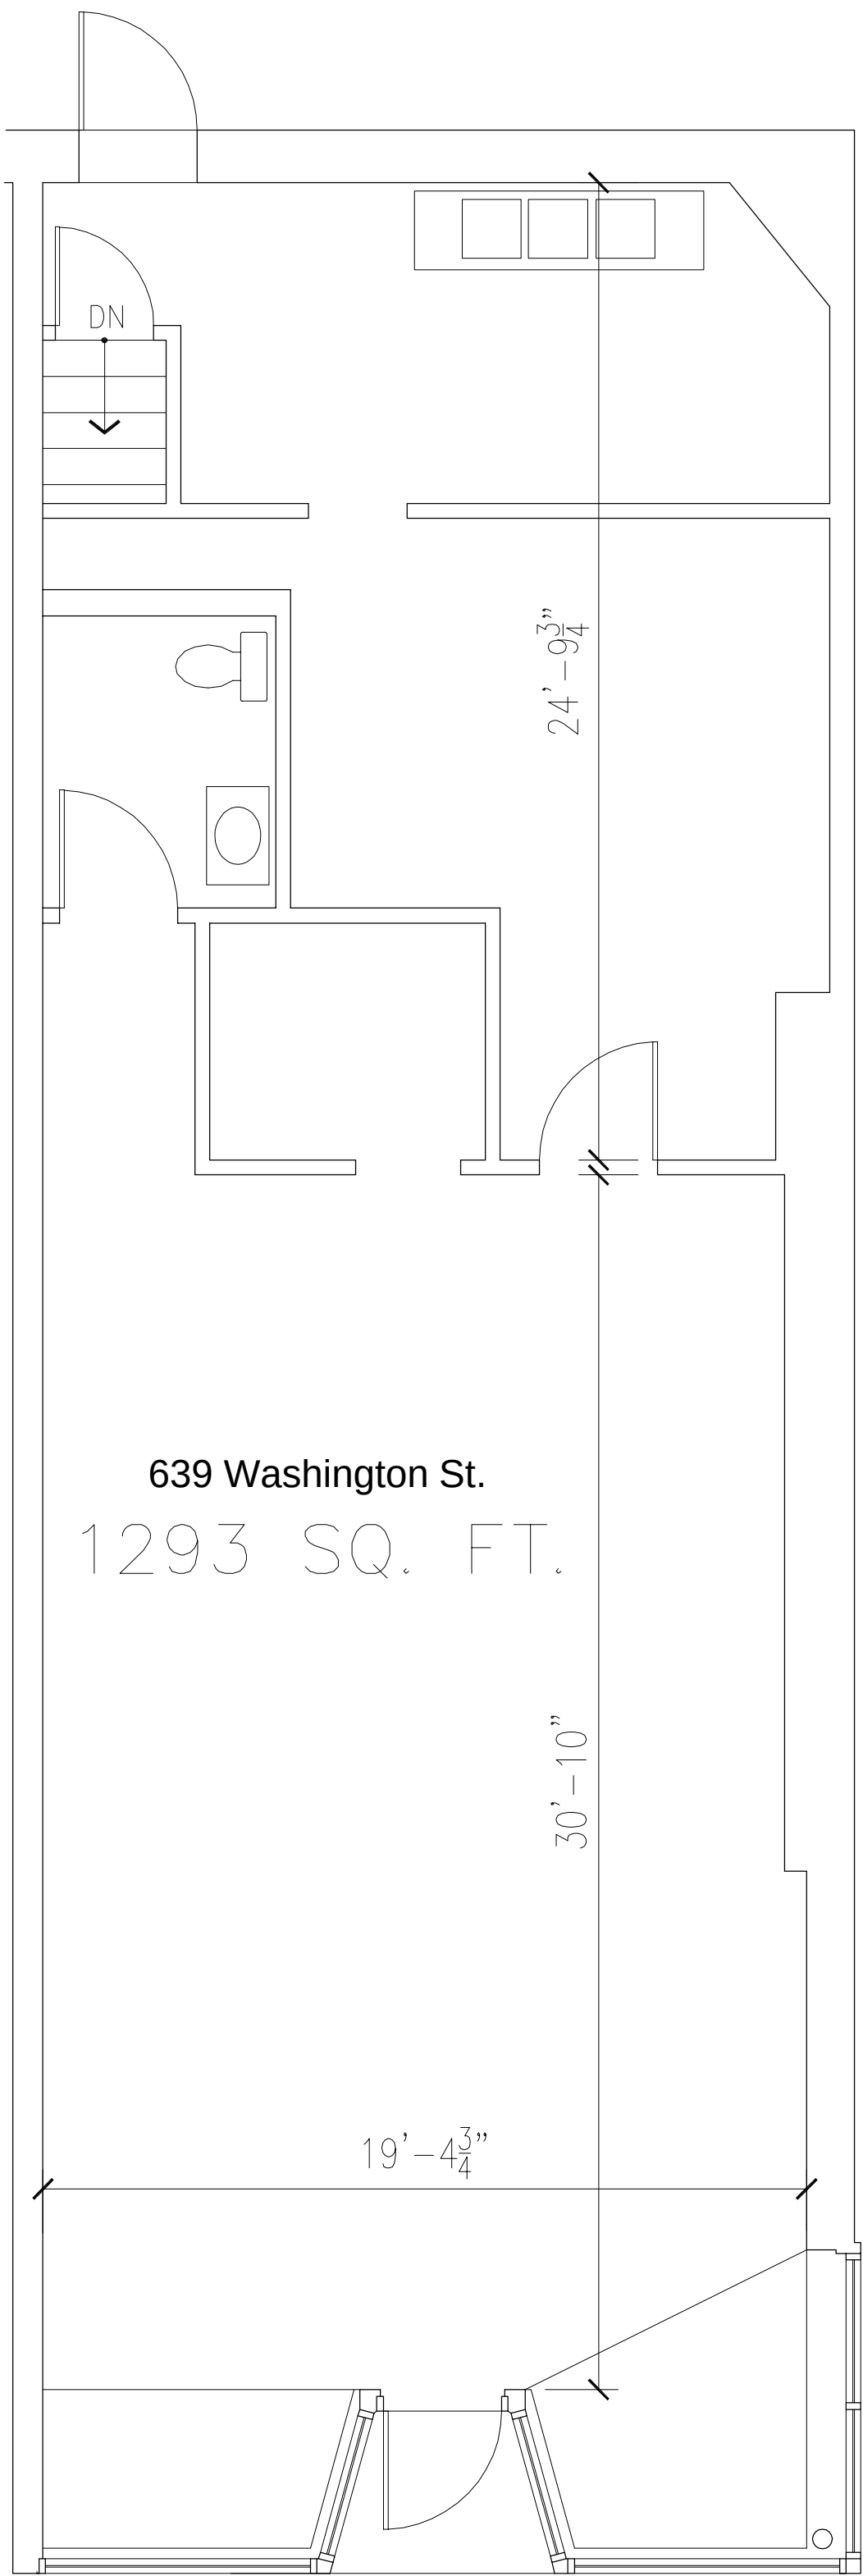

639 Washington
St

Norwood, MA

EXISTING
CONDITIONS

Call us at: (617) 247 9161
info@existingconditions.com
www.existingconditions.com

The Most Accurate
Existing Conditions Surveys and
As-Built Surveys™

All projects are measured using the most advanced laser
measuring equipment and our best standards and practices.
All work will be field verified by client prior to design or
construction or other use.

General Notes:
1. It is expressly understood by client that ECS is not an
architectural or engineering entity. None of the documents
prepared by ECS for client shall have any stamping or
certification of such trade professionals.
2. This is not a structural or MEP analysis or due diligence model.
Visible and accessible elements are modeled for location and
size. Further structural or MEP analysis could be necessary by
others.
3. STANDARD OF PRACTICE: Services performed by ECS under
this Agreement will be conducted in a manner consistent with
that level of care and skill ordinarily exercised by members of the
profession currently practicing in the same locality under similar
conditions. No other representation, expressed or implied, and no
warranty or guarantee is included or intended in this Agreement,
or in any report, opinion, document or otherwise. Client shall field
verify all work prior to design construction, or other use.

Laser Scanning Notes:
1. Visit FARO.com and leica-geosystems.com for 3D laser scanner
tolerances, range information and product specifications.
2. Laser scanning equipment uses light waves to measure
distances, unforeseen site conditions such as dust, moisture,
vibration, surface reflectivity, lighting conditions, temperature,
humidity, ferromagnetic materials, building configuration etc. may
impact registration between scan locations.
3. Accuracy over long distances can be improved if the client
provides survey benchmarks prior to scanning in order to
reference the laser scan data into a coordinate system.
4. The Revit file contains the most complete alignment of point
cloud data. All laser scanning by default is in a localized
coordinate system. Laser scans completed on multiple days may
be tied into previous laser scans by use of site specific features
and targets. Point cloud adjustments are made in Revit for a final
verification.

Revision Schedule		
Revision Number	Revision Description	Revision Date

Existing First
Floor Plans

Date: 10-26-2021

Scale: 1/4" = 1'-0"

Drawn By: ECS

EX01