

THUNDERBIRD
MEDICAL
PLAZA I


Floor 01

Suite 14A

AS-BUILT

1,716 SF

AVAILABLE

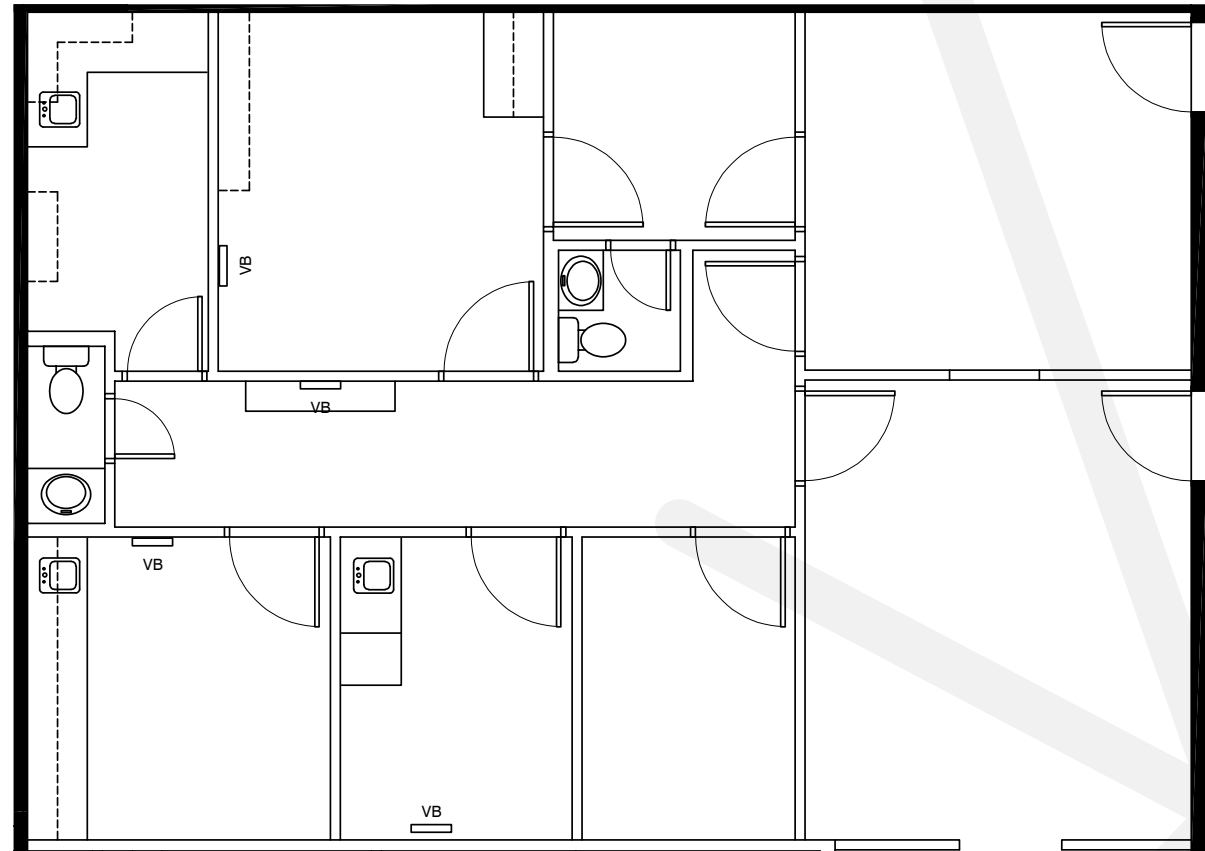

RACHAEL THOMPSON
Senior Vice President
602.513.5122
rachael.thompson@kidder.com

PERRY GABUZZI, CCIM
Executive Vice President
602.513.5116
perry.gabuzzi@kidder.com



View Portfolio