
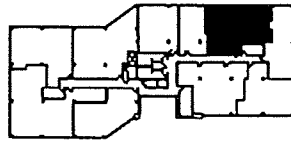


DRAWING OF THE LEASED PREMISES

SUITE 373
1,942 RSF

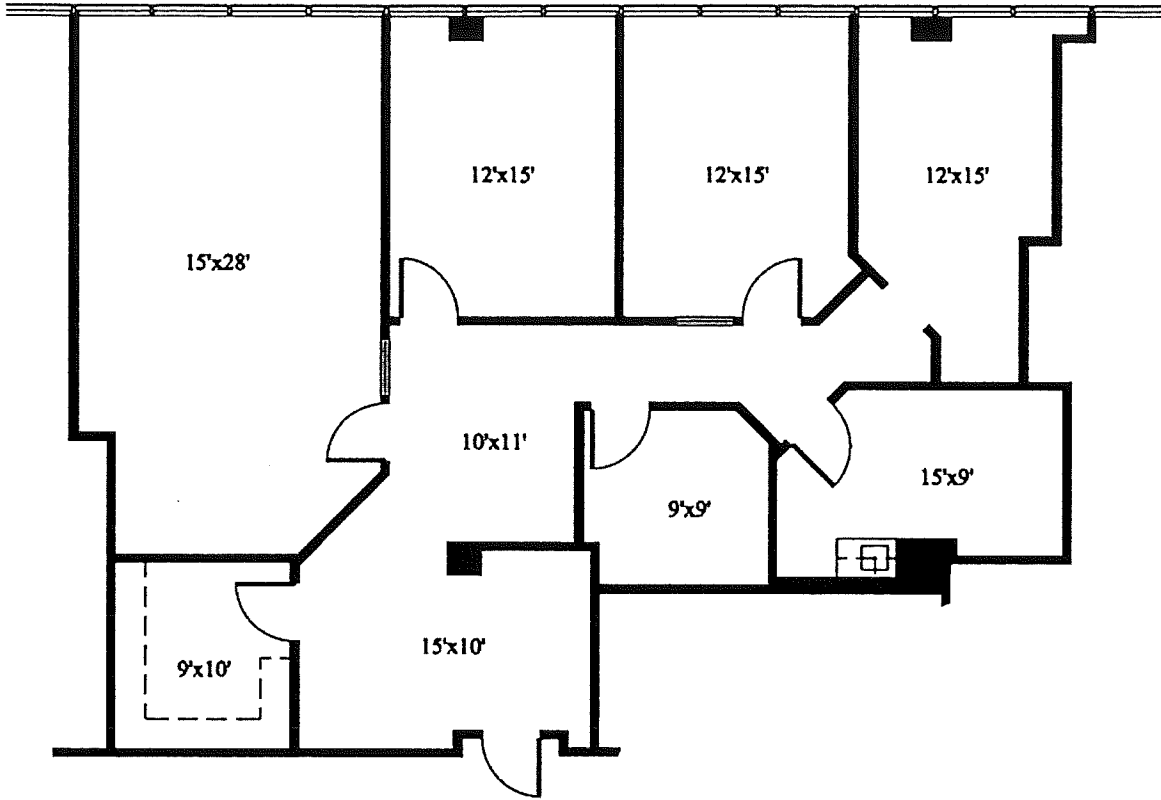

3RD FLOOR

Scale: 1/8"=1'-0"

All dimensions and square footages are approximate.

November 7, 2013



THOMPSON CONSULTING SERVICES, INC. 12024 Golden Meadow Lane, Forney, Texas 75126 (972)564-5252