


525 Congress Parkway

Crystal Lake, Illinois 60014

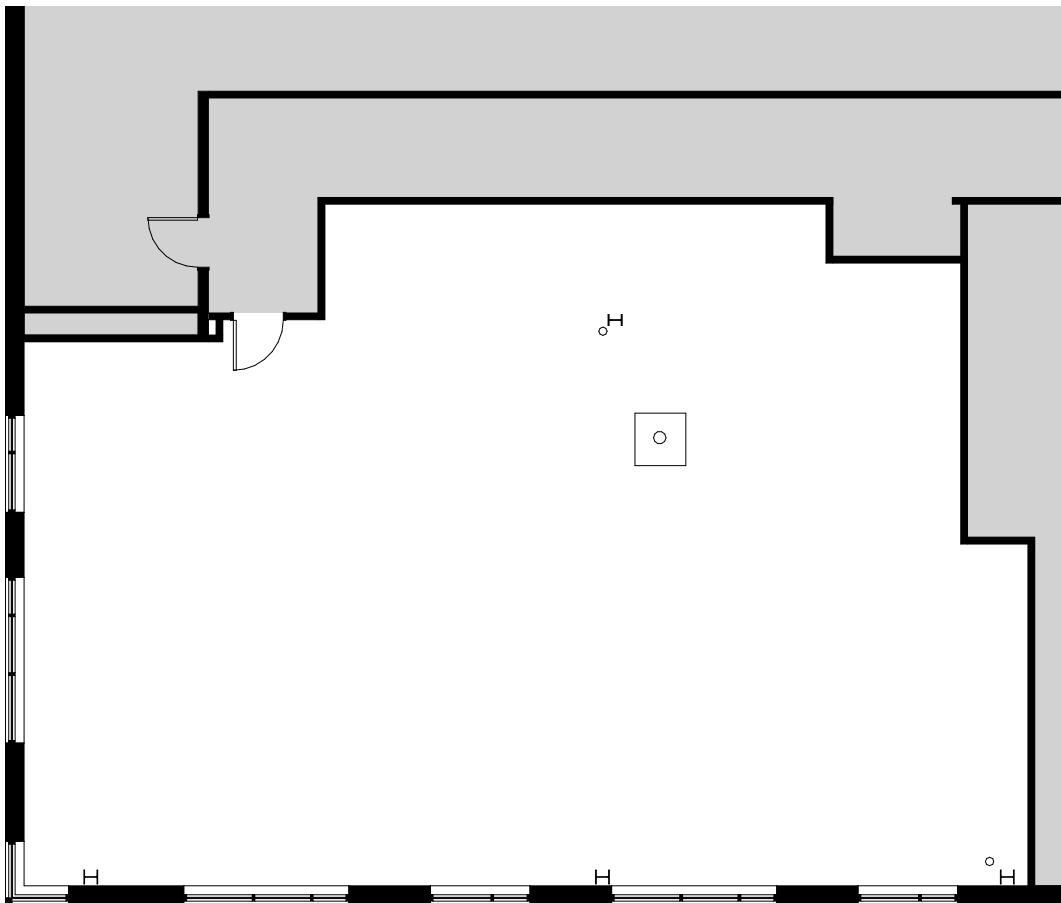

Suite # 140 As-Built Conditions

2,611 Rentable Square Feet

SCALE: NTS

