


AS-BUILT

3RD FLOOR - 29,099 SF

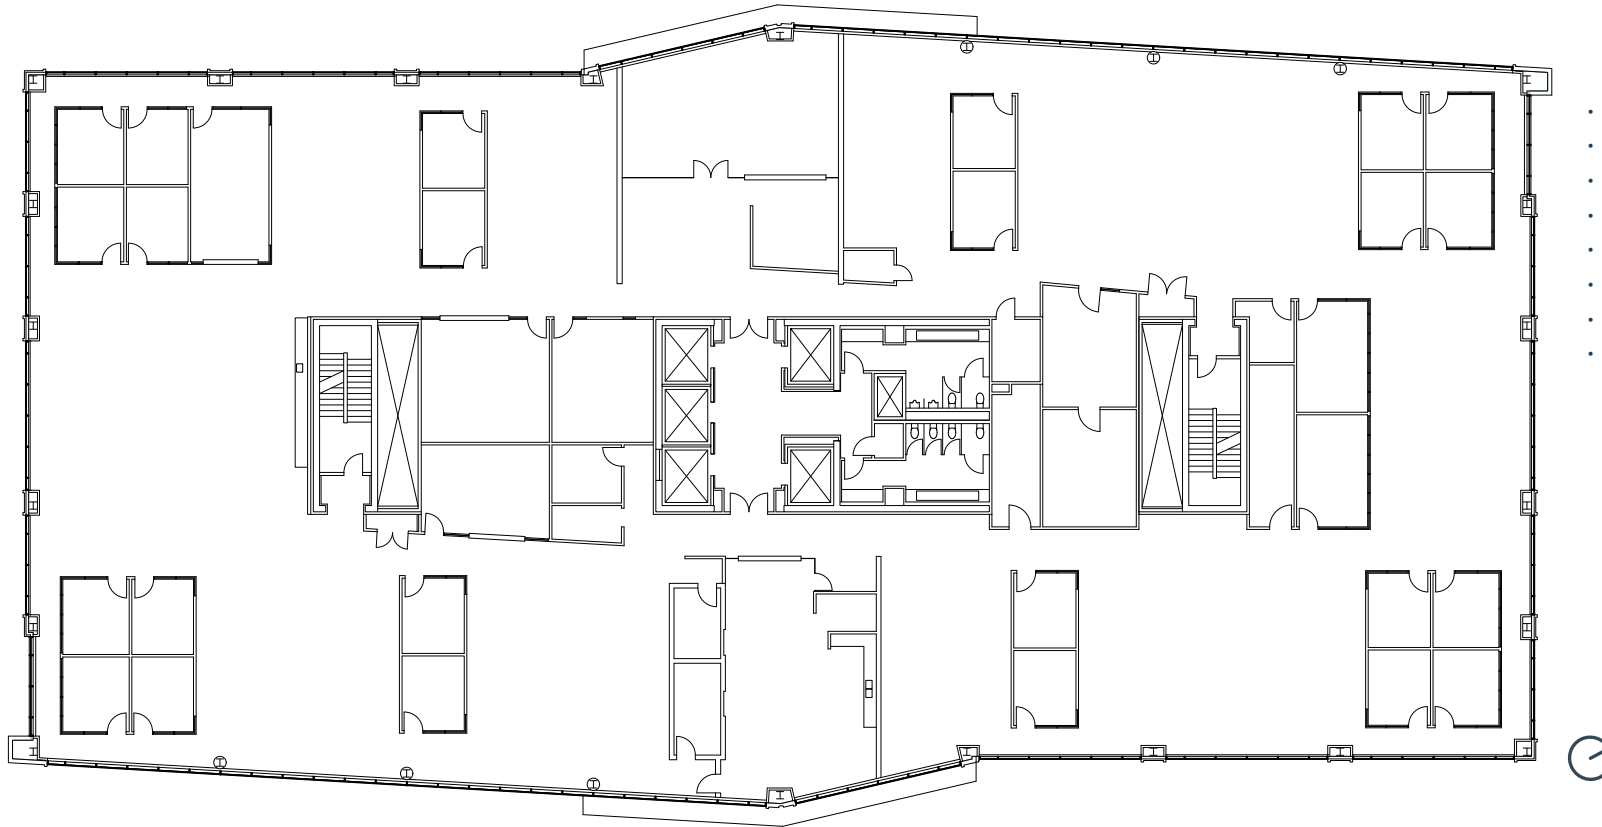

FEATURES

- Open space for workstations
- 26 private offices
- 5 conference room
- 2 phone rooms
- 1 reception
- 1 break area
- 1 IT room
- 1 storage room



Jonathan Shirazi
+1 303 217 7968
jonathan.shirazi@jll.com

James Roupp
+1 303 579 8745
james.roupp@jll.com

