


## Property Key

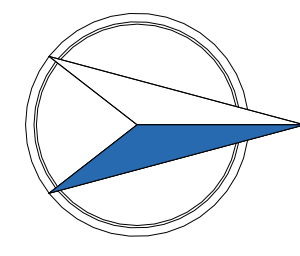

# AltSprings As Built Marketing Package

370 Northlake Blvd, Alt Springs, FL 32701, US

Building: 370

Suite: 1002

Sheet **E1**

Scale: Not to Scale  
Sheet Size: 42" x 30"  
Not For Construction




# BAY SPACE

## Usable Square Foot Analysis

Office Area	3,050	100 %
Warehouse Area	0	0%
Total Area	3,050	

## Building Information

Deck Height:	17' - 2 1/2"	
Clear Height:	8' - 9"	
Ceiling Height:	7' - 11"	
Sprinklered:	<input checked="" type="checkbox"/> Yes	<input type="checkbox"/> No
Mechanical Area:	135 SQFT	

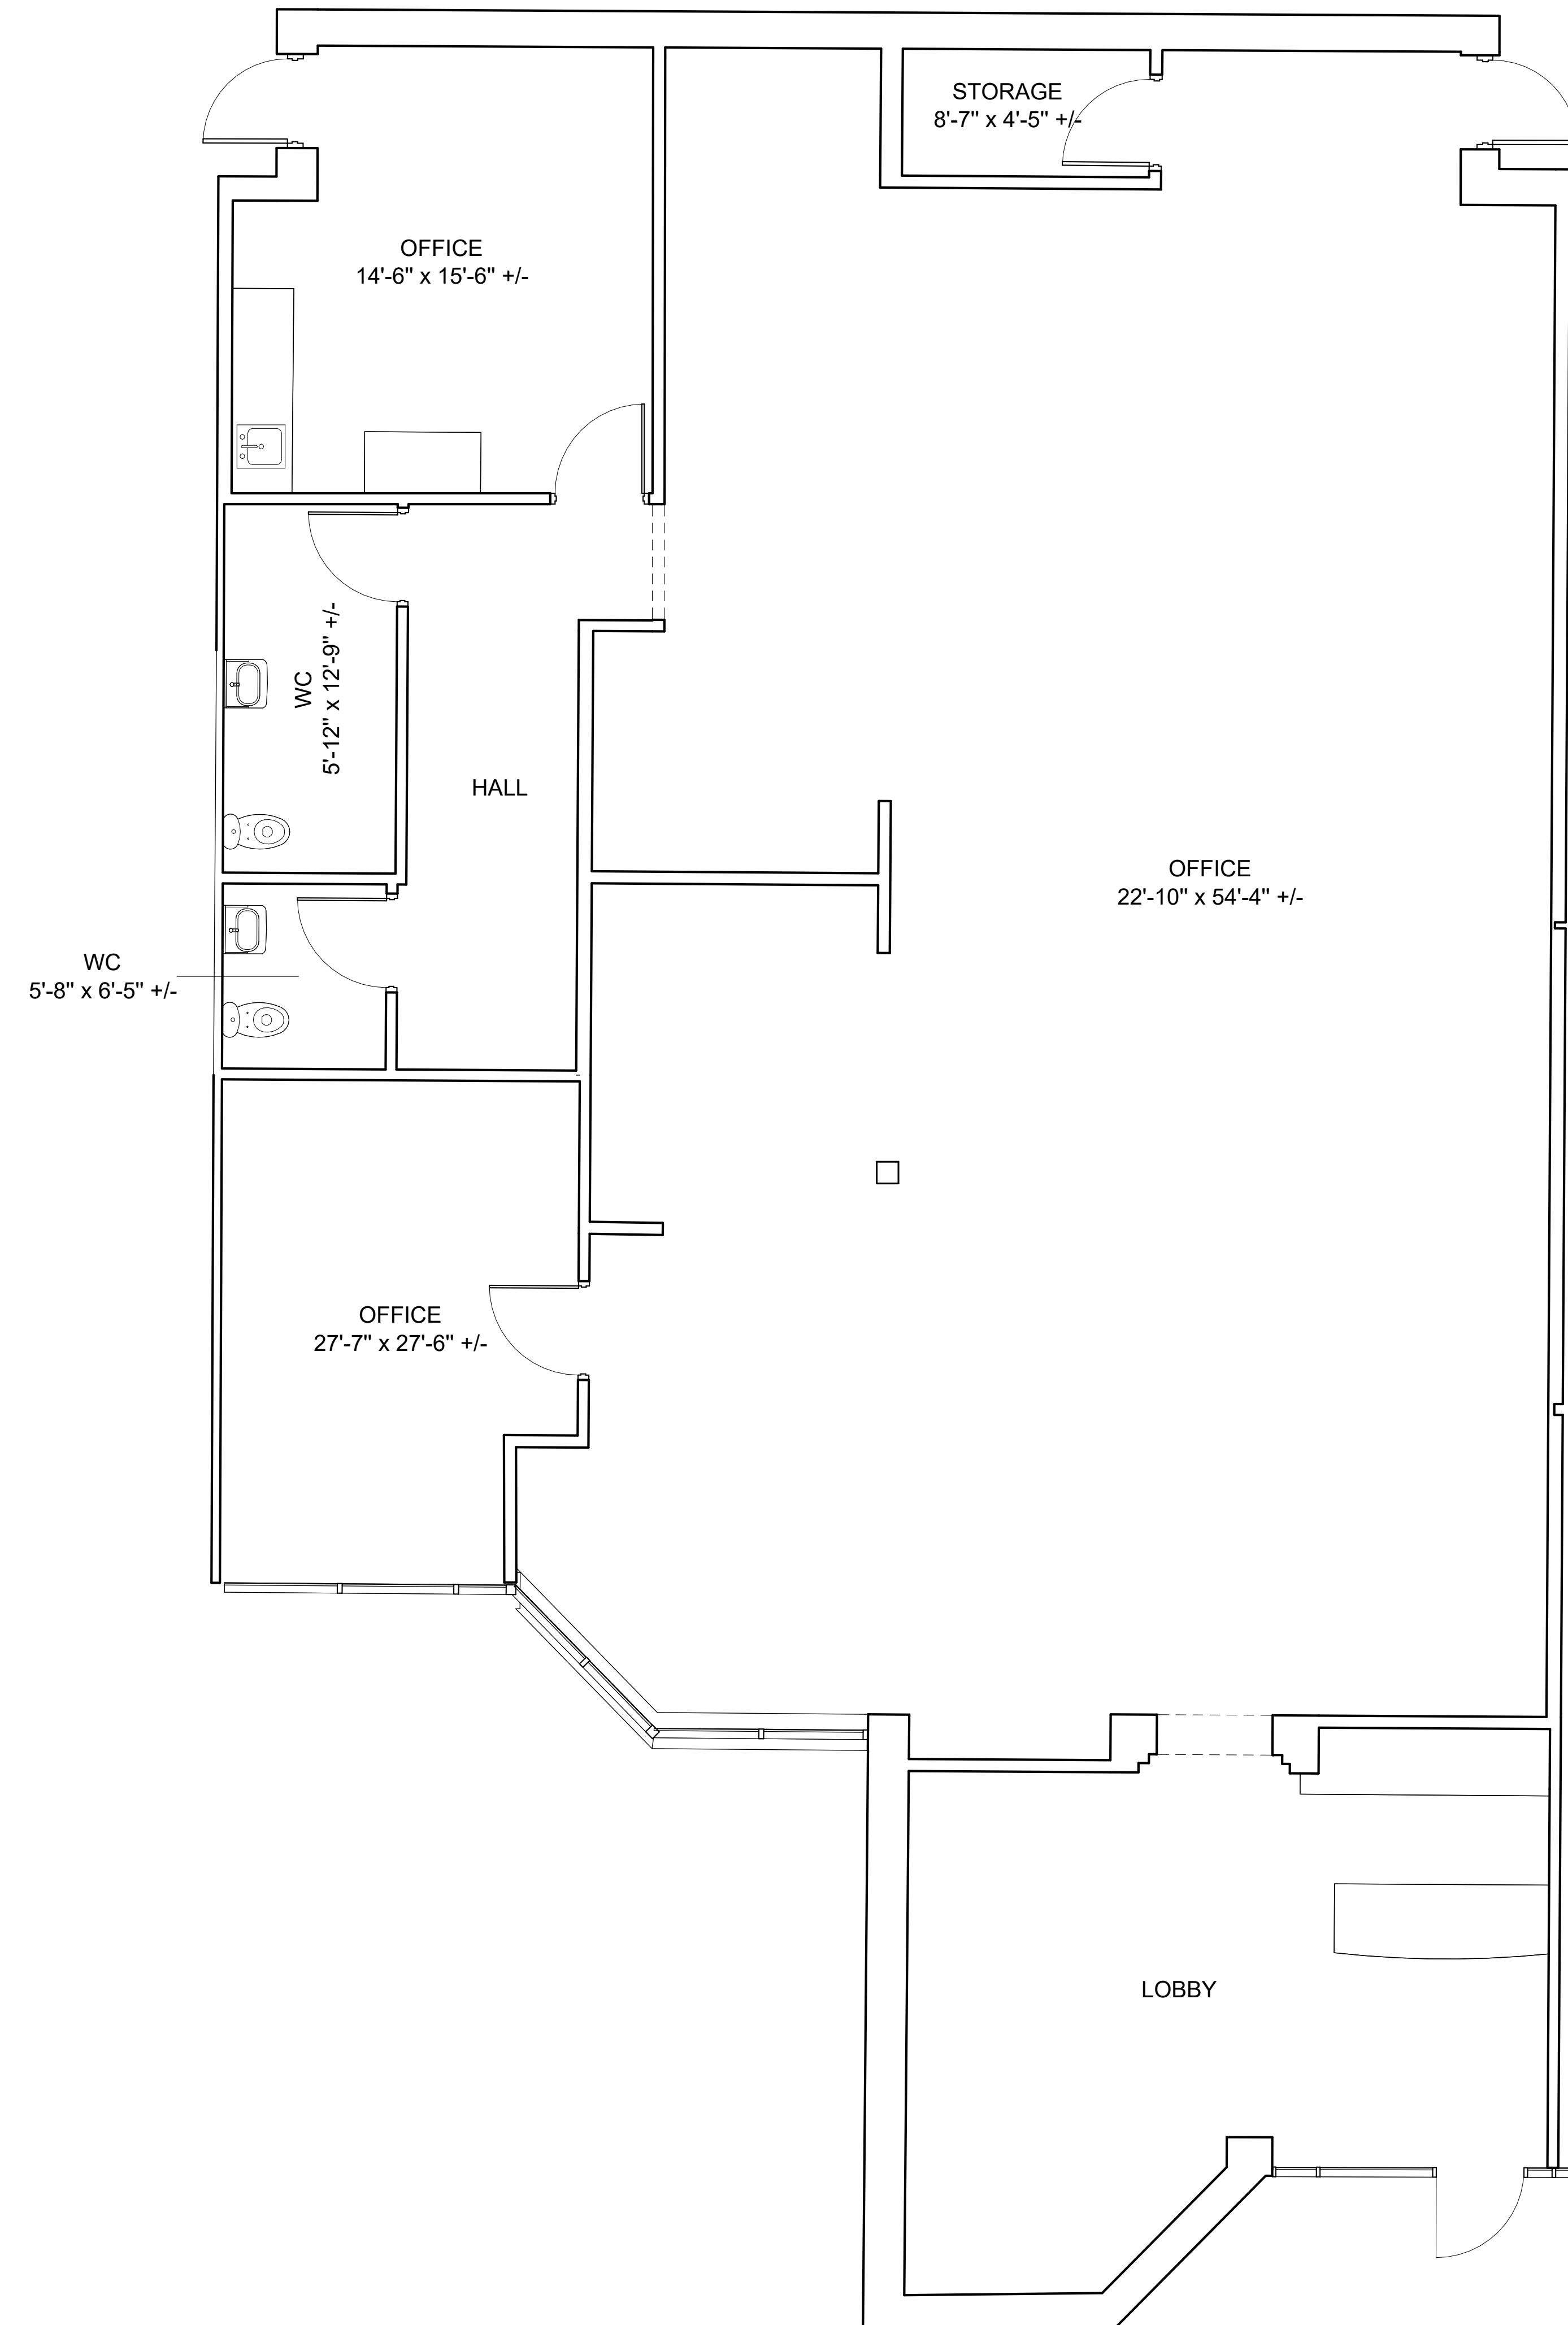

As Built Floor Plan for Marketing

