


Location: U:\Projects\Construction\Projects\Atlantic-Kernan Shops\Outparcels\12210 (Regions fka Amsouth)\Ground\As-Built\AK_12220--_sf.dwg

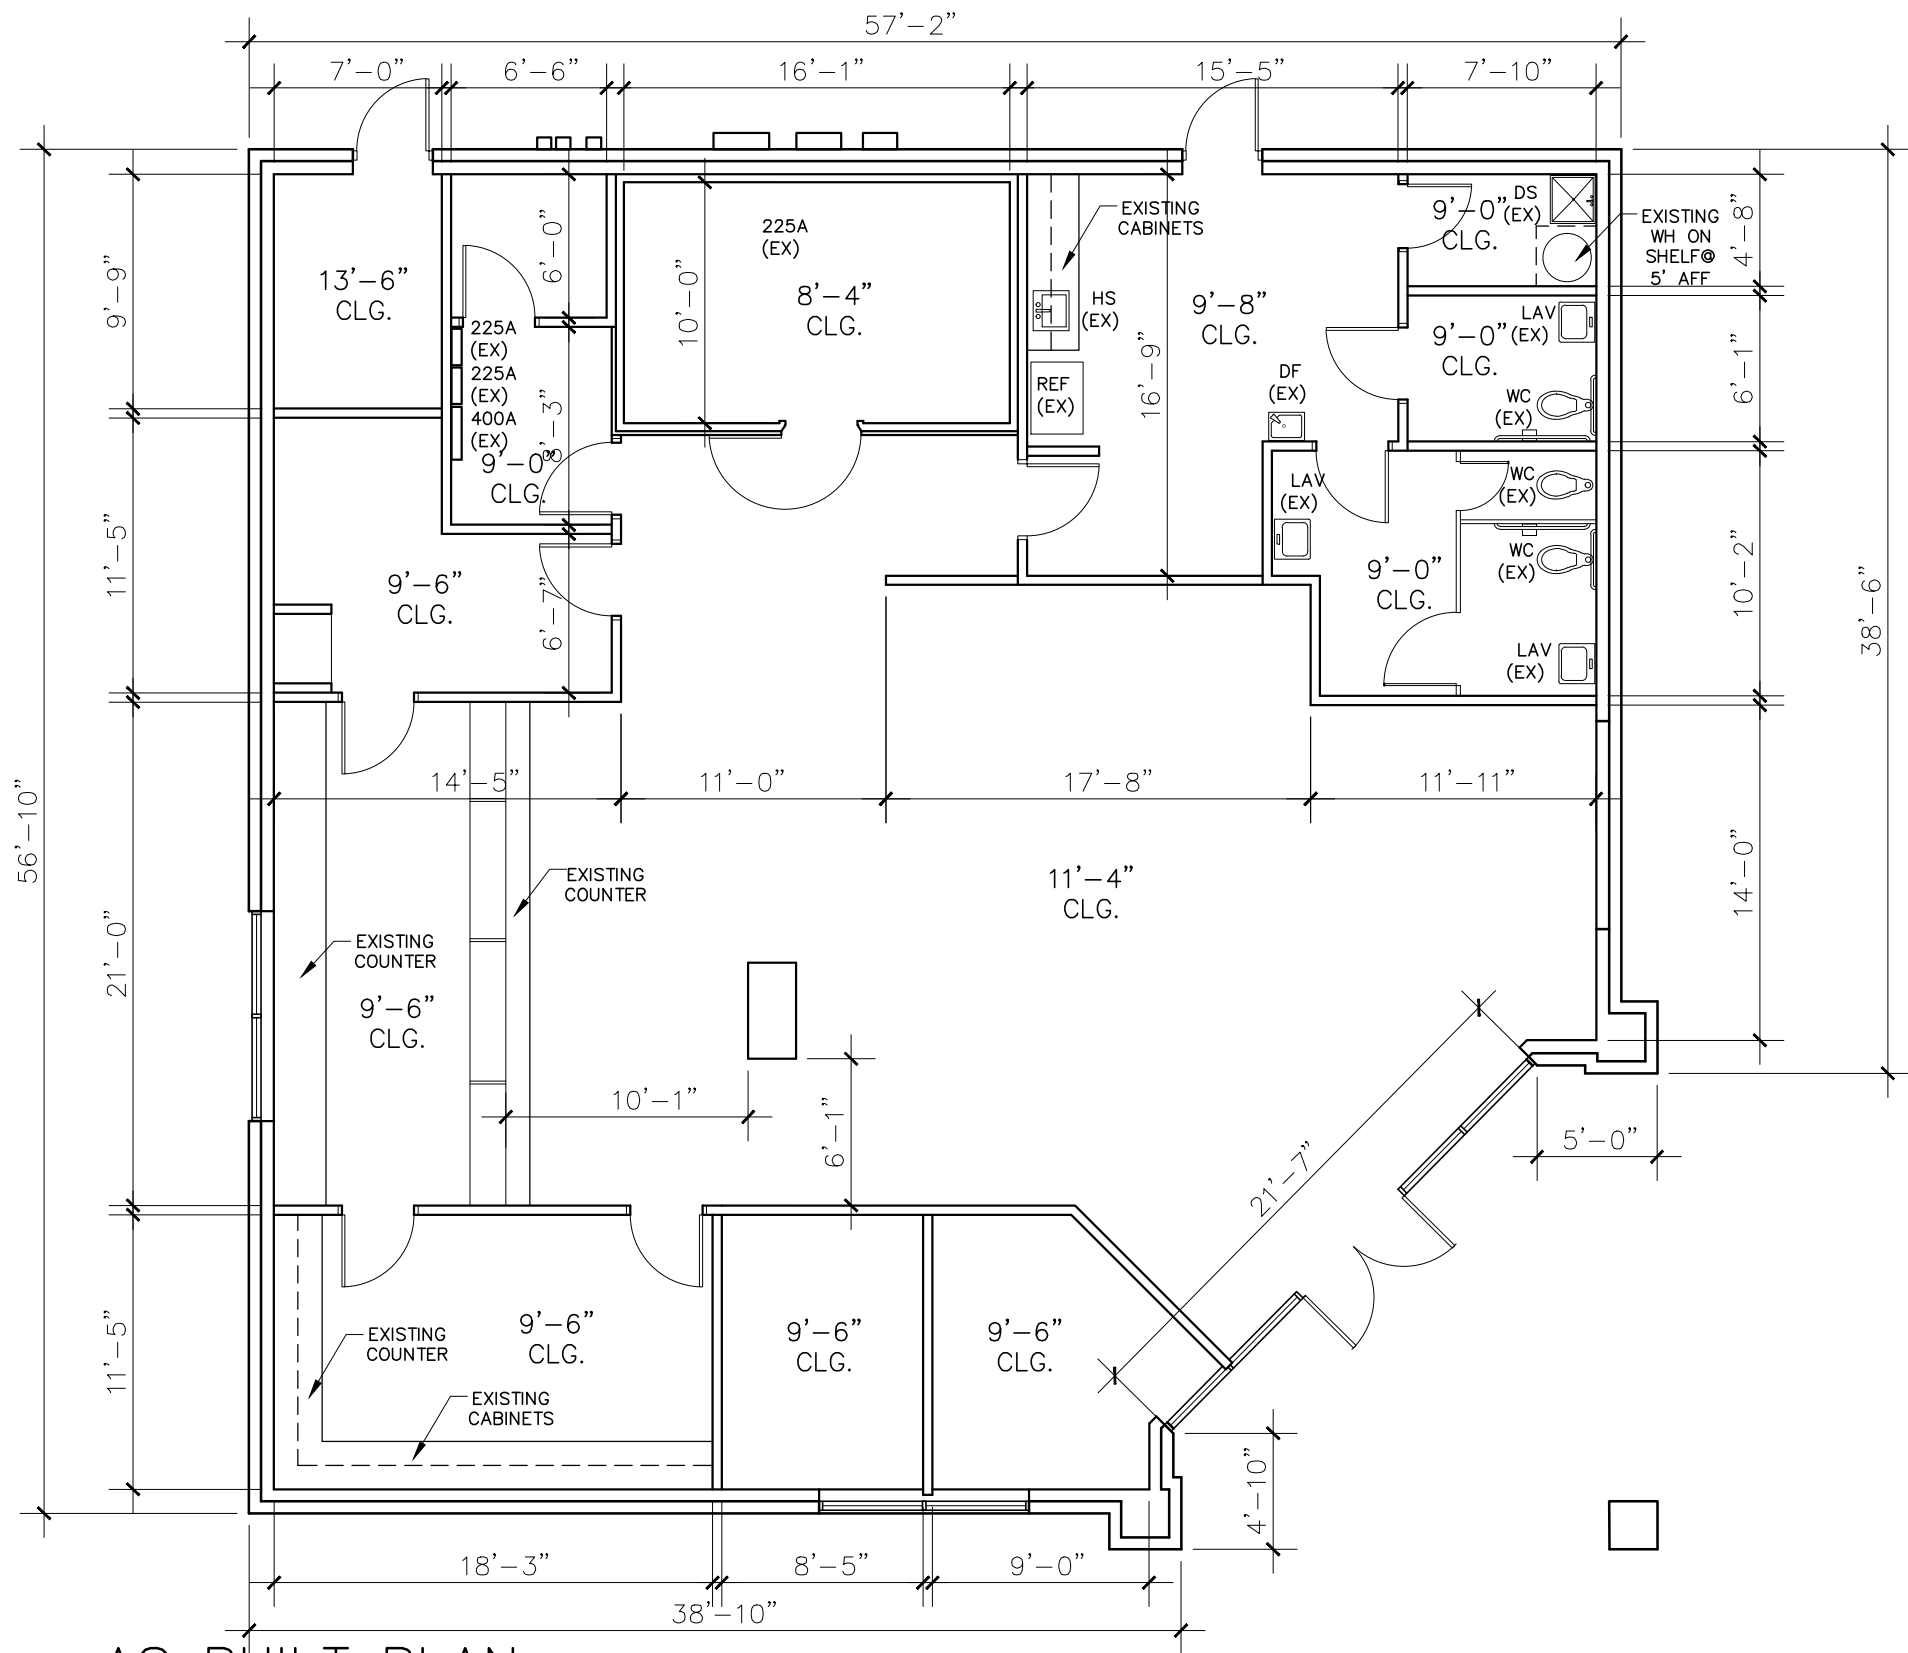

AS BUILT PLAN
SCALE: 1/8" = 1'-0"



All reports, plans specifications, computer files, field data, notes and other documents and instruments prepared by the professionals listed and as instruments of service remain the property of TCI Construction. TCI Construction shall retain all common law, statutory and other reserved rights, including the copyright thereto. Any use or reproduction of this document without written permission from TCI Construction is a violation of Federal copyright laws.

Drawn By:	Checked By:	Approved By:
MC	MC	MC
Scale :	Date :	
na	01-13-17	
Project Number:		
1799-011		

ATLANTIC & KERNAN SHOPS
(OUTPARCEL) UNIT 12210-400 3024 SF