

**ROYAL OAK  
PROFESSIONAL  
PLAZA**


# Floor 01

Suite 1-7

AS-BUILT

2,840 SF

AVAILABLE

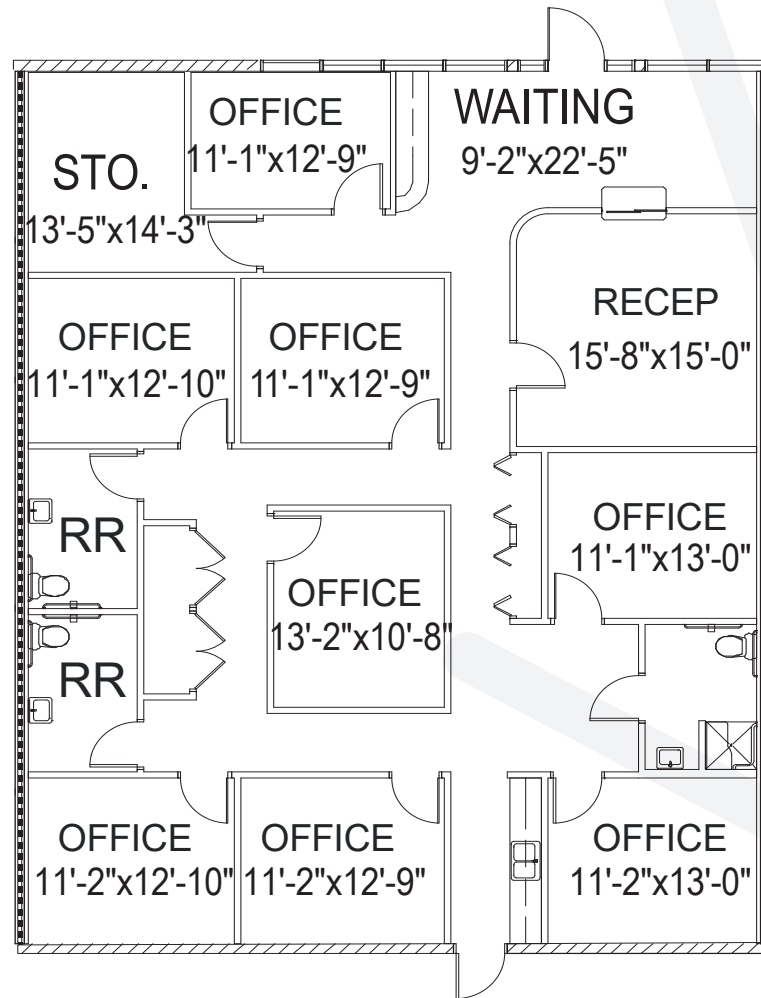

**RACHAEL THOMPSON**  
Senior Vice President  
602.513.5122  
rachael.thompson@kidder.com

**PERRY GABUZZI, CCIM**  
Senior Vice President  
602.513.5116  
perry.gabuzzi@kidder.com