


OFFICE RENTABLE SF	
OFFICE #	RENTABLE SF
OFFICE 100	481 SF
OFFICE 101	908 SF
OFFICE 102	1468 SF
OFFICE 200	1234 SF
OFFICE 201A	1650 SF
OFFICE 201B	2212 SF
OFFICE 205	1175 SF
OFFICE 210	3125 SF
OFFICE 220	2527 SF

TOTAL INTERIOR GROSS SQUARE FEET
 1ST FLOOR: 4,803 SF
 2ND FLOOR: 11,373 SF
 TOTAL = 16,176




1 FIRST FLOOR
 1/8" = 1'-0"
 0 4 8 16'

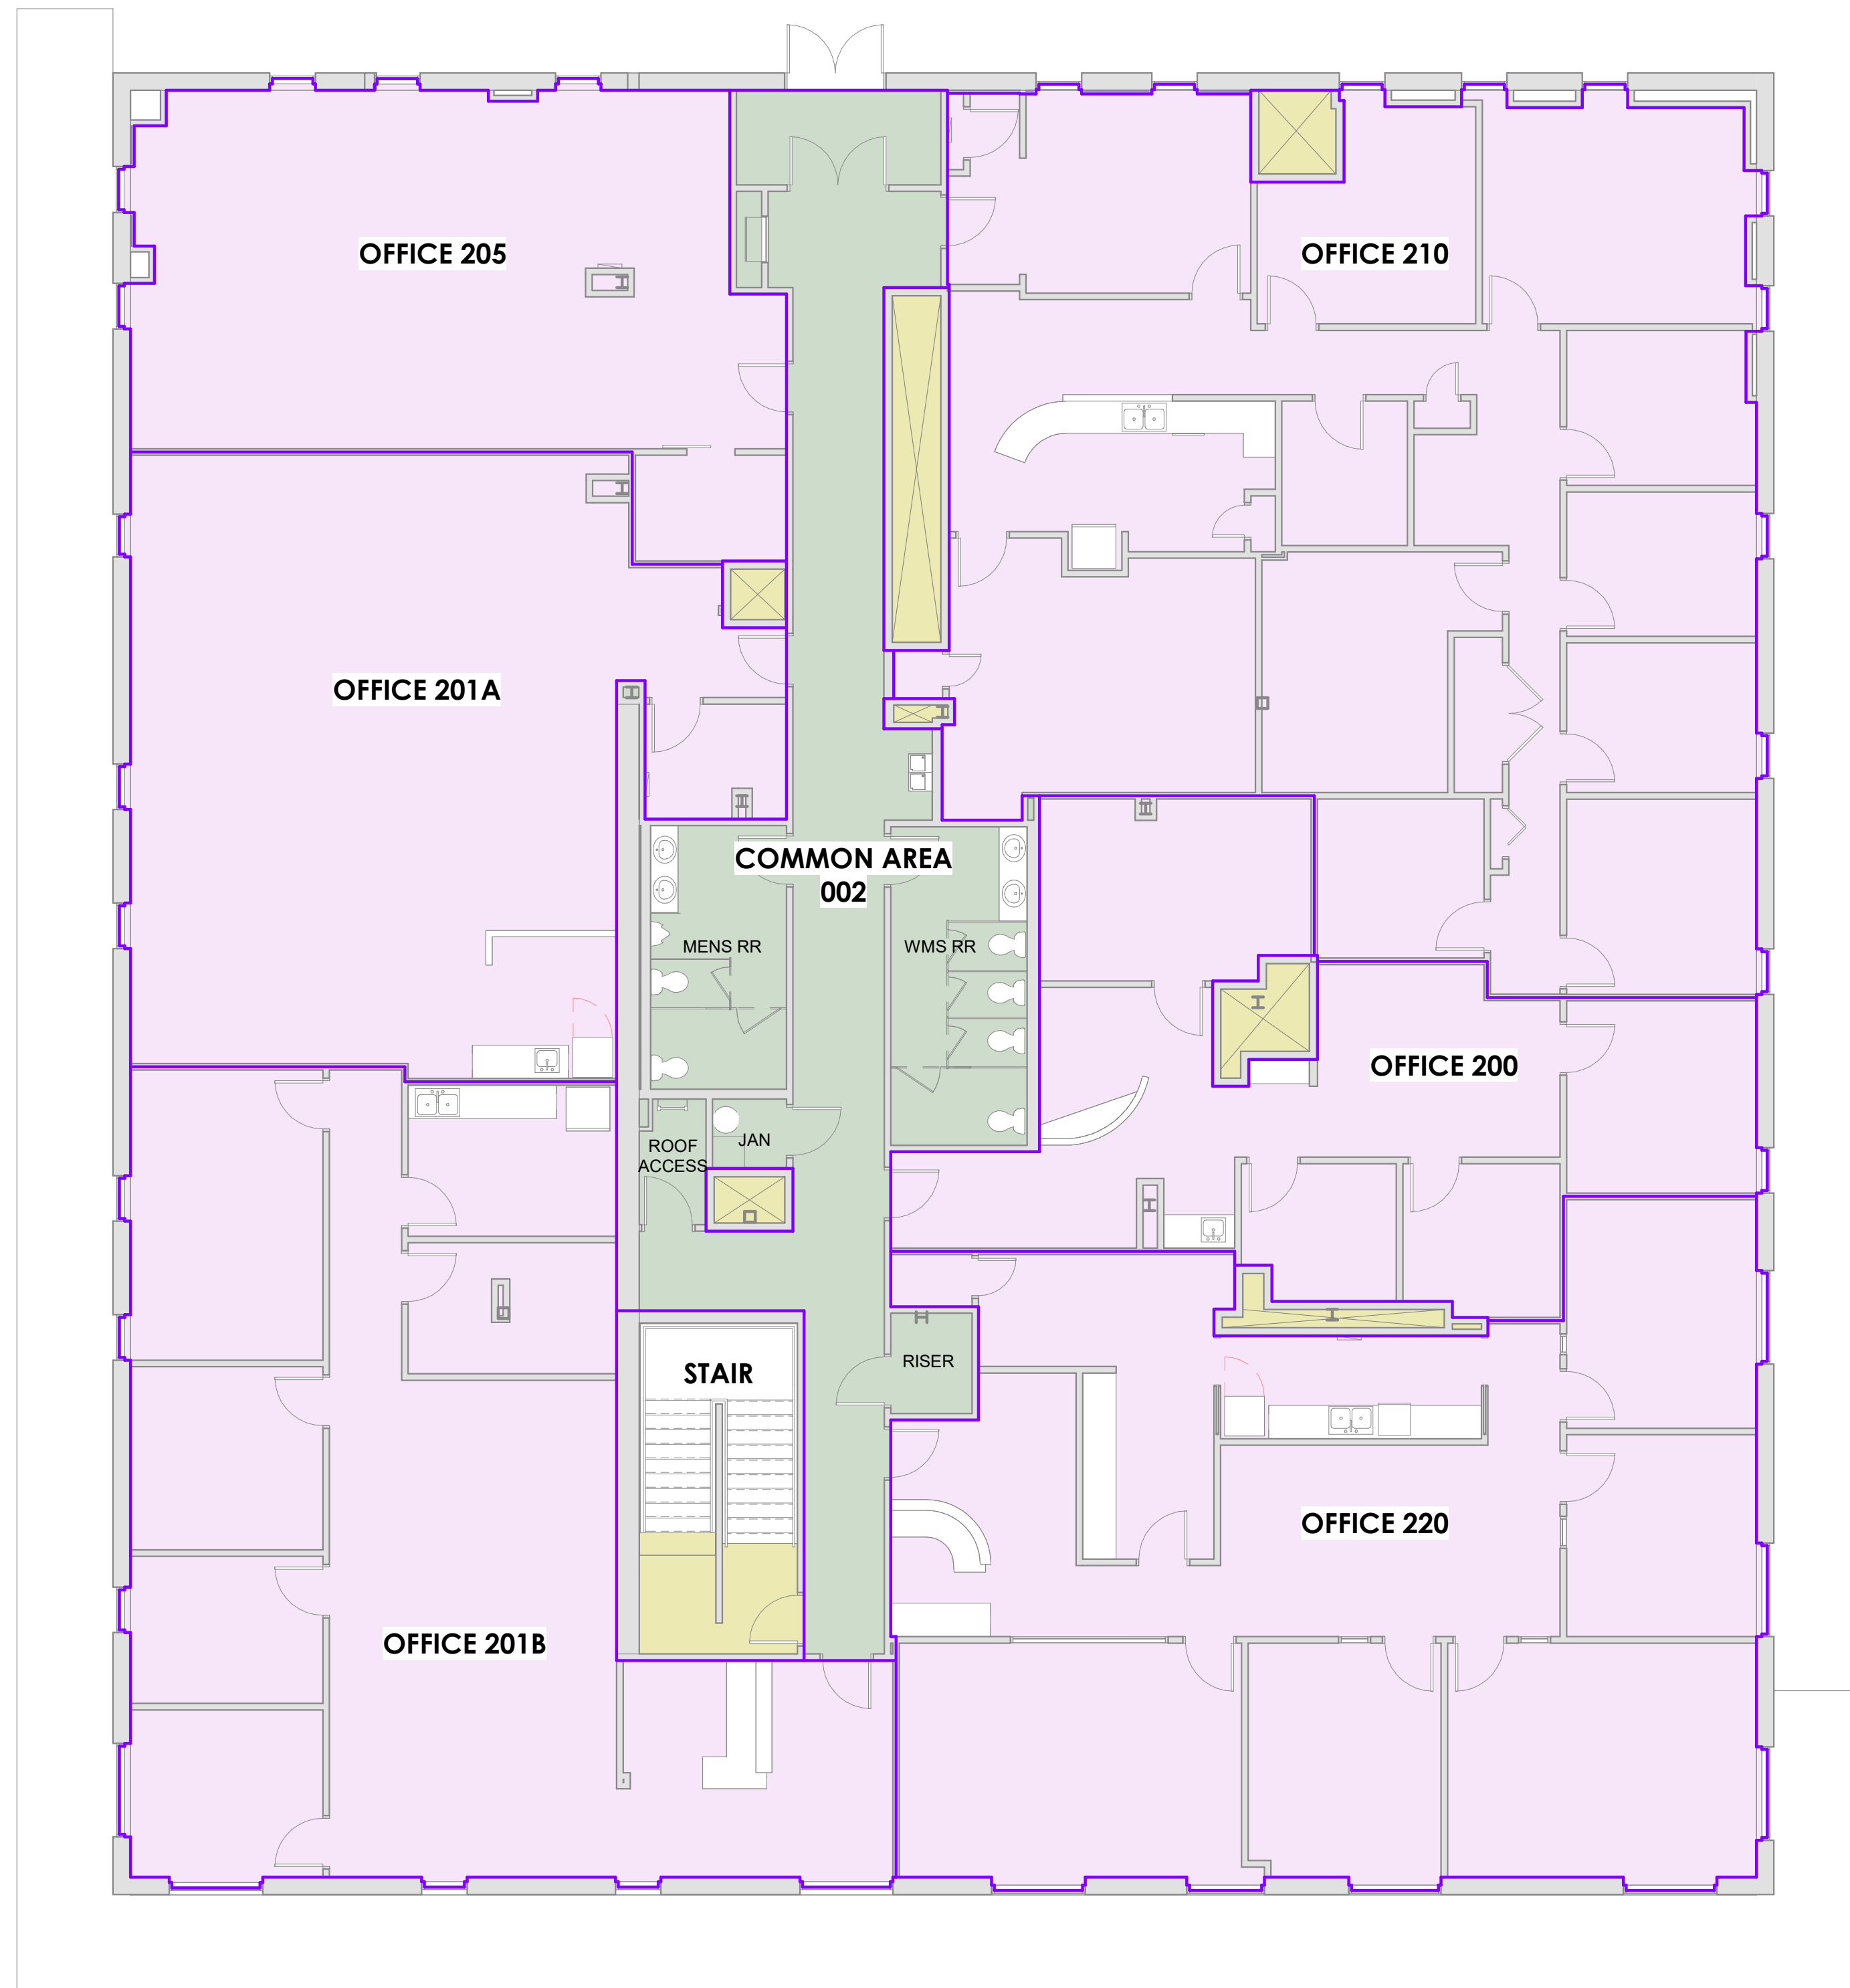

2 SECOND FLOOR
 1/8" = 1'-0"
 0 4 8 16'

Building Common Area
 Major Vertical Penetration
 Office Area

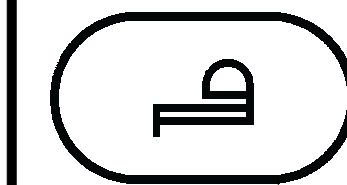

AS-BUILT DRAWINGS
ALL DIMENSIONS, ELEVATIONS, AND FINISHES ARE TO BE FIELD VERIFIED. THE SOLE PROPERTY OF BRAND INTERIOR DESIGN, LLC. REPRODUCTION BY ANY METHOD WITHOUT WRITTEN CONSENT IS STRICTLY PROHIBITED. COPYRIGHT © 2024

LEBANON PIKE AS-BUILT DRAWINGS

2900 LEBANON PIKE | NASHVILLE | TENNESSEE

BRAND ID [NASHVILLE TENNESSEE | 615.812.7035 | BRANDinteriordesign.com]

REVISIONS	DATE
#	DESCRIPTION

PROJECT NO.: 2604
 ISSUE: 2026.04.07

A11
 FLOORPLANS