



1


Reduced As-built

Suite 711

Scale: 1/8" = 1'-0"



North

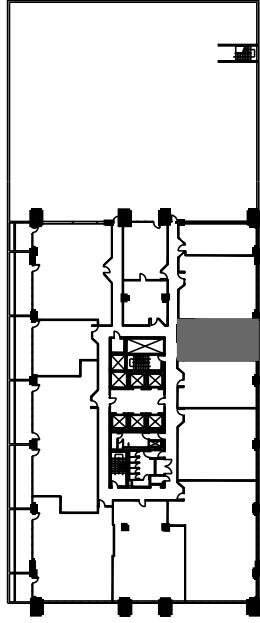

Proximity Plan

Suite 711

The Chancery

963 RSF

Reduced As-built Plan
Issued: March 2025
Drawn by: MCP / WCS
TPS Project #: 171001

The Chancery
Level Seven, Suite 711
1120 Lincoln Street
Denver, Colorado

TPS
1660 Lincoln St, Ste. 100
Denver, Colorado 80264
(303) 861-4800
www.tps.design