
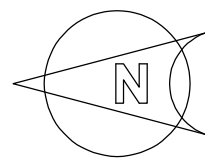


05/27/2025  
A/E # 2514

614 CENTER STREET  
LITTLE ROCK, AR 72201  
501-376-3676 FAX376-3766  
**terry buruss**  
Architect  
design, planning and interiors

AS-BUILT PLANS FOR:  
**DAVIS PROPERTIES**  
1515 BOWMAN RD. STE. A  
LITTLE ROCK, AR

1  
OF  
1

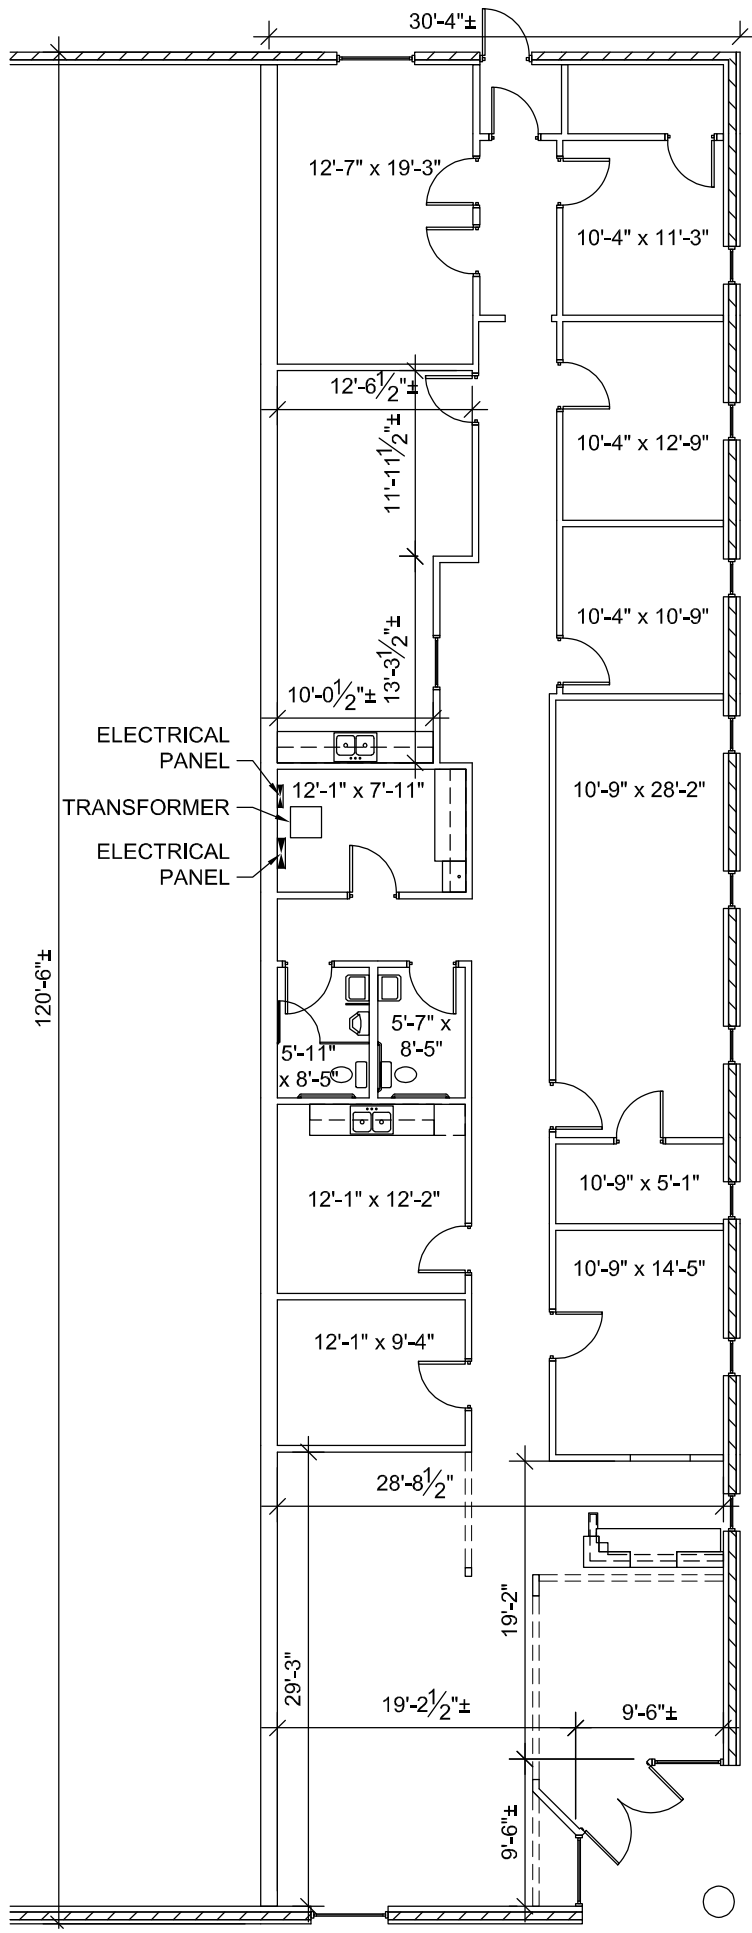

FLOOR PLAN

SCALE: 1/8" = 1'-0"

