


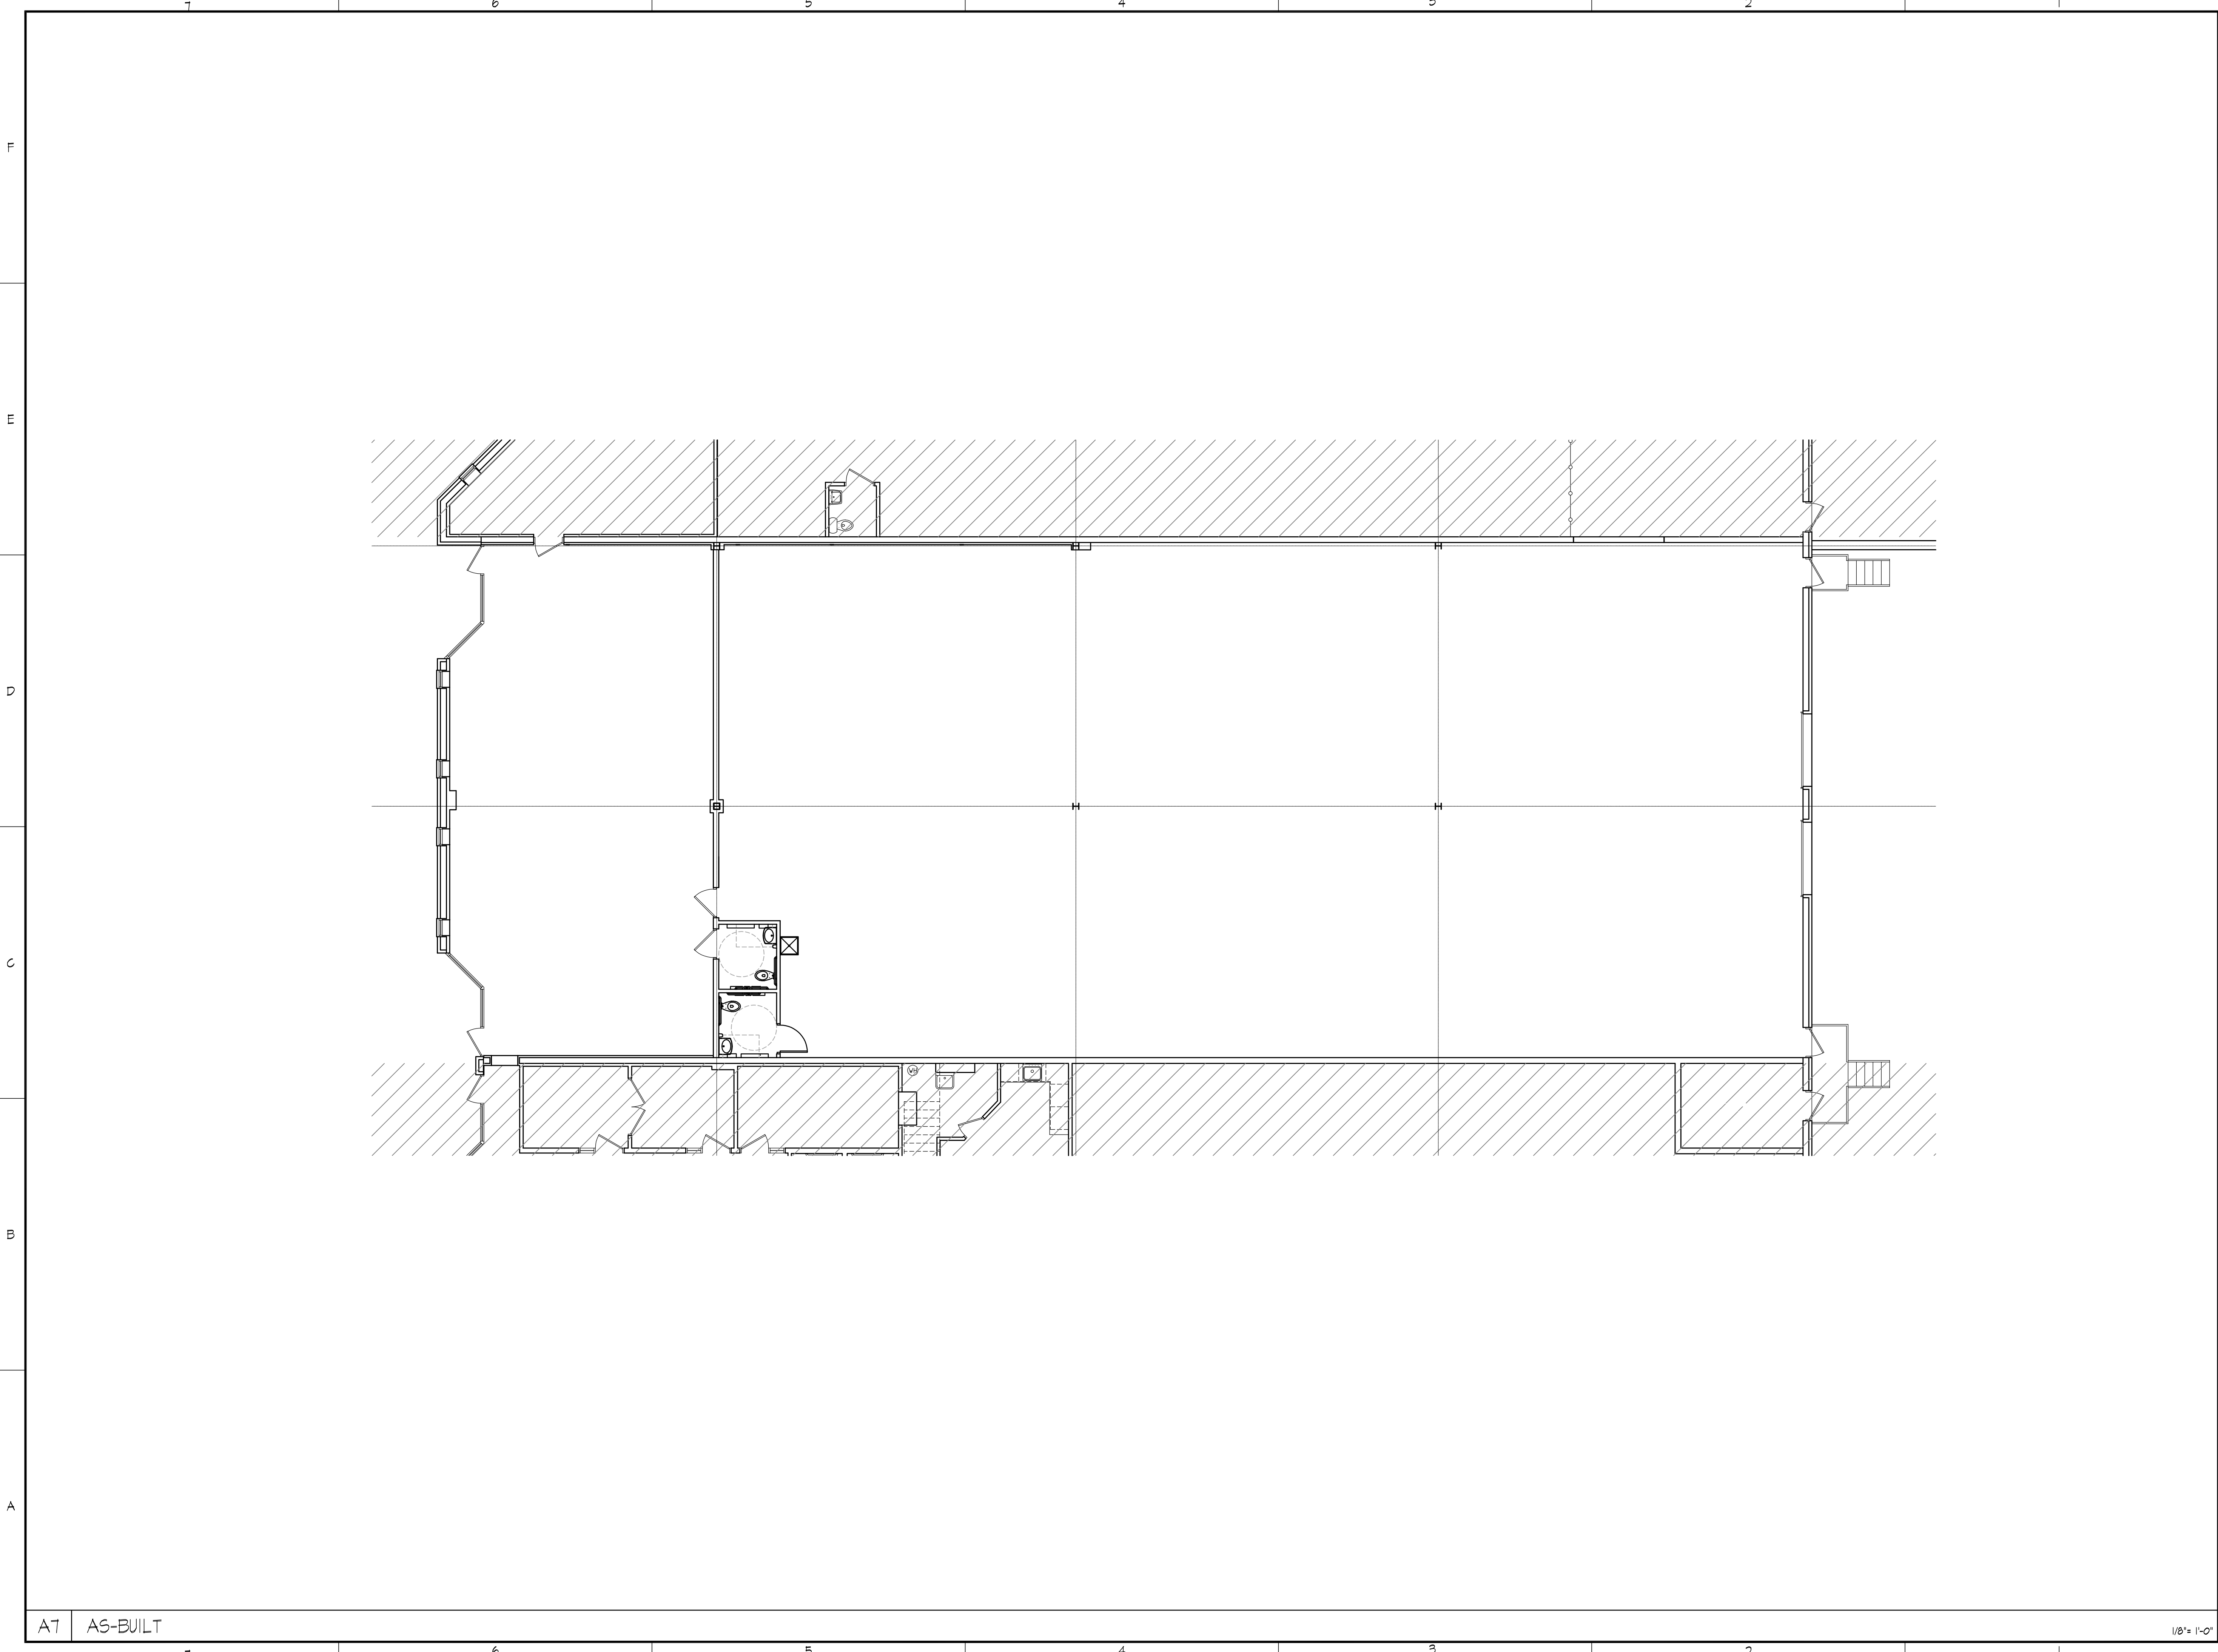

PROJECT:

9004 YELLOW BRICK RD
SUITE H
ROSEDALE, MD 21237

DWG. TITLE:

ISSUE/REVISIONS:

No.	DATE	DESCRIPTION

SEAL:

DRAWN BY:
CS

CHECKED BY:

SCALE:
AS NOTED

PROJECT No.
19068

DATE:
8.18.2019

FILE NAME:

SHEET NO:

AS BUILT

e:\2019 Projects\9004 - Speculative Suite at Yellow Brick Road\Drawing As-Built\Yellow Brick_Suit_H_8-12-2019.dwg