


AREA TABULATION

UNIT 105 LEASABLE SPACE =

1957 S.F.

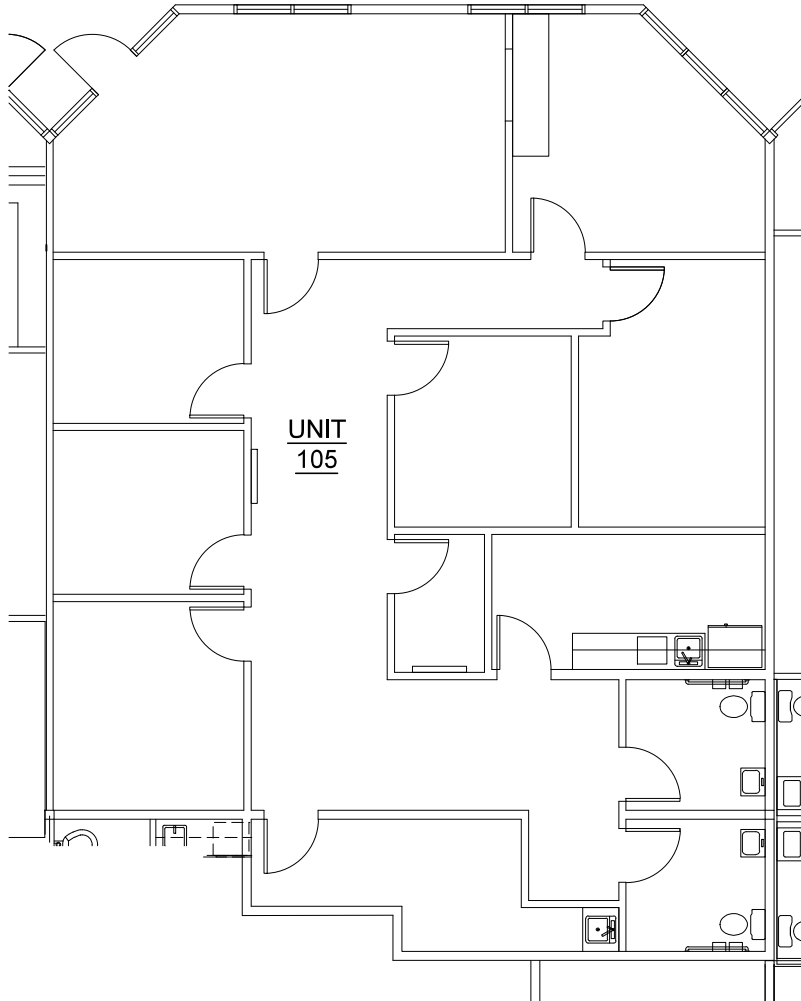

1 UNIT 105 AS-BUILT PLAN
A1.00 SCALE: 3/32" = 1'-0"

REVISIONS	#	DATE	DESCRIPTION	DRAFTER INFORMATION	PROPERTY OWNER:	PROJECT INFORMATION	PROJECT NAME:	DRAWING INFORMATION	PLOT DATE:	
					RENO JONES, LLC				RENO JONES OFFICE SUITES	09-17-2024
					COMPANY ADDRESS: 5052 SOUTH JONES BOULEVARD LAS VEGAS, NEVADA 89118				PROJECT ADDRESS: 5052 SOUTH JONES BOULEVARD LAS VEGAS, NEVADA 89118	PHASE AS-BUILT SUBMITTAL
					COMPANY CONTACT: LOUIS CARNESALE 702-466-0444				PROJECT NUMBER: 002-01-24-002	SHEET NAME AS-BUILT FLOOR PLAN
										SHEET NO. A1.00