


14850 CONFERENCE CENTER DRIVE

2ND FLOOR

Suite #275 5,867 RSF
As-built

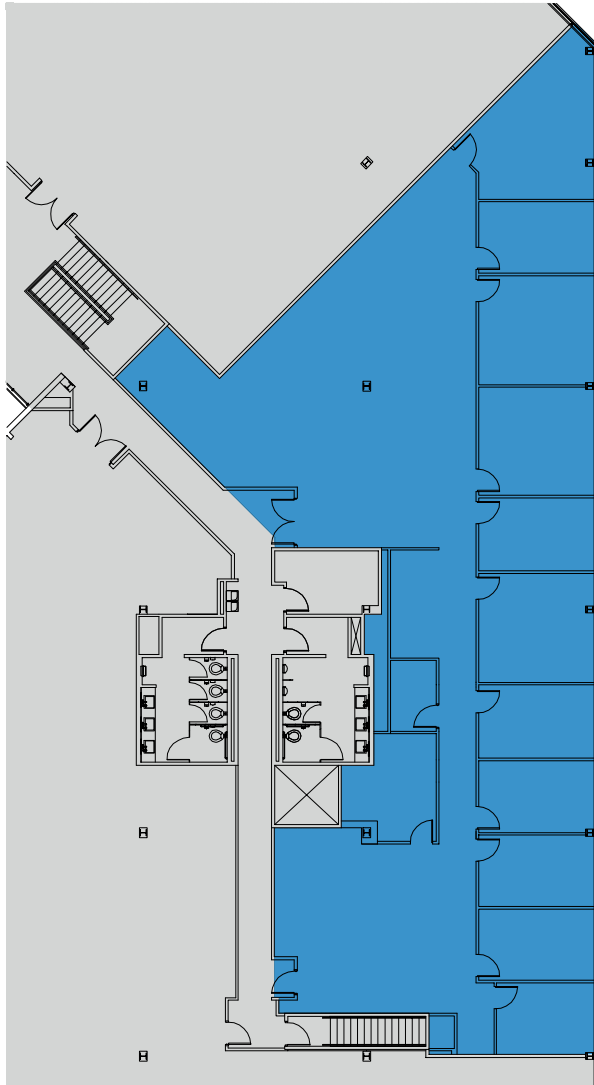

Suite #275 5,867 RSF
Hypothetical spec suite

