


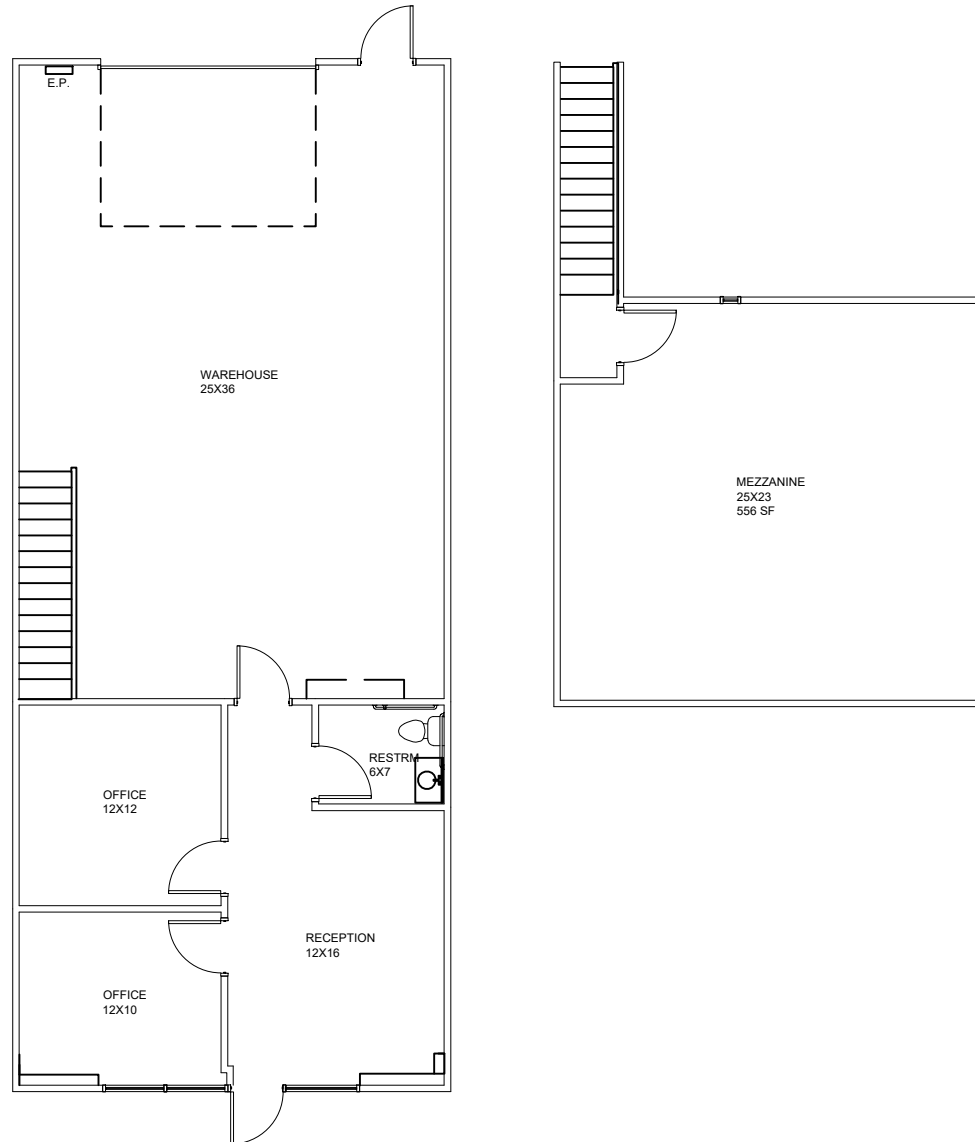

SUITE 105-C--2,082 RSF

SCALE: N.T.S.

# AS-BUILT PLAN

105 ENTERPRISE DRIVE  
CUMMING, GA 30040

3.27.23

ARCHITECTURAL DESIGN INNOVATIONS

ADI, Inc.