
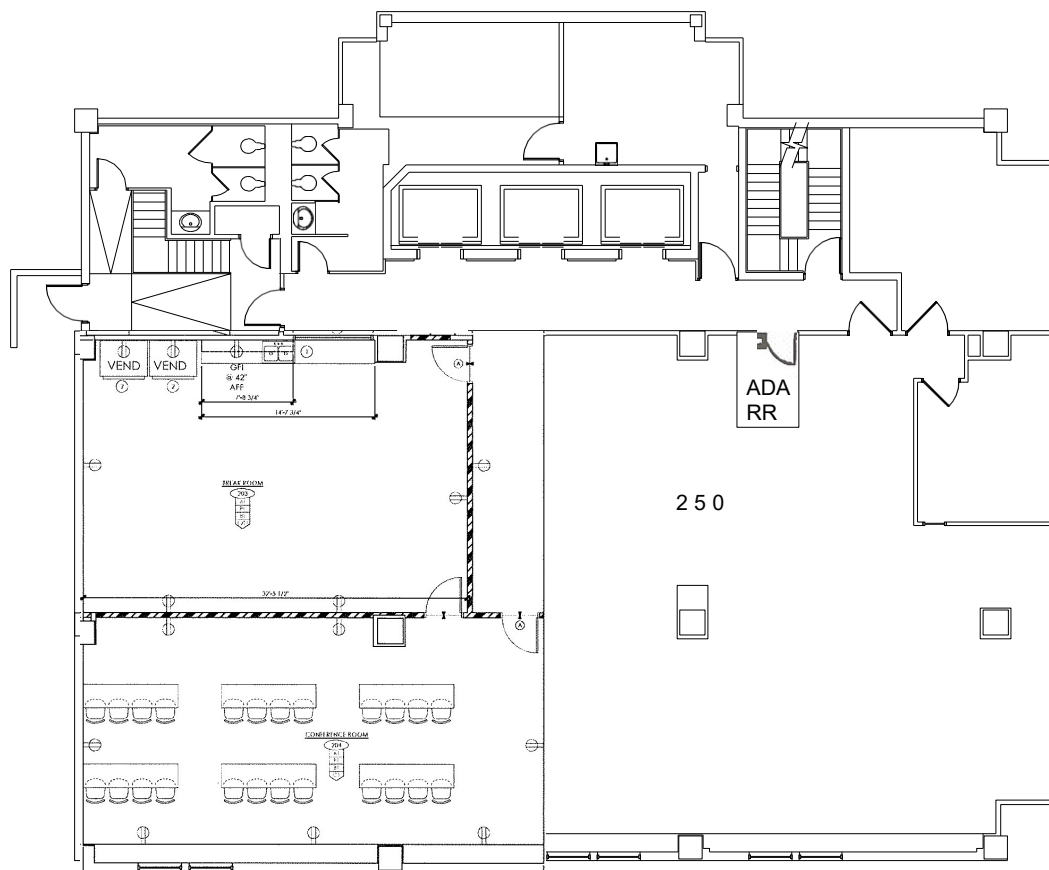


SUITE 200  
 Conference Room / Break Room  
 1995 RSF

SUITE 250  
 AVAILABLE  
 2549 RSF

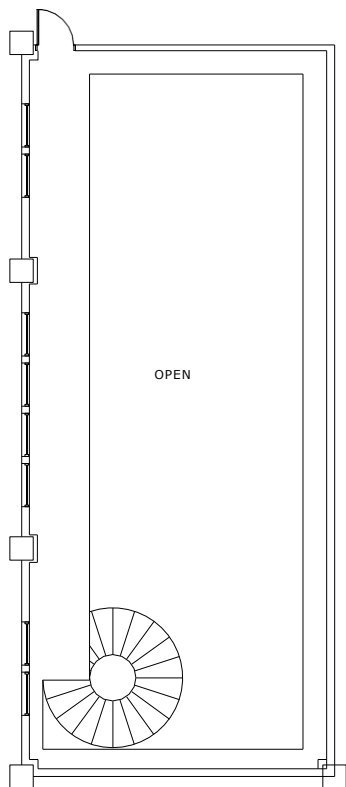

**2ND FLOOR  
 PLAN**

SOUTHLAND  
 TOWER  
 2ND FLOOR



10.25.2019

.....

**A FLOOR PLAN**

SCALE: N.T.S.



NORTH

AS-BUILT  
 PLAN

**AS.2**