
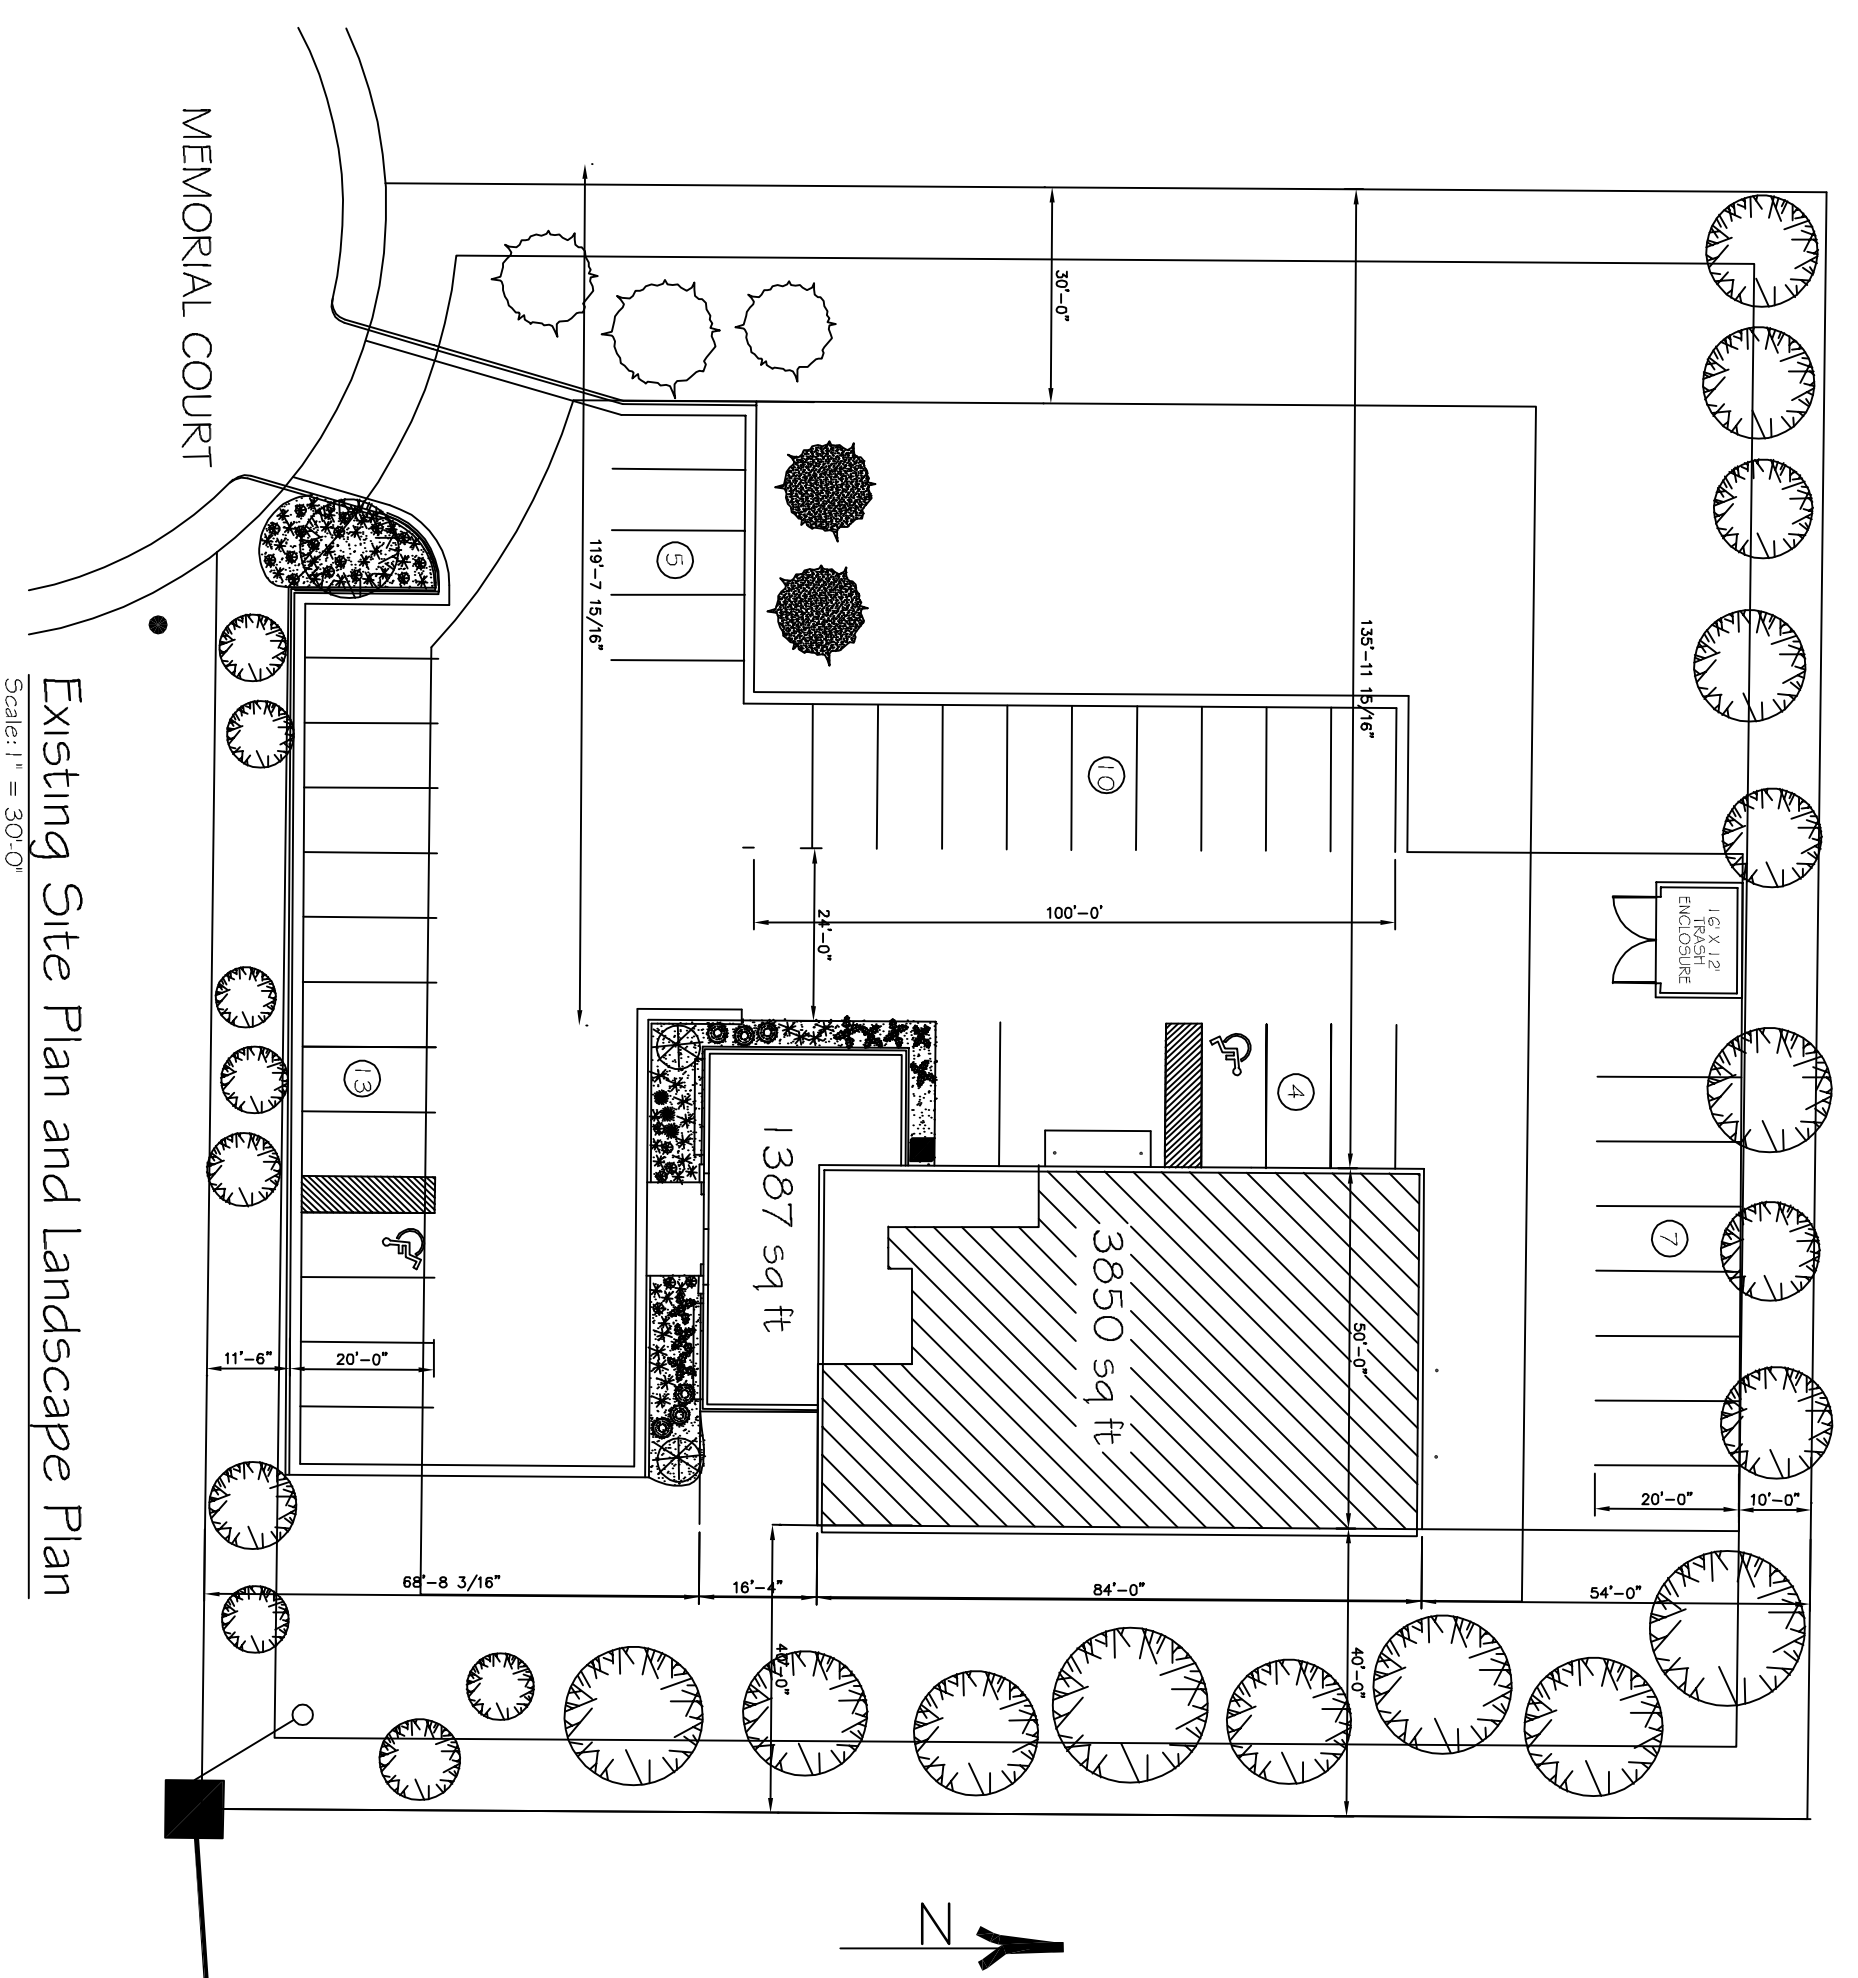
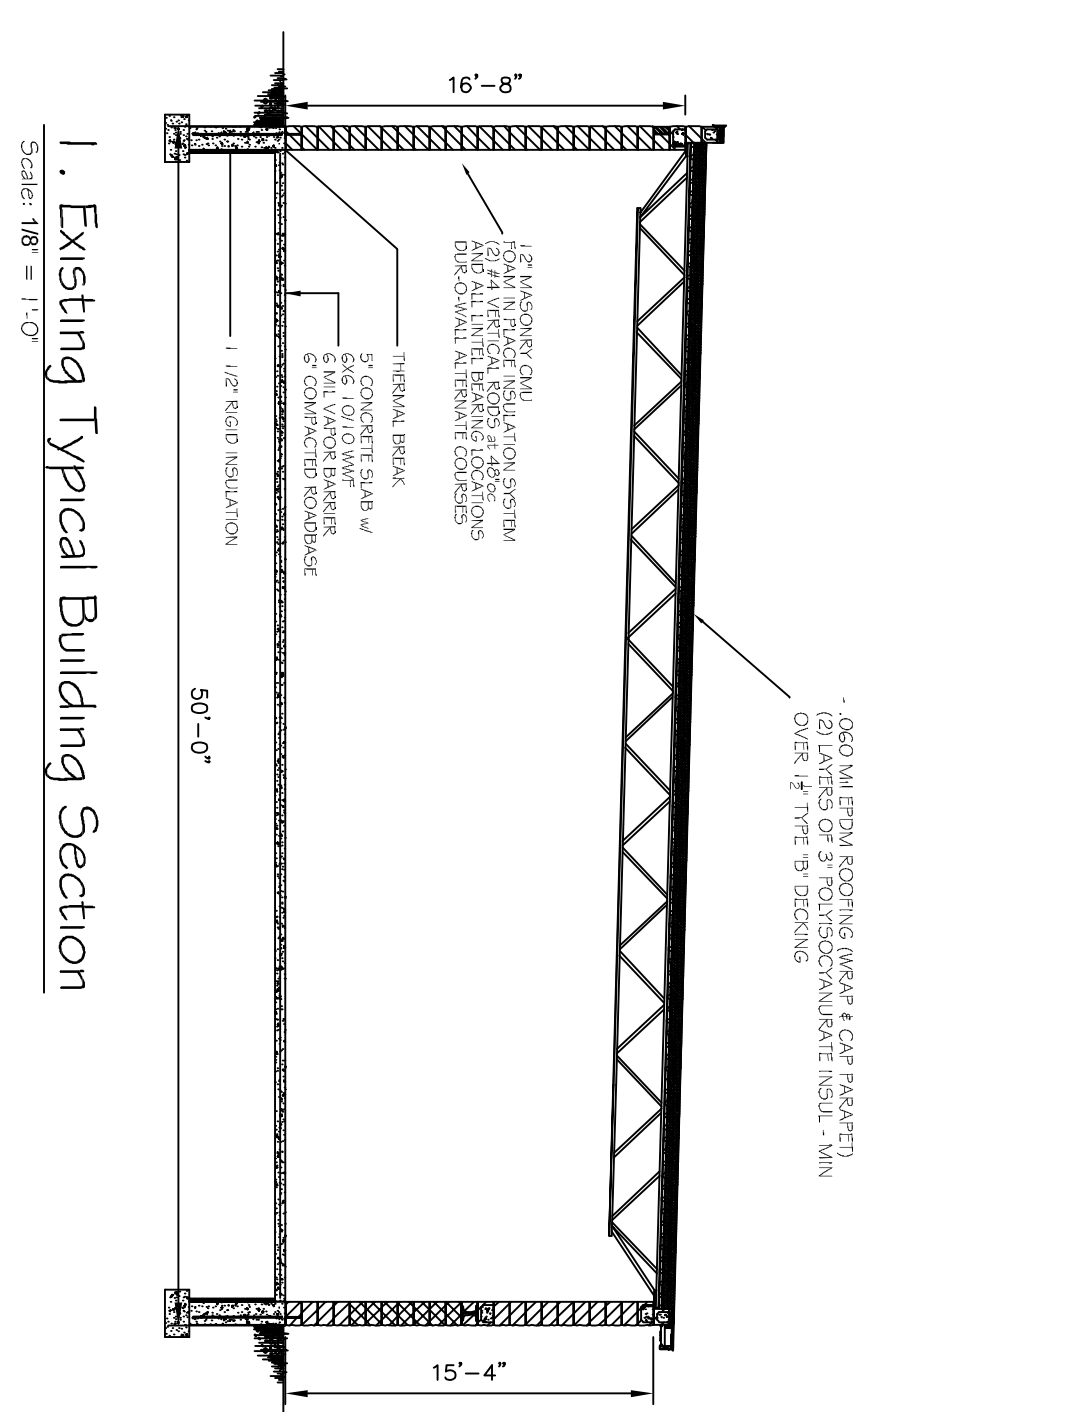


BUILDING INFORMATION
 Existing Building = 5,237 Sq Ft
 NON SPRINKLERED
 Construction Type = I I B
 Occupancy Classification = B

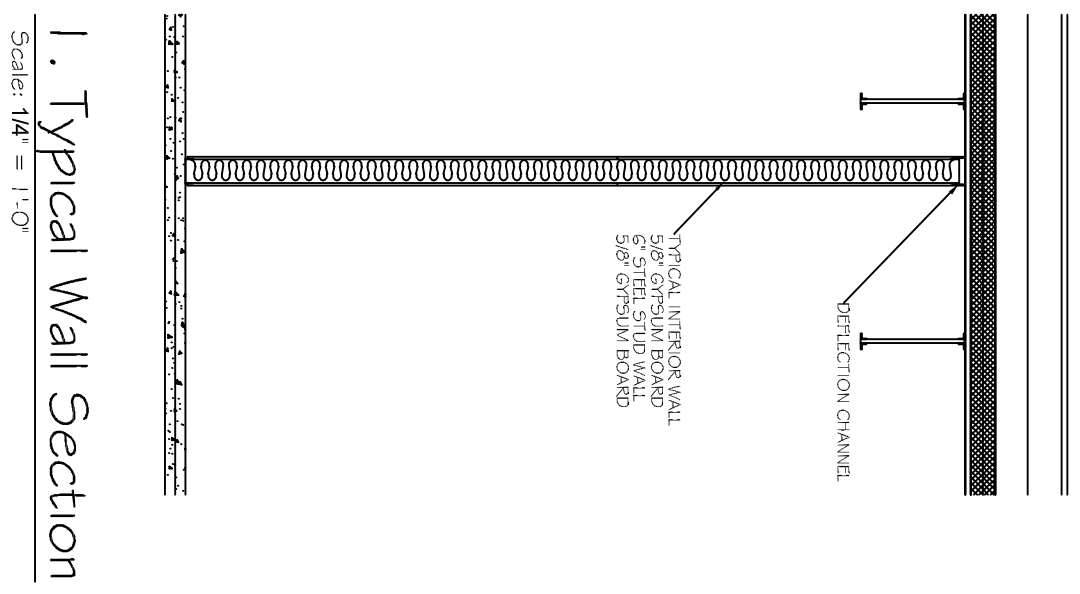

GENERAL PLAN NOTES

- ALL DIMENSIONS REFERENCED TO SURF UNLESS NOTED OTHERWISE
- HATCHED AREAS TO BE REMOVED AND MANHOLE AND TRENCH LOCATIONS TO BE RELOCATED TO BE SHOWN ON THE EXISTING CONSTRUCTION TIME
- HATCHED AREAS TO BE REMOVED AND MANHOLE AND TRENCH LOCATIONS TO BE SHOWN ON THE EXISTING CONSTRUCTION TIME

SHEET INDEX

A1 - Floor Plan / Site Plan

DATE:
 DESIGN NO.:

PROJECT:
 5705 & 5703 Memorial Court
 Weston, WI 54476

PDM
 CONSTRUCTION LLC

162856 Foxwood Ct.
 Wausau, WI 54403
 Phone: (715) 355-4700

OWNER:
 AY LLC
 8600 White Pine Court
 Wausau, WI 54403

REVISIONS: