



FLOOR PLAN

BUILDING A

SUITE 1307 - 1,683 SF

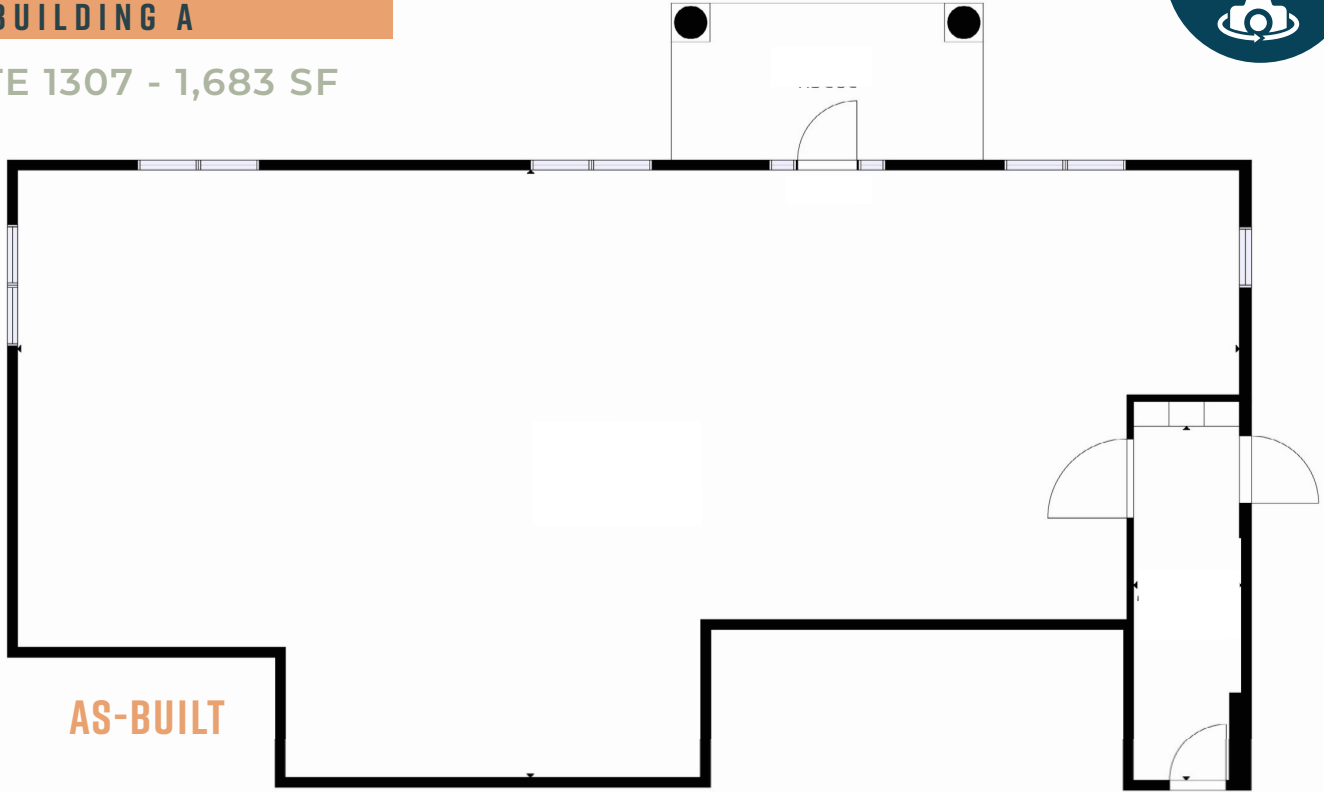

AS-BUILT

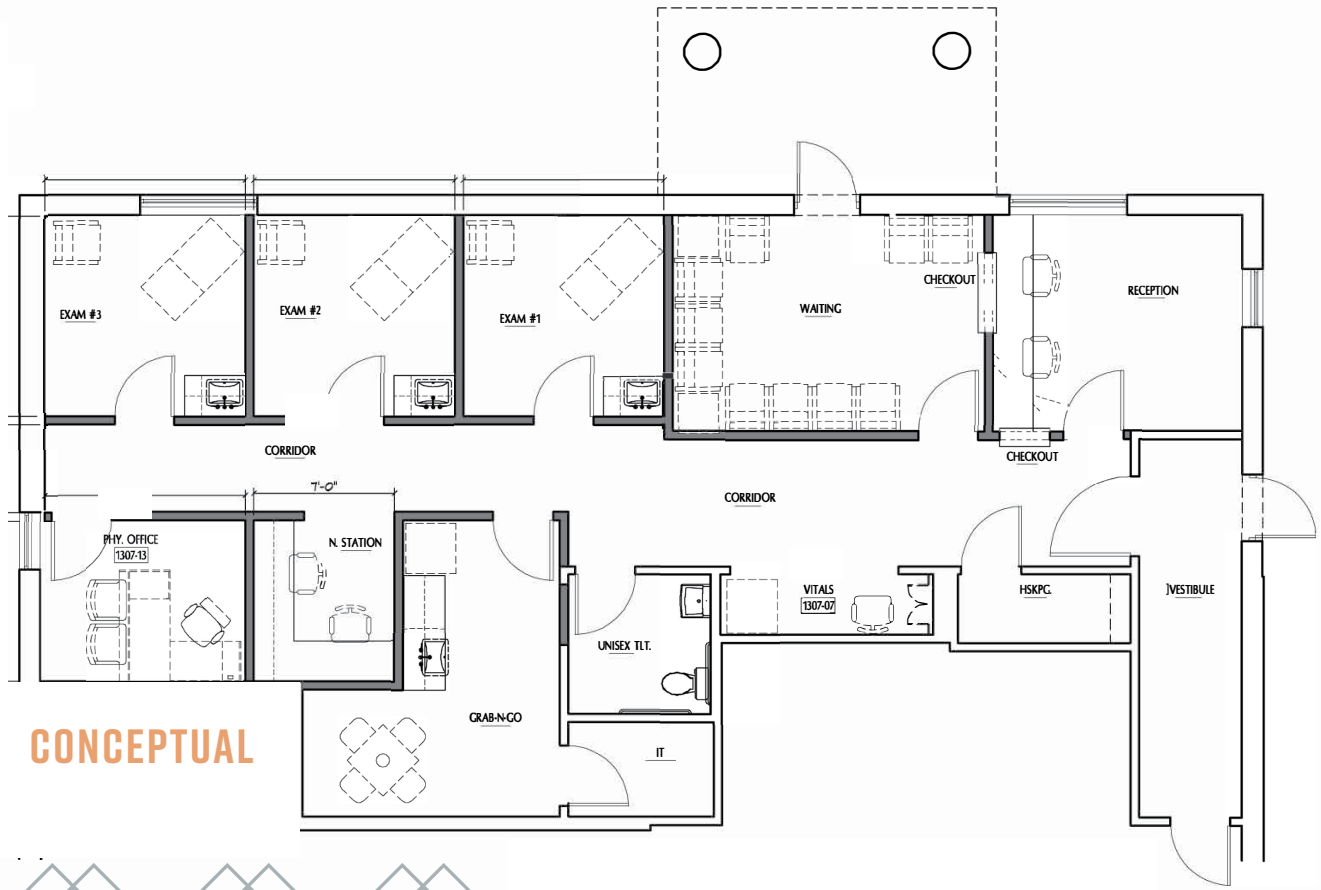

CONCEPTUAL

