
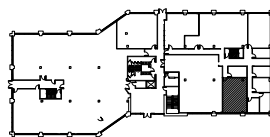


TWIN CENTRAL OFFICE BUILDING

1401 N. Central, Richardson, Texas

SUITE 135
716 RSF

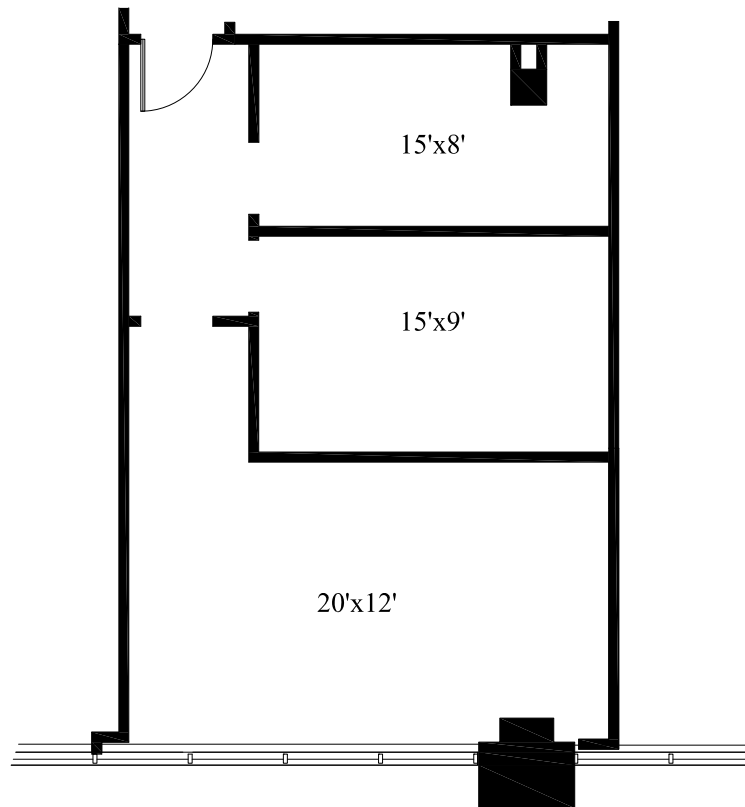

1ST FLOOR

Scale: 1/8"=1'-0"

All dimensions and square footages are approximate.

June 7, 2017

