


# AS-BUILT

6TH FLOOR - 29,106 SF



AT 385 INTERLOCKEN

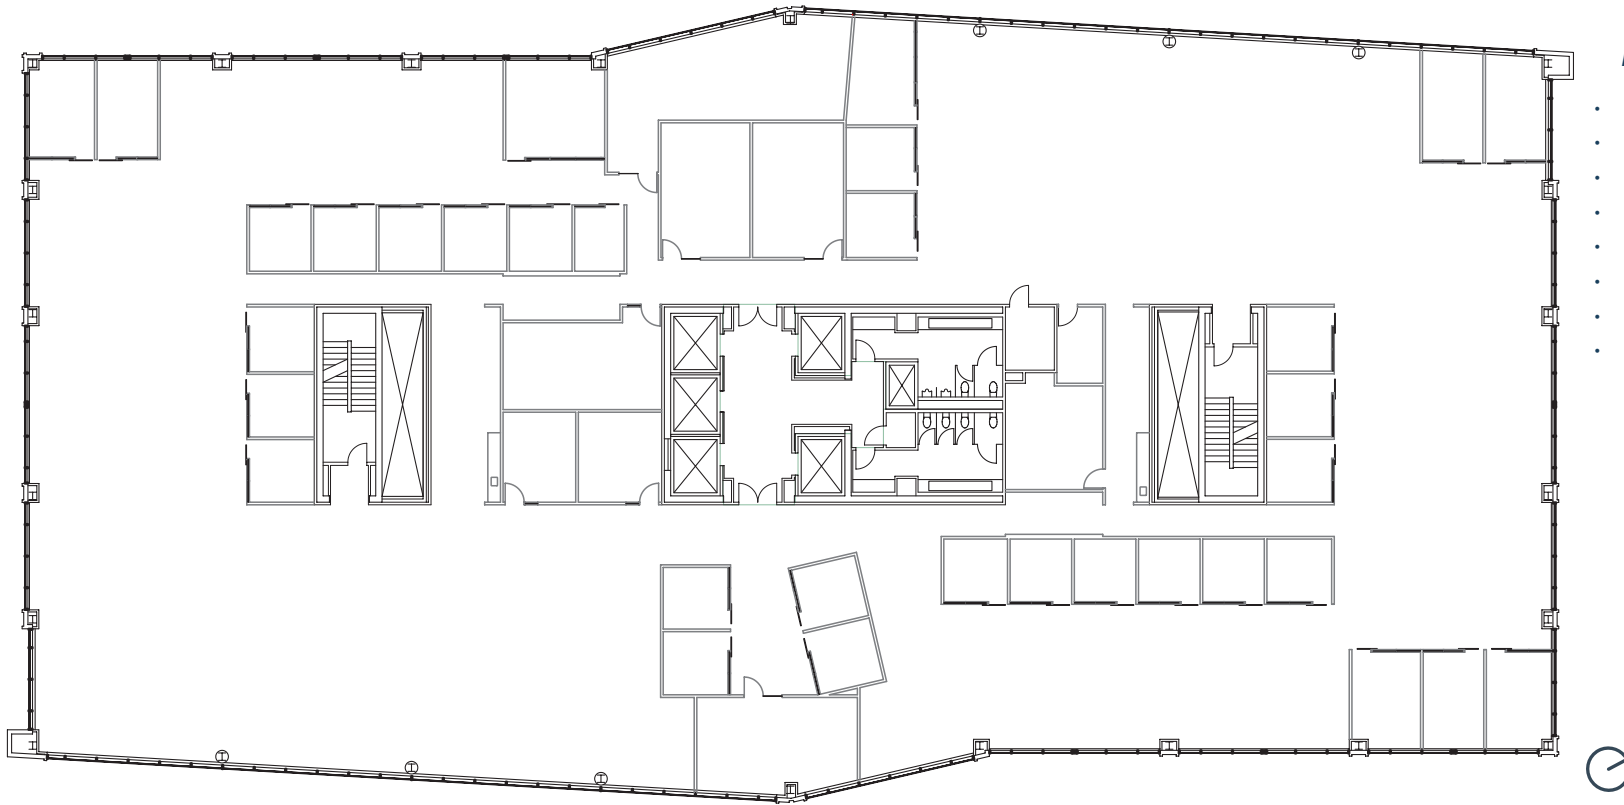

## FEATURES

- Open space for workstations
- 28 private offices
- 6 conference room
- 2 phone rooms
- 1 reception
- 1 break area
- 1 IT room
- 1 storage room



**Jonathan Shirazi**

+1 303 217 7968

jonathan.shirazi@jll.com

**James Roupp**

+1 303 579 8745

james.roupp@jll.com



**CYPRESS**  
OFFICE PROPERTIES