



Key Plan

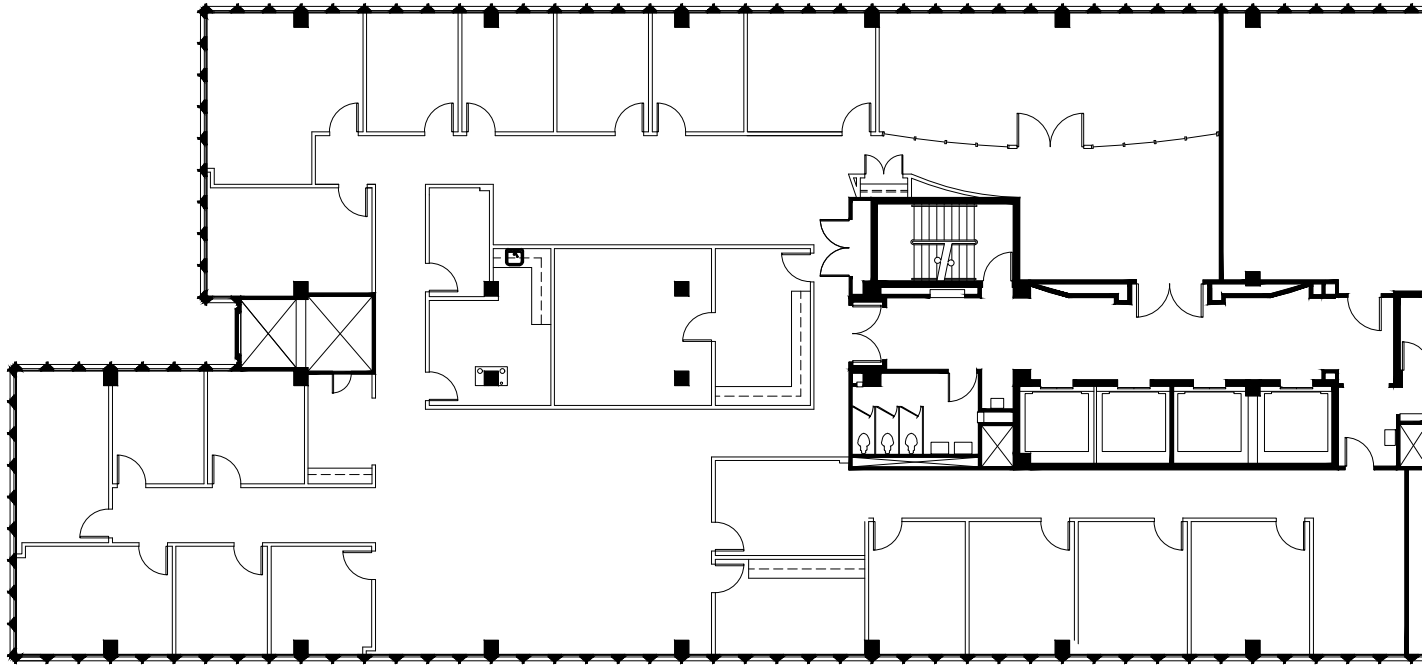

North

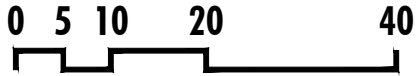

PEACHTREE CENTER

TRANSWESTERN

NELSON Tower 235 • Suite 2100 • 8,200 RSF

As Built