

THUNDERBIRD
MEDICAL
PLAZA III

5310 W THUNDERBIRD ROAD, GLENDALE, AZ 85306


Floor 02

Suite 200

AS-BUILT

3,836 SF

AVAILABLE

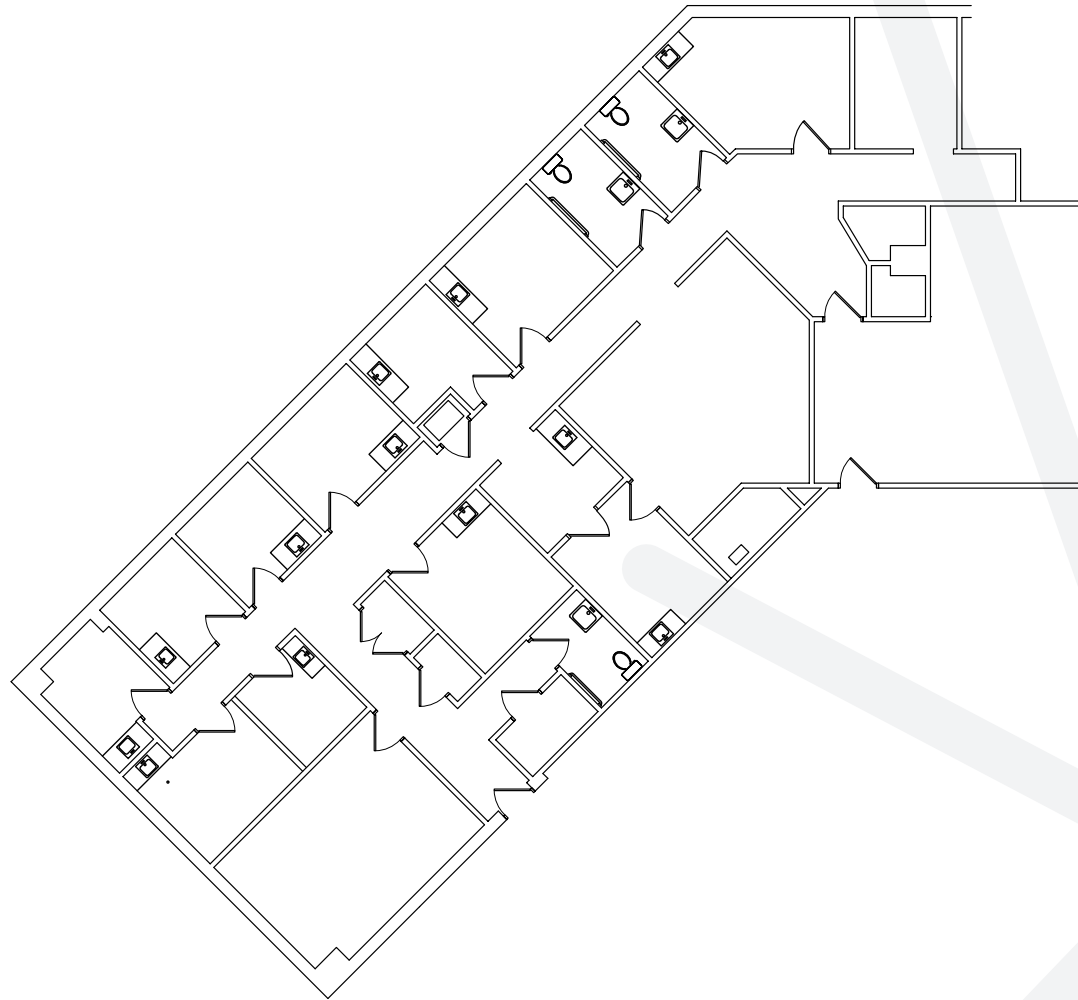

RACHAEL THOMPSON
Senior Vice President
602.513.5122
rachael.thompson@kidder.com

PERRY GABUZZI, CCIM
Executive Vice President
602.513.5116
perry.gabuzzi@kidder.com