

# 4000 Park Road



4000 Park Rd.  
Charlotte, NC

Level  
Three

As Built  
Plan

11/07/2025

Not to Scale

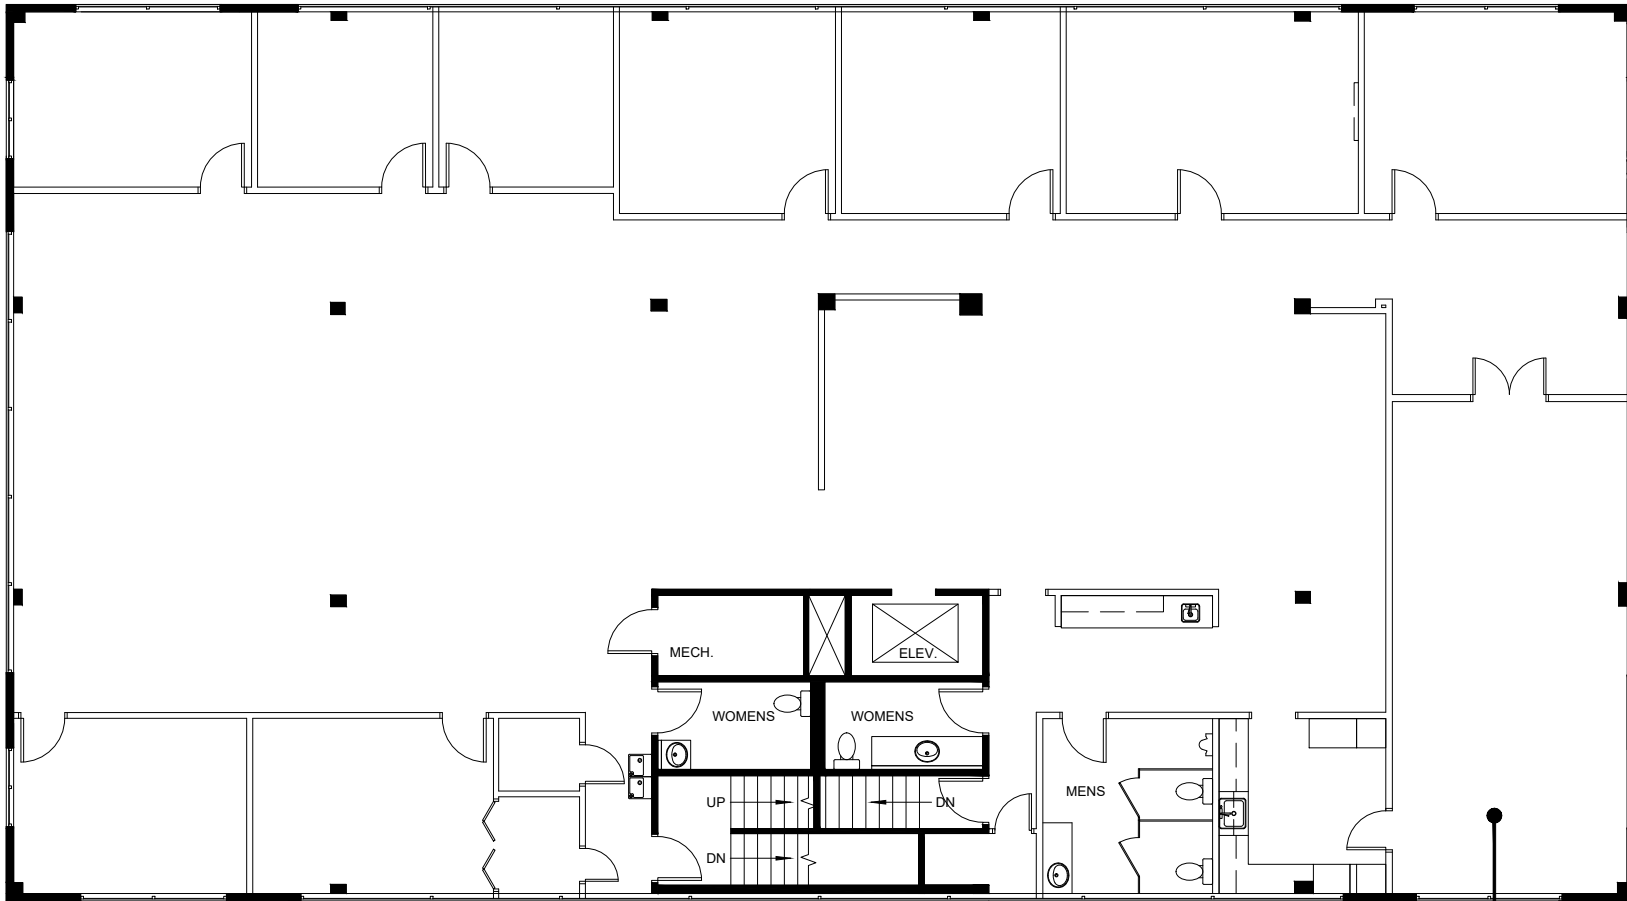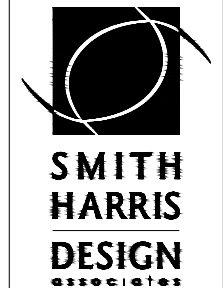

AVAILABLE  
SUITE 300  
5,024 SQ FT