



1 AS-BUILT CELLAR FLOOR PLANS
1/8" = 1'-0"



SOIFER DESIGN ASSOCIATES INC.
ARCHITECTURAL CONCEPTS, SPACE LAYOUT AND DESIGN

59 LIVINGSTON AVENUE, STATEN ISLAND, NY 11204
P: 718.414.1700 F: 718.234.0343 E: info@soiferdesign.com

YESHIVAH VYELIPOL

860 EAST 27TH STREET
BROOKLYN, NY 11210

No.	DATE	DESCRIPTION	BY

AS-BUILT FLOOR PLANS			
Project #	22222	EX-100	
Date	7/5/2022		
Scale:	1/8" = 1'-0"		
Sheet Issue Date:	06/23/22	PAGE	

** CONCEPTUAL DESIGN NOT FOR CONSTRUCTION **



1 AS BUILT FIRST FLOOR PLAN
1/8" = 1'-0"



SOIFER DESIGN ASSOCIATES INC.
ARCHITECTURAL CONCEPTS, SPACE LAYOUT AND DESIGN

59 LIVINGSTON AVENUE, STATEN ISLAND, NY 11204
P: 718.414.1700 F: 718.234.0343 E: info@soiferdesign.com

YESHIVAH VYELIPOL

860 EAST 27TH STREET
BROOKLYN, NY 11210

No.	DATE	DESCRIPTION	BY

AS-BUILT FLOOR PLANS			
Project #	22222	EX-101	
Date	7/5/2022		
Scale:	1/8" = 1'-0"		
Sheet Issue Date:	06/23/22		
PAGE			

** CONCEPTUAL DESIGN NOT FOR CONSTRUCTION **



1 AS-BUILT SECOND FLOOR PLAN
1/8" = 1'-0"



SOIFER DESIGN ASSOCIATES INC.
ARCHITECTURAL CONCEPTS, SPACE LAYOUT AND DESIGN

59 LIVINGSTON AVENUE, STATEN ISLAND, NY 11204
P: 718.414.1700 F: 718.234.0343 E: info@soiferdesign.com

YESHIVAH VYELIPOL

860 EAST 27TH STREET
BROOKLYN, NY 11210

No.	DATE	DESCRIPTION	BY

AS-BUILT FLOOR PLANS			
Project #	22222	EX-102	
Date	7/5/2022		
Scale:	1/8" = 1'-0"		
Sheet Issue Date:	06/23/22	PAGE	

** CONCEPTUAL DESIGN NOT FOR CONSTRUCTION **



1 AS-BUILT THIRD FLOOR PLAN
1/8" = 1'-0"



SOIFER DESIGN ASSOCIATES INC.
ARCHITECTURAL CONCEPTS, SPACE LAYOUT AND DESIGN

59 LIVINGSTON AVENUE, STATEN ISLAND, NY 11204
P: 718.414.1700 F: 718.234.0343 E: info@soiferdesign.com

YESHIVAH VYELIPOL

860 EAST 27TH STREET
BROOKLYN, NY 11210

No.	DATE	DESCRIPTION	BY

AS-BUILT FLOOR PLANS			
Project #	22222	EX-103	
Date	7/5/2022		
Scale:	1/8" = 1'-0"		
Sheet Issue Date:	06/23/22	PAGE	

** CONCEPTUAL DESIGN NOT FOR CONSTRUCTION **



1 AS-BUILT FOURTH FLOOR PLAN
1/8" = 1'-0"



SOIFER DESIGN ASSOCIATES INC.
ARCHITECTURAL CONCEPTS, SPACE LAYOUT AND DESIGN

59 LIVINGSTON AVENUE, STATEN ISLAND, NY 11204
P: 718.414.1700 F: 718.234.0343 E: info@soiferdesign.com



YESHIVAH VYELIPOL

860 EAST 27TH STREET
BROOKLYN, NY 11210

No.	DATE	DESCRIPTION	BY

AS-BUILT FLOOR PLANS			
Project #	22222	EX-104	
Date	7/5/2022		
Scale:	1/8" = 1'-0"		
Sheet Issue Date:	08/11/22		
PAGE			

** CONCEPTUAL DESIGN NOT FOR CONSTRUCTION **

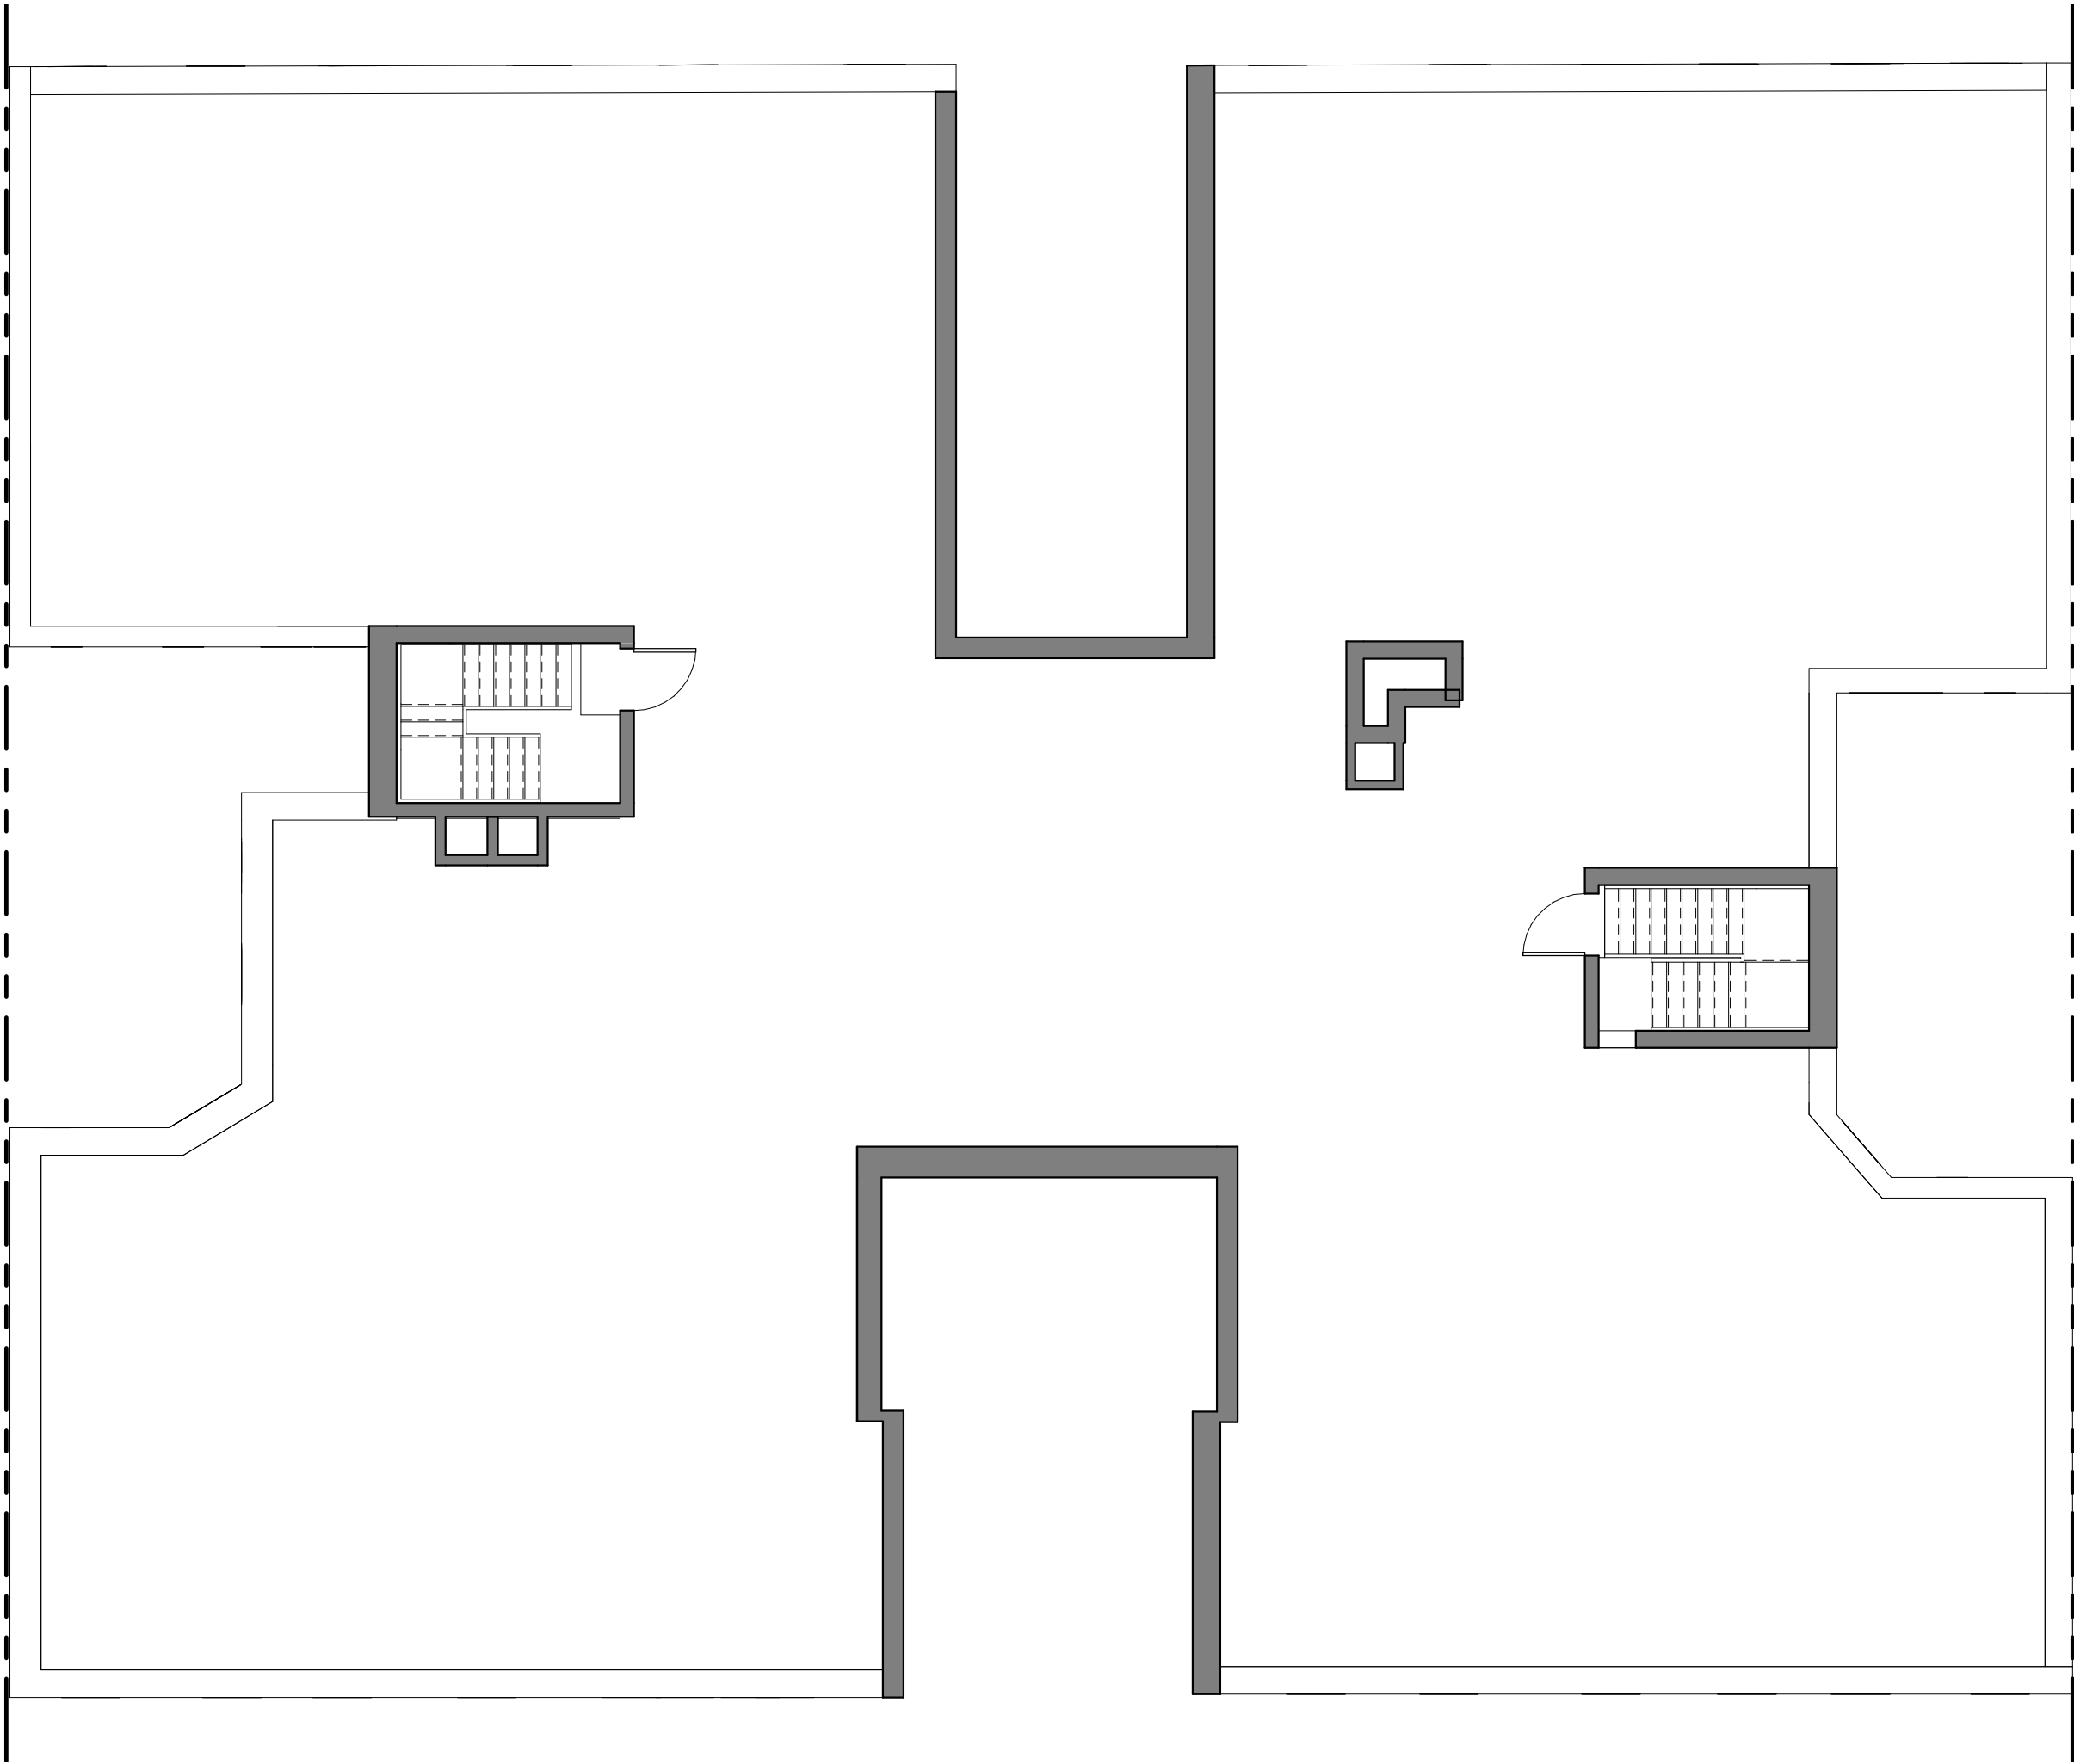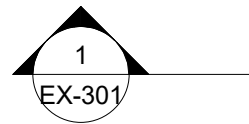

1 AS-BUILT ROOF PLAN
1/8" = 1'-0"



SOIFER DESIGN ASSOCIATES INC.
ARCHITECTURAL CONCEPTS, SPACE LAYOUT AND DESIGN

59 LIVINGSTON AVENUE, STATEN ISLAND, NY 11204
P: 718.414.1700 F: 718.234.0343 E: info@soiferdesign.com


YESHIVAH VYELIPOL

860 EAST 27TH STREET
BROOKLYN, NY 11210

No.	DATE	DESCRIPTION	BY

AS-BUILT FLOOR PLANS			
Project #	22222	EX-105	
Date	7/5/2022		
Scale:	1/8" = 1'-0"		
Sheet Issue Date:	08/11/22	PAGE	

** CONCEPTUAL DESIGN NOT FOR CONSTRUCTION **

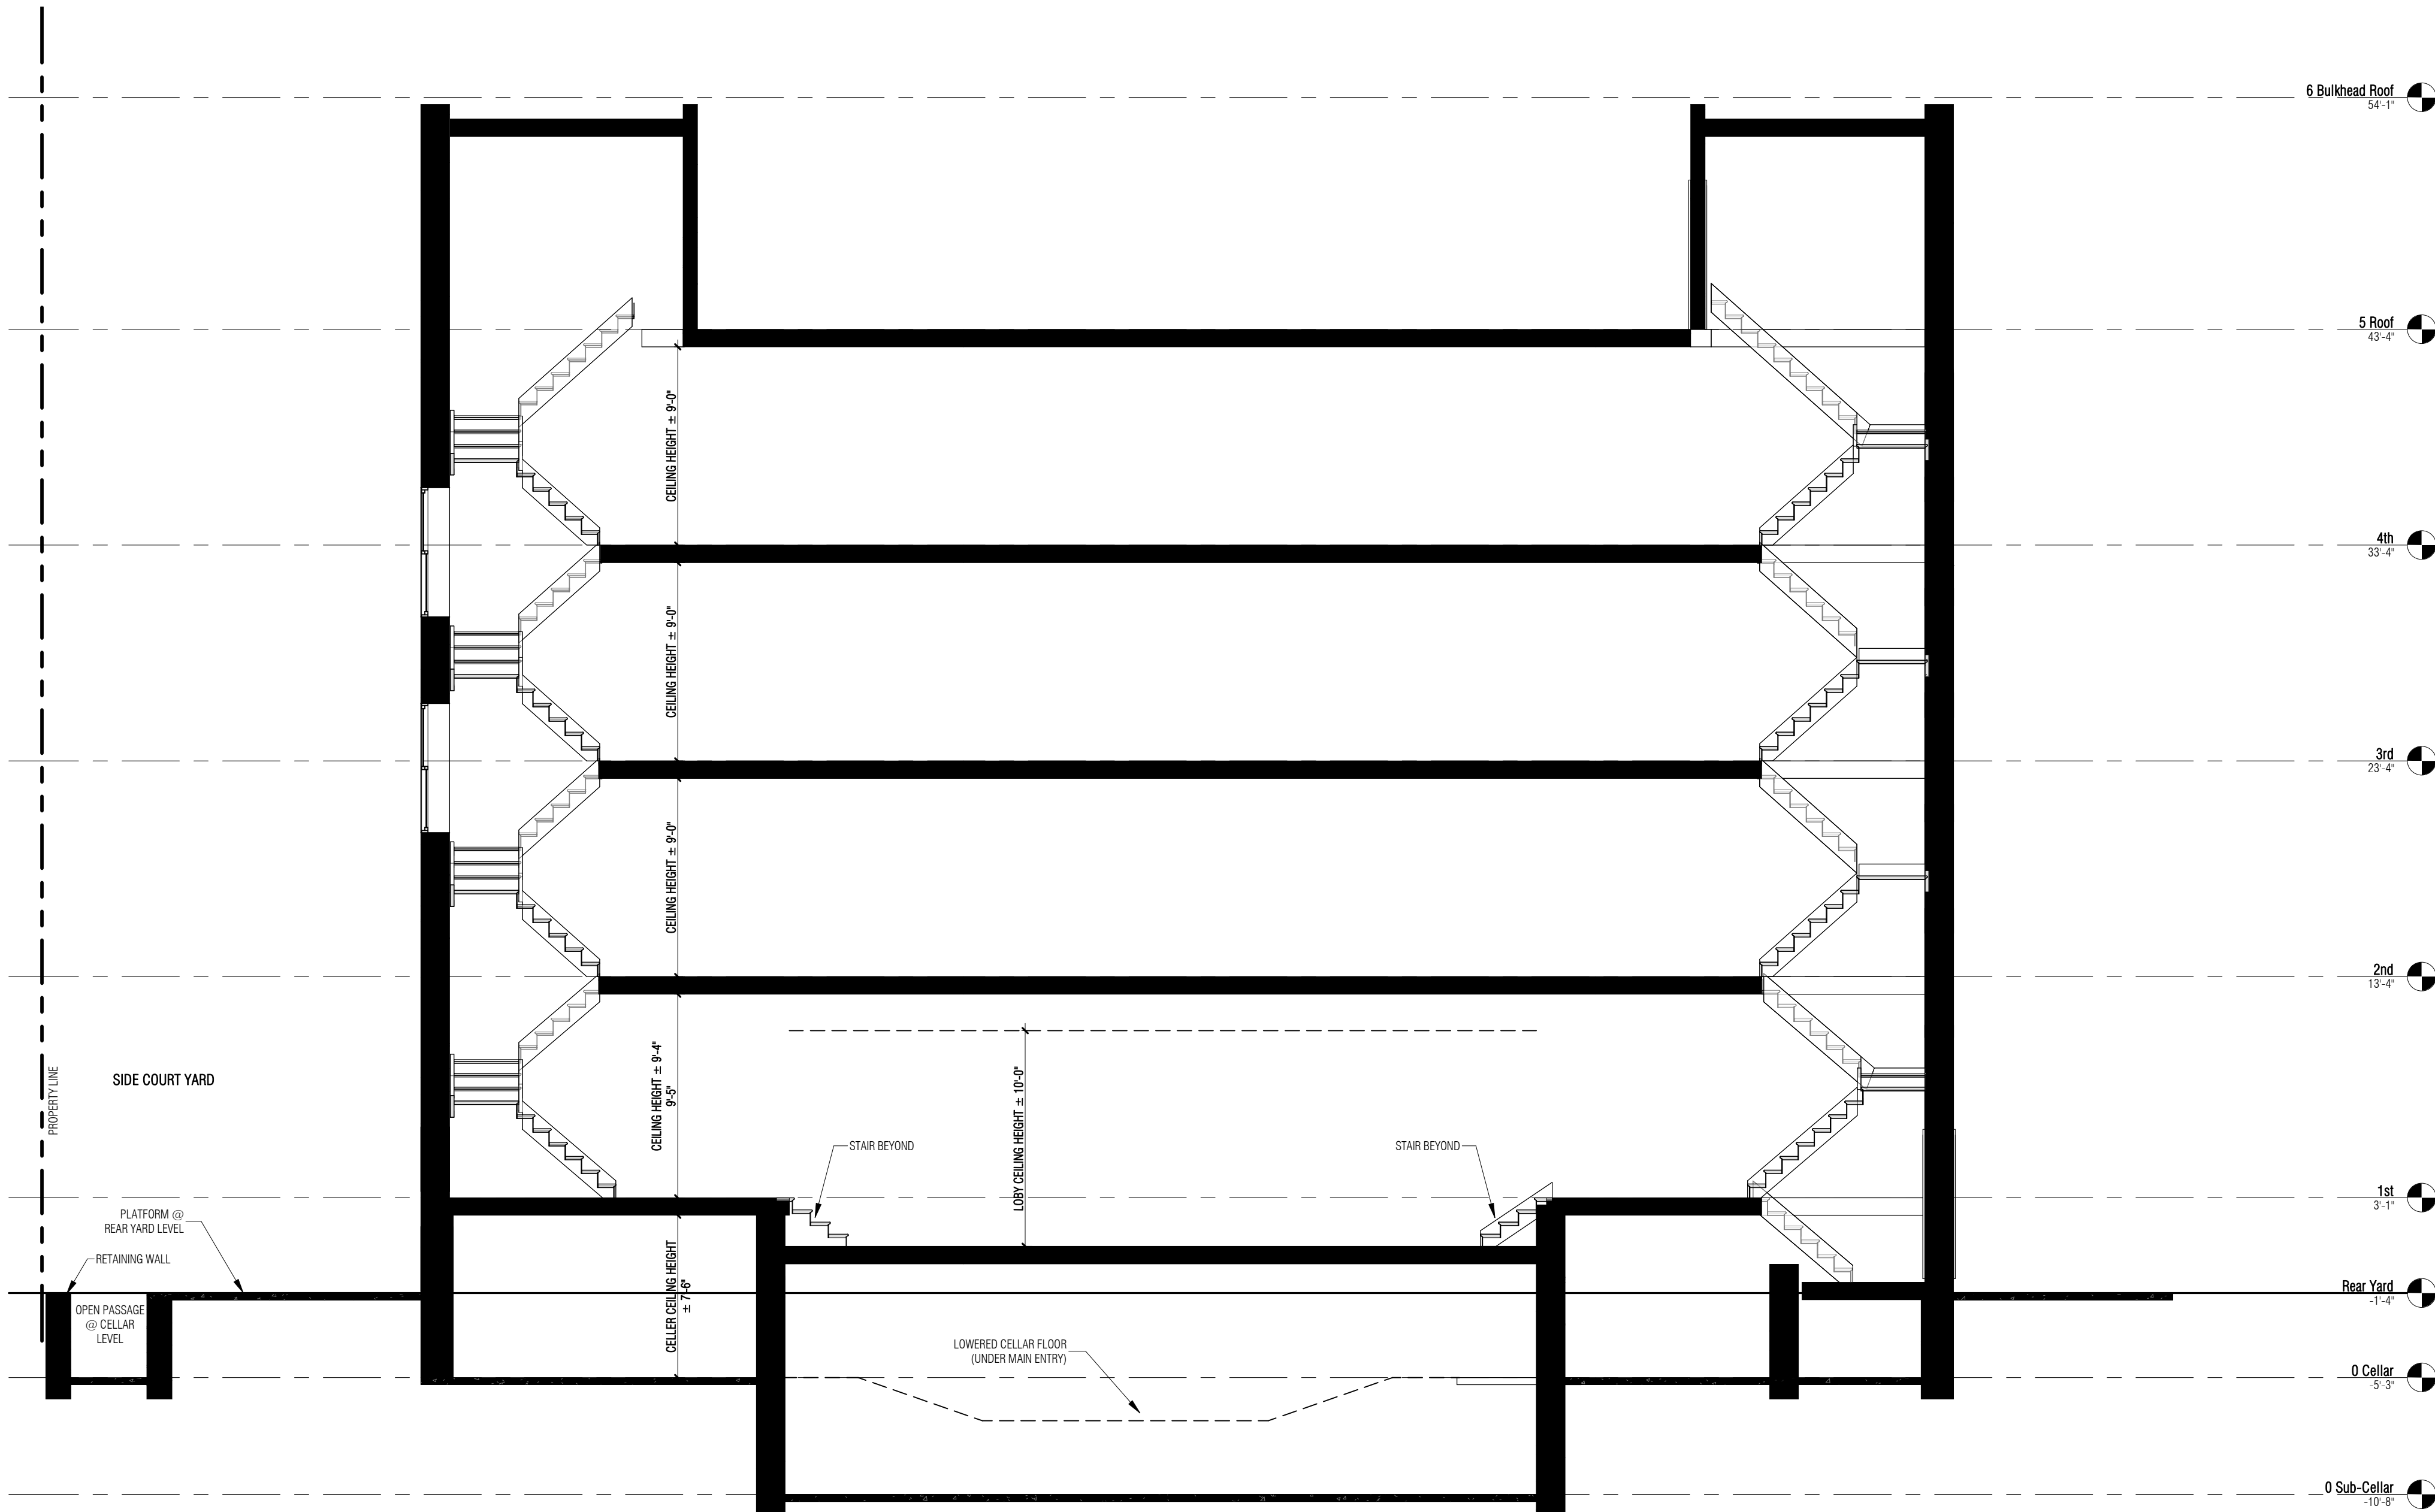

1 AS BUILT LONG SECTION VIEW
3/16" = 1'-0"



SOIFER DESIGN ASSOCIATES INC.
ARCHITECTURAL CONCEPTS, SPACE LAYOUT AND DESIGN

59 LIVINGSTON AVENUE, STATEN ISLAND, NY 11204
P: 718.414.1700 F: 718.234.0343 E: info@soiferdesign.com

YESHIVAH VYELIPOL

860 EAST 27TH STREET
BROOKLYN, NY 11210

No.	DATE	DESCRIPTION	BY

AS BUILS SECTION VIEWS		
Project #	22222	EX-301
Date	7/5/2022	
Scale:	3/16" = 1'-0"	
Sheet Issue Date:	07/05/22	
PAGE		

** CONCEPTUAL DESIGN NOT FOR CONSTRUCTION **