

1


Reduced As-built

Suite 1304

Scale: 1/8" = 1'-0"



North

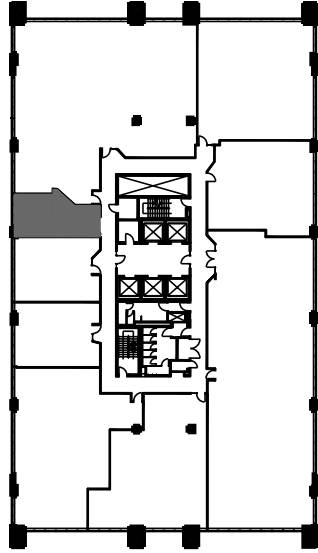

Proximity Plan

Suite 1304

The Chancery

564 RSF

The Chancery
Level Thirteen; Suite 1304
1120 Lincoln Street
Denver, Colorado 80203