


SUITE 5174: 3,075 SF

Includes 852 SF Office Space

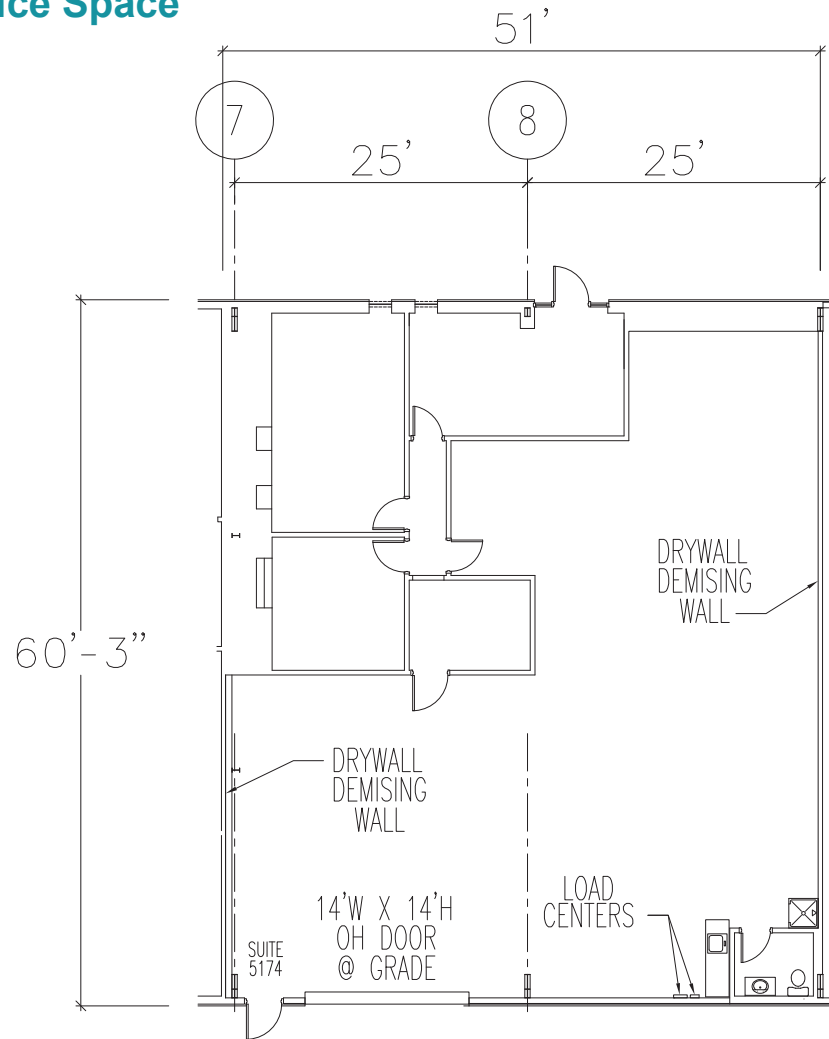

SUNSHINE INDUSTRIAL PARK
 5174 126th Ave N
 Clearwater, FL 337600

No warranty or representation, expressed or implied, is made to the accuracy of information contained herein, and same is submitted subject to errors, change of price, rental or other conditions, withdrawal without notice, and to any special listing conditions imposed by our principals. PLANS NOT TO SCALE

BRAD HUTTON
 813.793.8492
 Brad.Hutton@FranklinSt.com

PATRICK KELLY
 813.682.6210
 Pat.Kelly@FranklinSt.com

REID DOMINGUEZ
 813.291.2658
 Reid.Dominguez@FranklinSt.com

FranklinStreet
 Licensed Real Estate Broker | FranklinSt.com