


AS-BUILT FLOOR PLAN

SCALE: 3/16" = 1'-0"

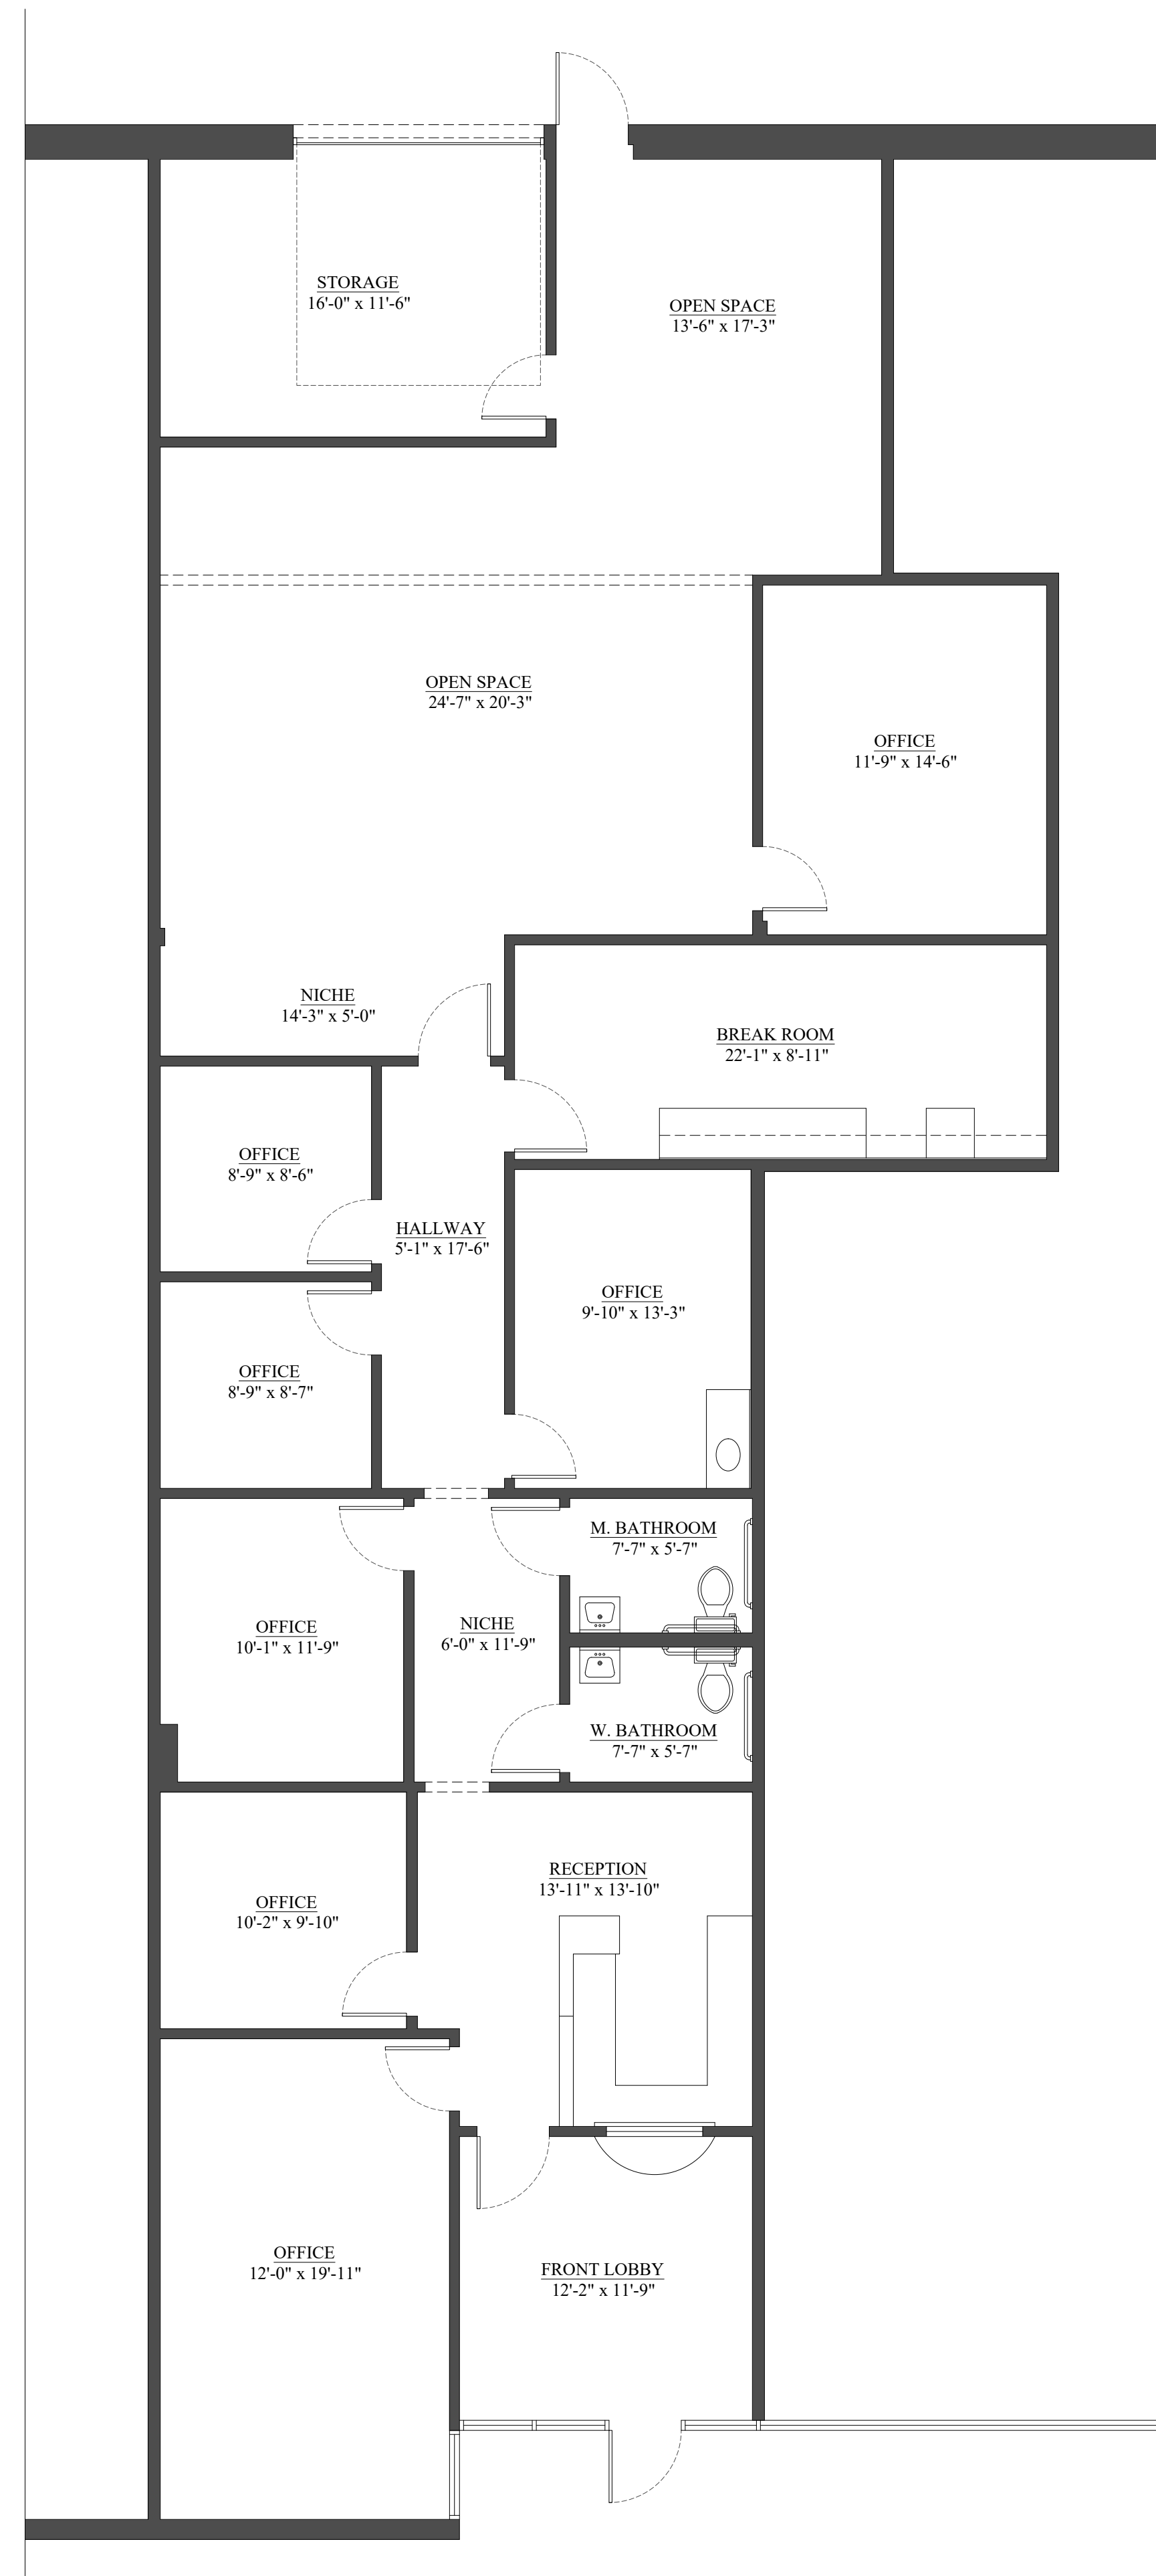

CLIENT: **820 BUSINESS PARK**
 2906 SE LOOP 820, SUITE G
 FORT WORTH, TX 76140
 PH: (469) 835-7552

PROJECT: **3010 SPACE
 EXISTING CONDITION**
 3010 SE LOOP 820, FORT
 WORTH, TX 76140

SHEET TITLE:
AS- BUILT

NO.	REVISION/ISSUED	DATE

DRAWN BY: F. CANOURA

CHECKED BY:

DATE: 03-20-23

SCALE: AS NOTED

A1.0