
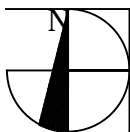


2340 East Beardsley Road

Phoenix . AZ

Suite 110 - 2,588 RSF

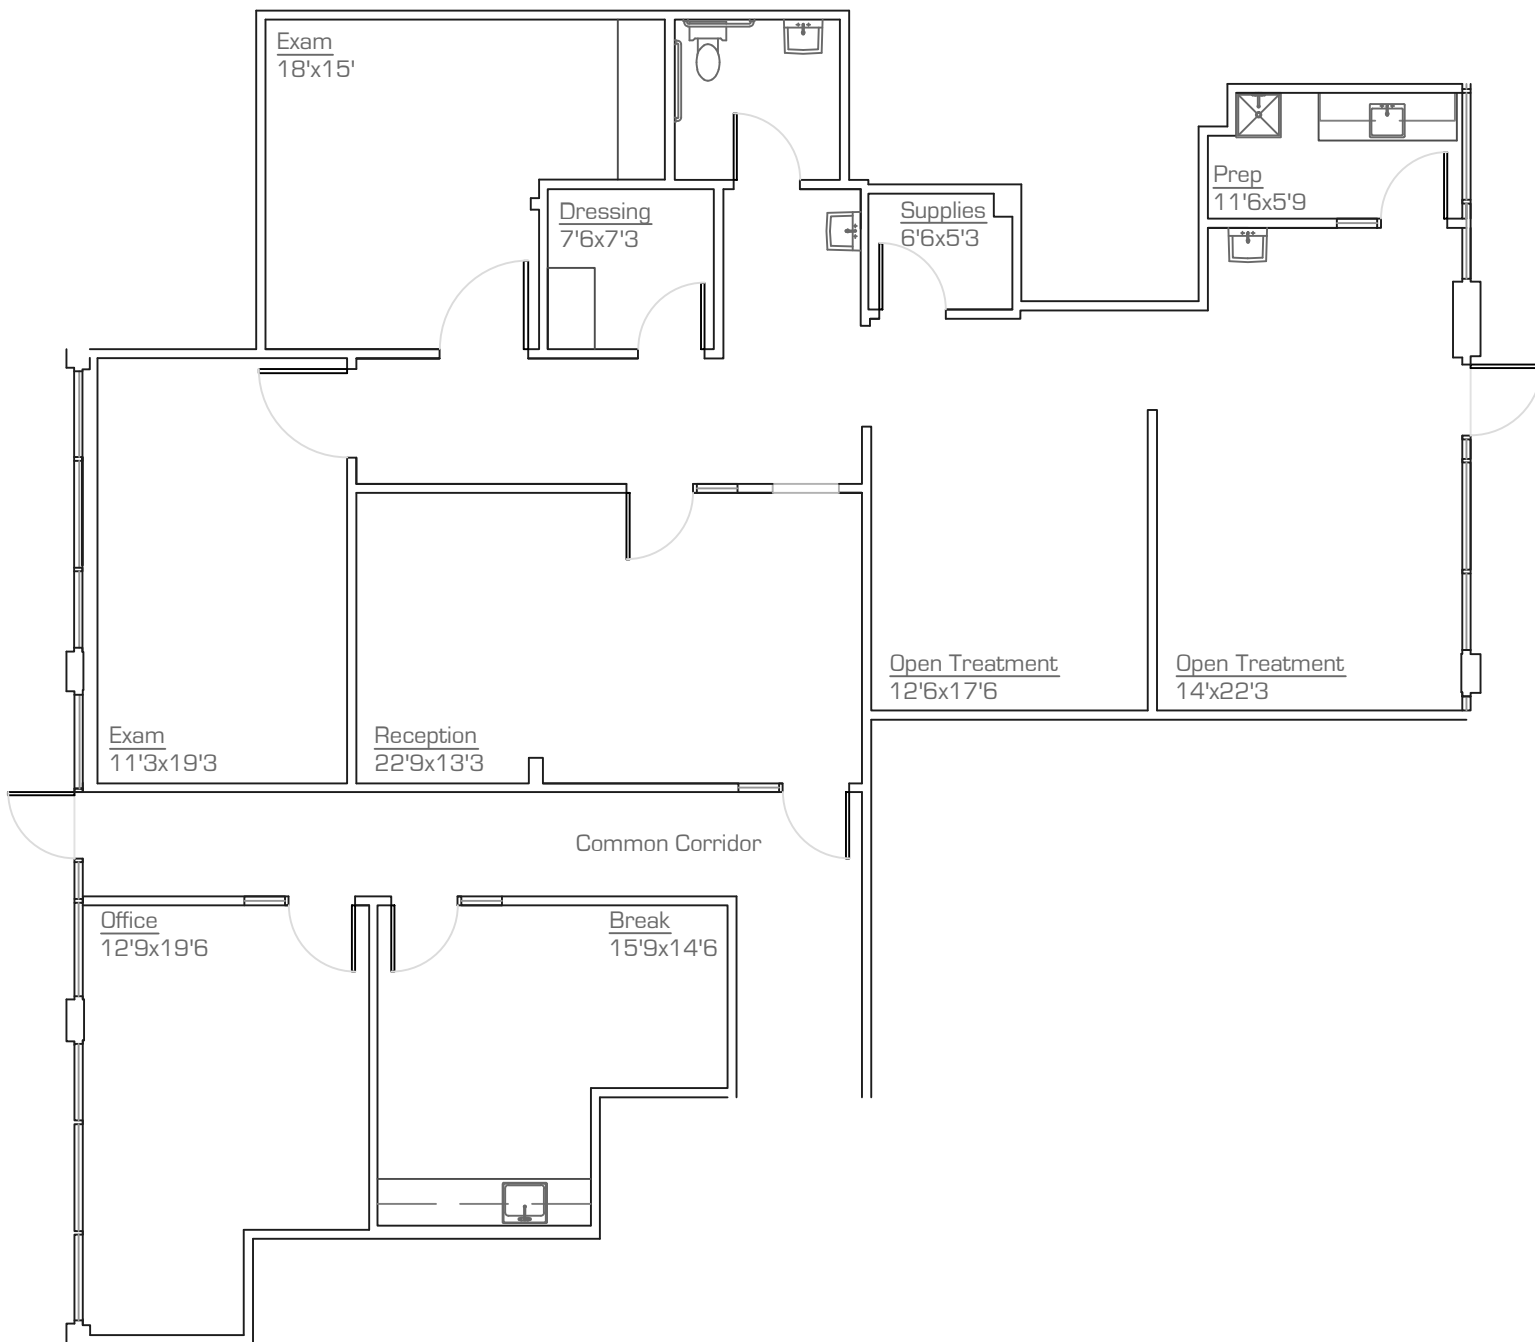

As-Built - Floor Plan

scale: nts

21.May.2024

*All dimensions are approximate at ± 3"

*All information is of general nature

precisionDIMENSIONS

as-built & survey
602.790.6412

