

**BOSWELL
WEST MEDICAL
OFFICE
BUILDING**

10503 W THUNDERBIRD BLVD | SUN CITY, AZ 85351


Floor 01

Suite 101B

AS-BUILT

1,454 SF

AVAILABLE

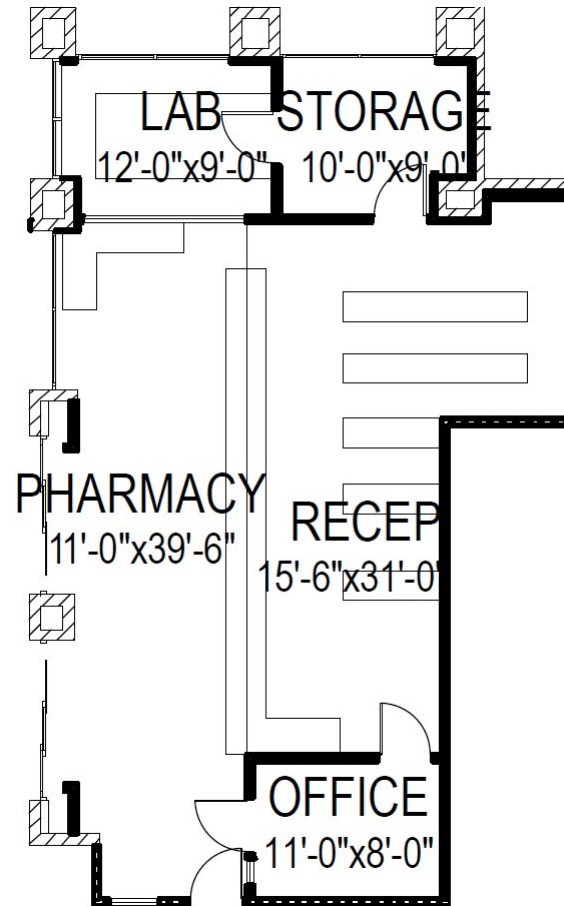

RACHAEL THOMPSON
Senior Vice President
602.513.5122
rachael.thompson@kidder.com

PERRY GABUZZI, CCIM
Senior Vice President
602.513.5116
perry.gabuzzi@kidder.com



**km Kidder
Mathews**